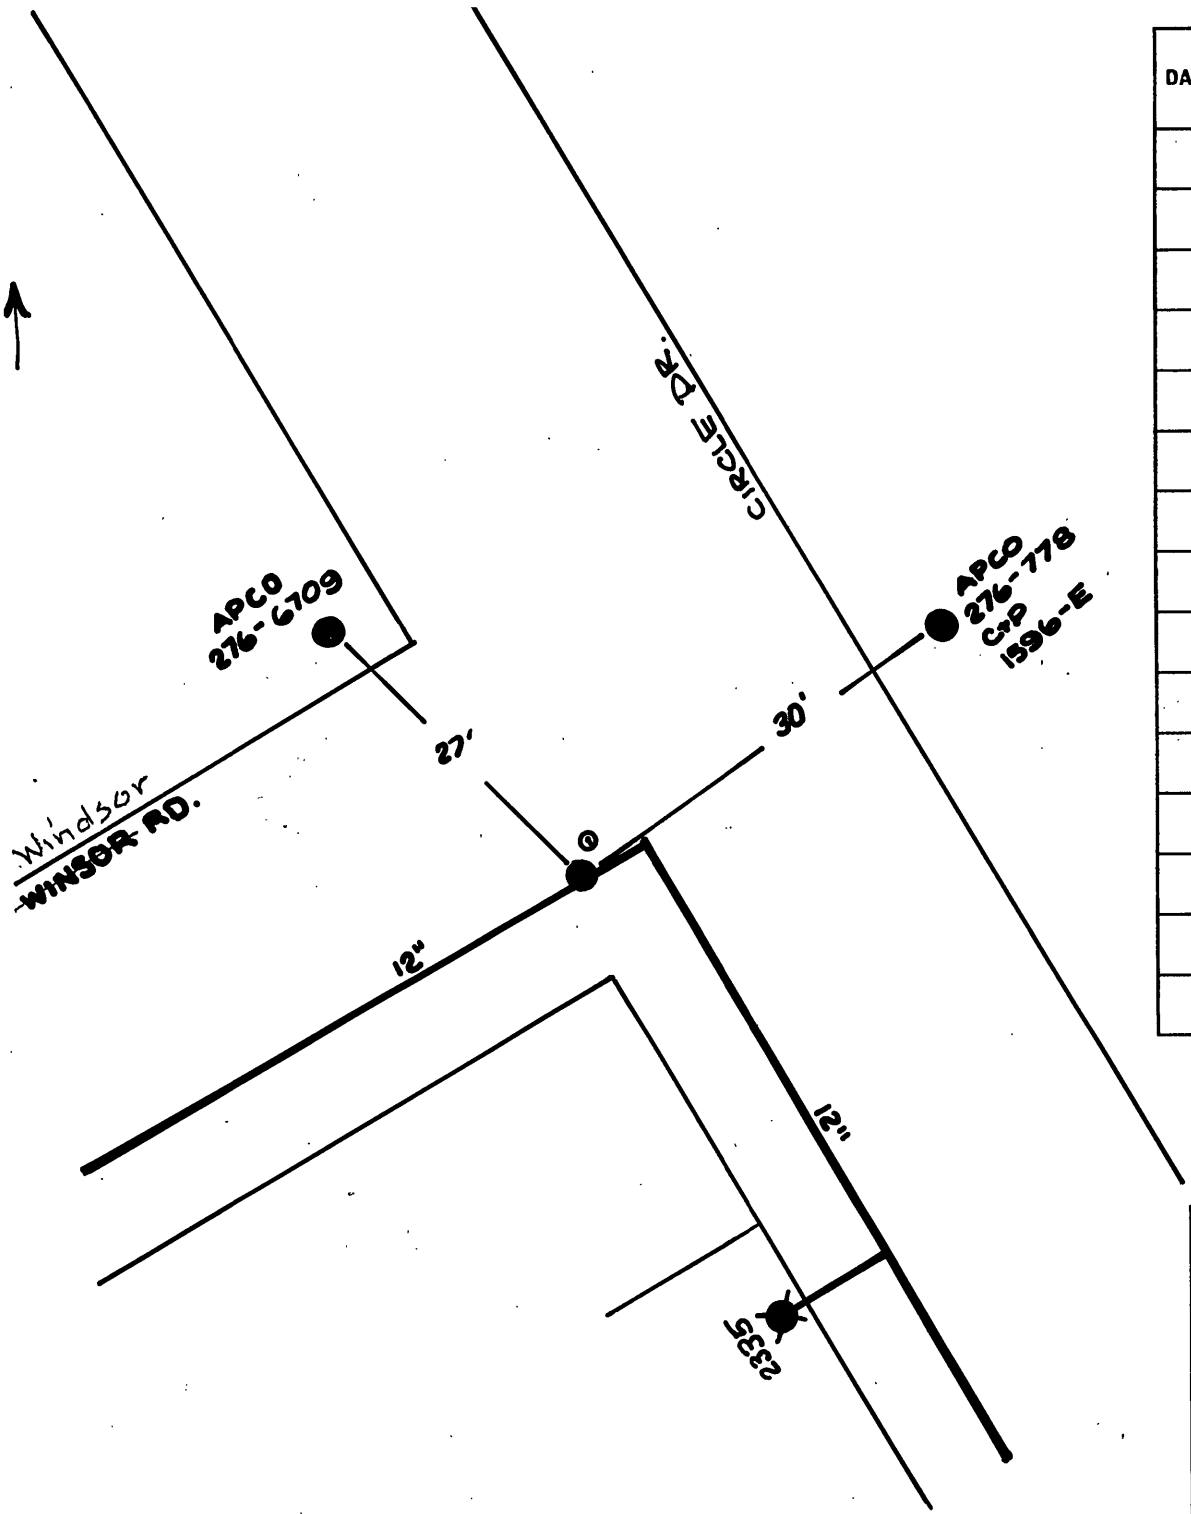

DATE	NO.	SIZE	MAKE	OPEN	TURNS
	1	12"	DARLING	R	

CITY OF ROANOKE—WATER DEP'T

VALVE DIAGRAM

CIRCLE DR AND

WINDSOR RD. SW.

SEC. MAP 501

DATE 7/14/80 PAGE NO.