748-14A

4001

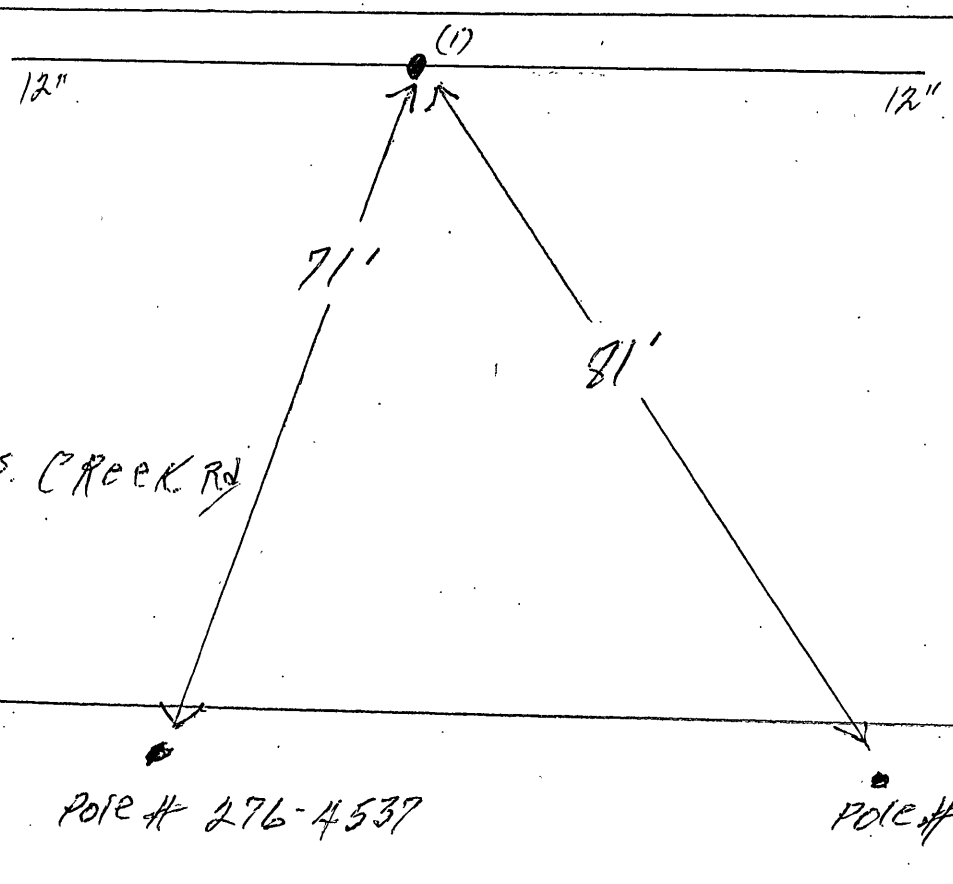

DATE	NO.	SIZE	MAKE	OPEN	TURNS
3-77	1	12	Mueller	R	

CITY OF ROANOKE—WATER DEP'T

VALVE DIAGRAM

4001 - CRAVEN'S CREEK Rd. S.W.

SEC. MAP 517 (plan # 76-12)

DATE PAGE NO.

ATTN, MR. HARLOW

J.W.M.