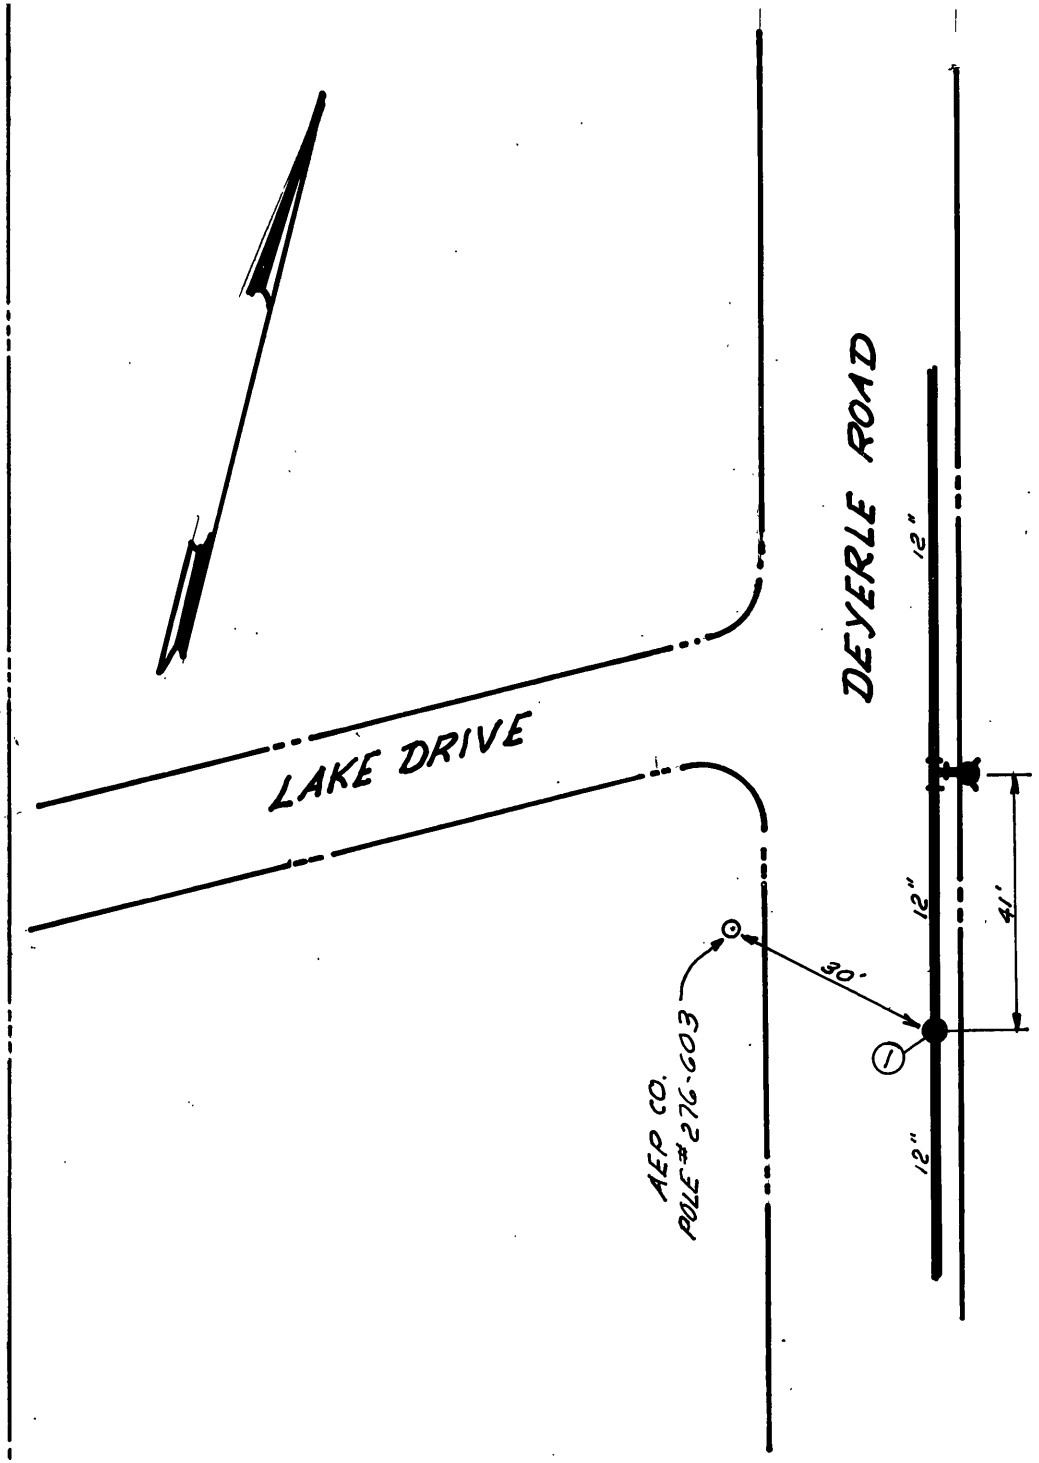

DATE	NO.	SIZE	MAKE	OPEN	TURNS
1982	1	12"	MUL.	R	39
	1	12"	28'S-PL		

CITY OF ROANOKE—WATER DEP'T
VALVE DIAGRAM
DEYERLE ROAD
AND LAKE DRIVE
S.W.
SEC. MAP 518
DATE 6-25-85 PAGE NO. 1

11/91 NP