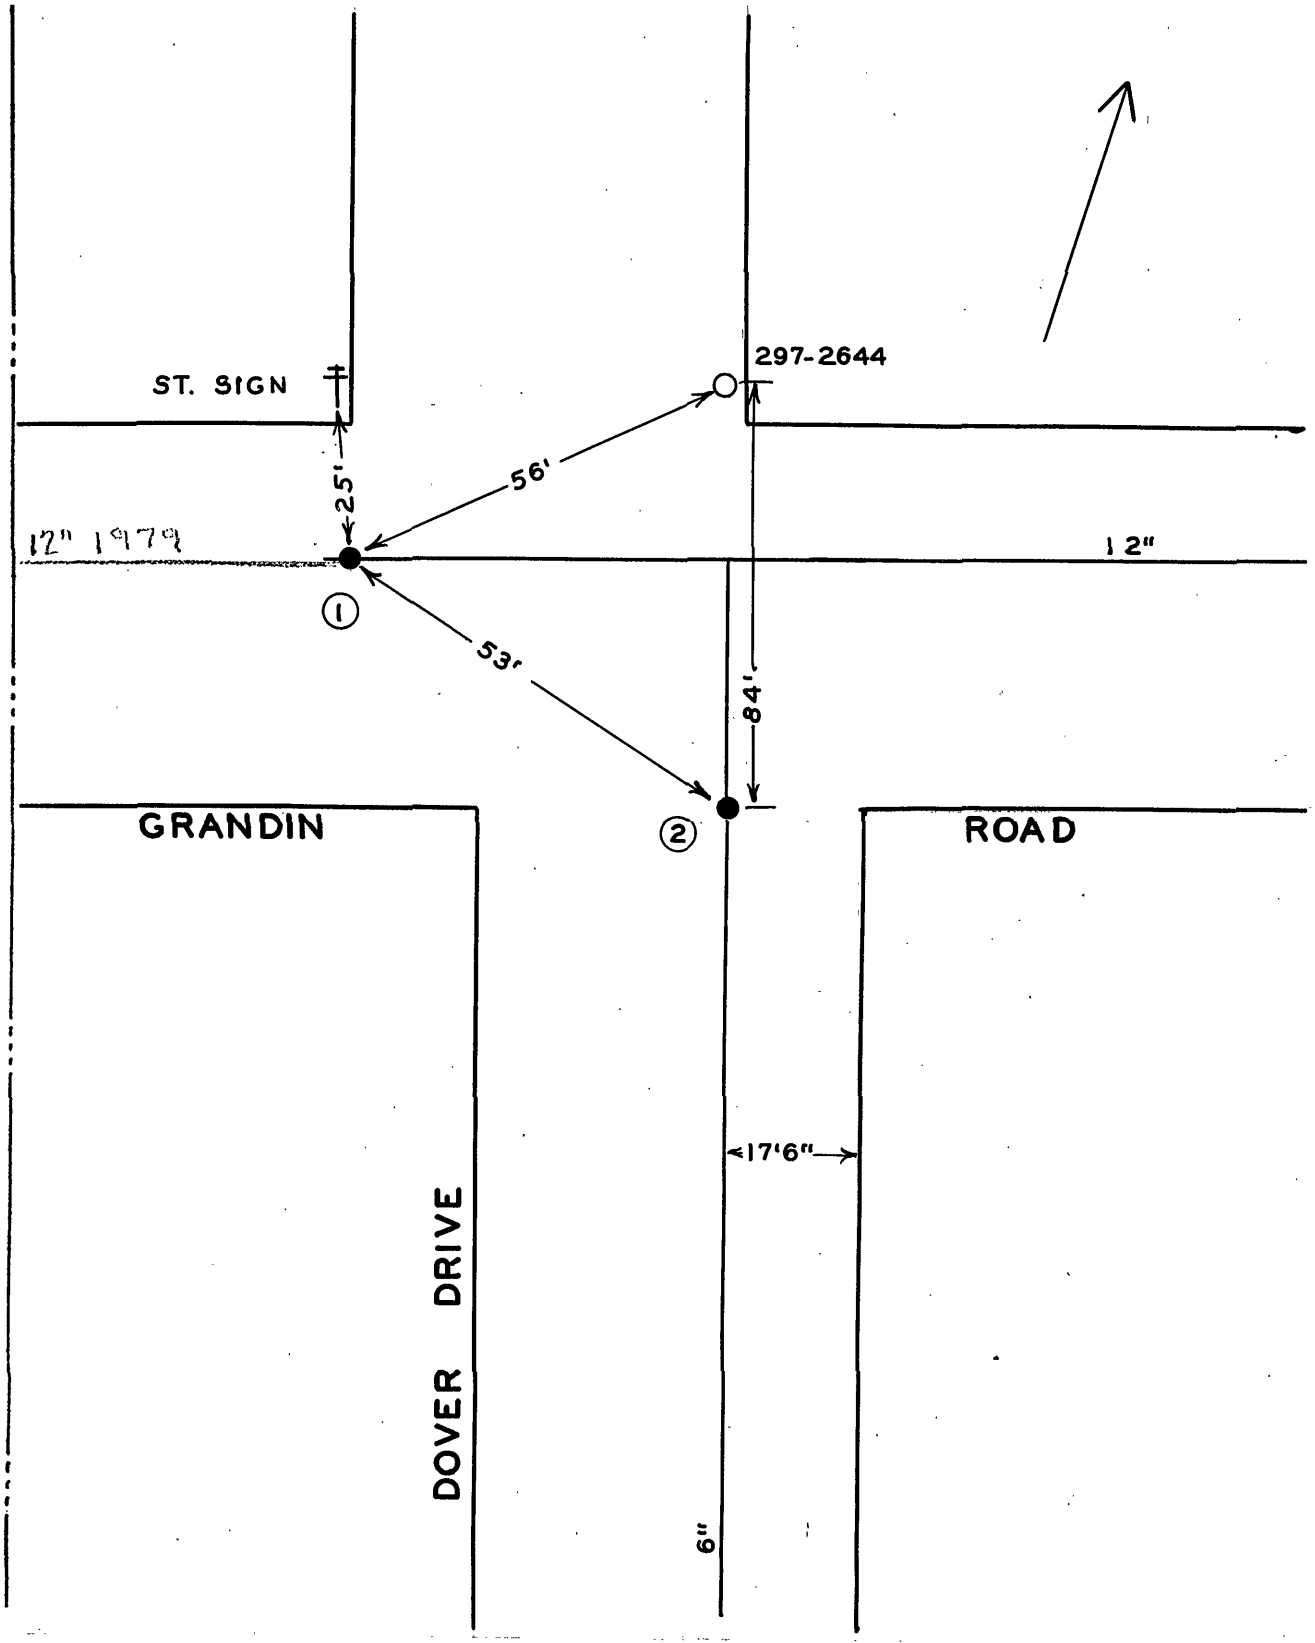

DATE	NO.	SIZE	MAKE	OPEN	TURNS
6-62	1	12"	MUELLER	R	38
6-62	2	6"	DARLING	R	21
	1	0	W.P.L.		
	2	0	S.P.L.		

CITY OF ROANOKE—WATER DEPT.

VALVE DIAGRAM

DOVER DRIVE & GRANDIN ROAD S.W.

SEC. MAP 163

DATE PAGE NO.