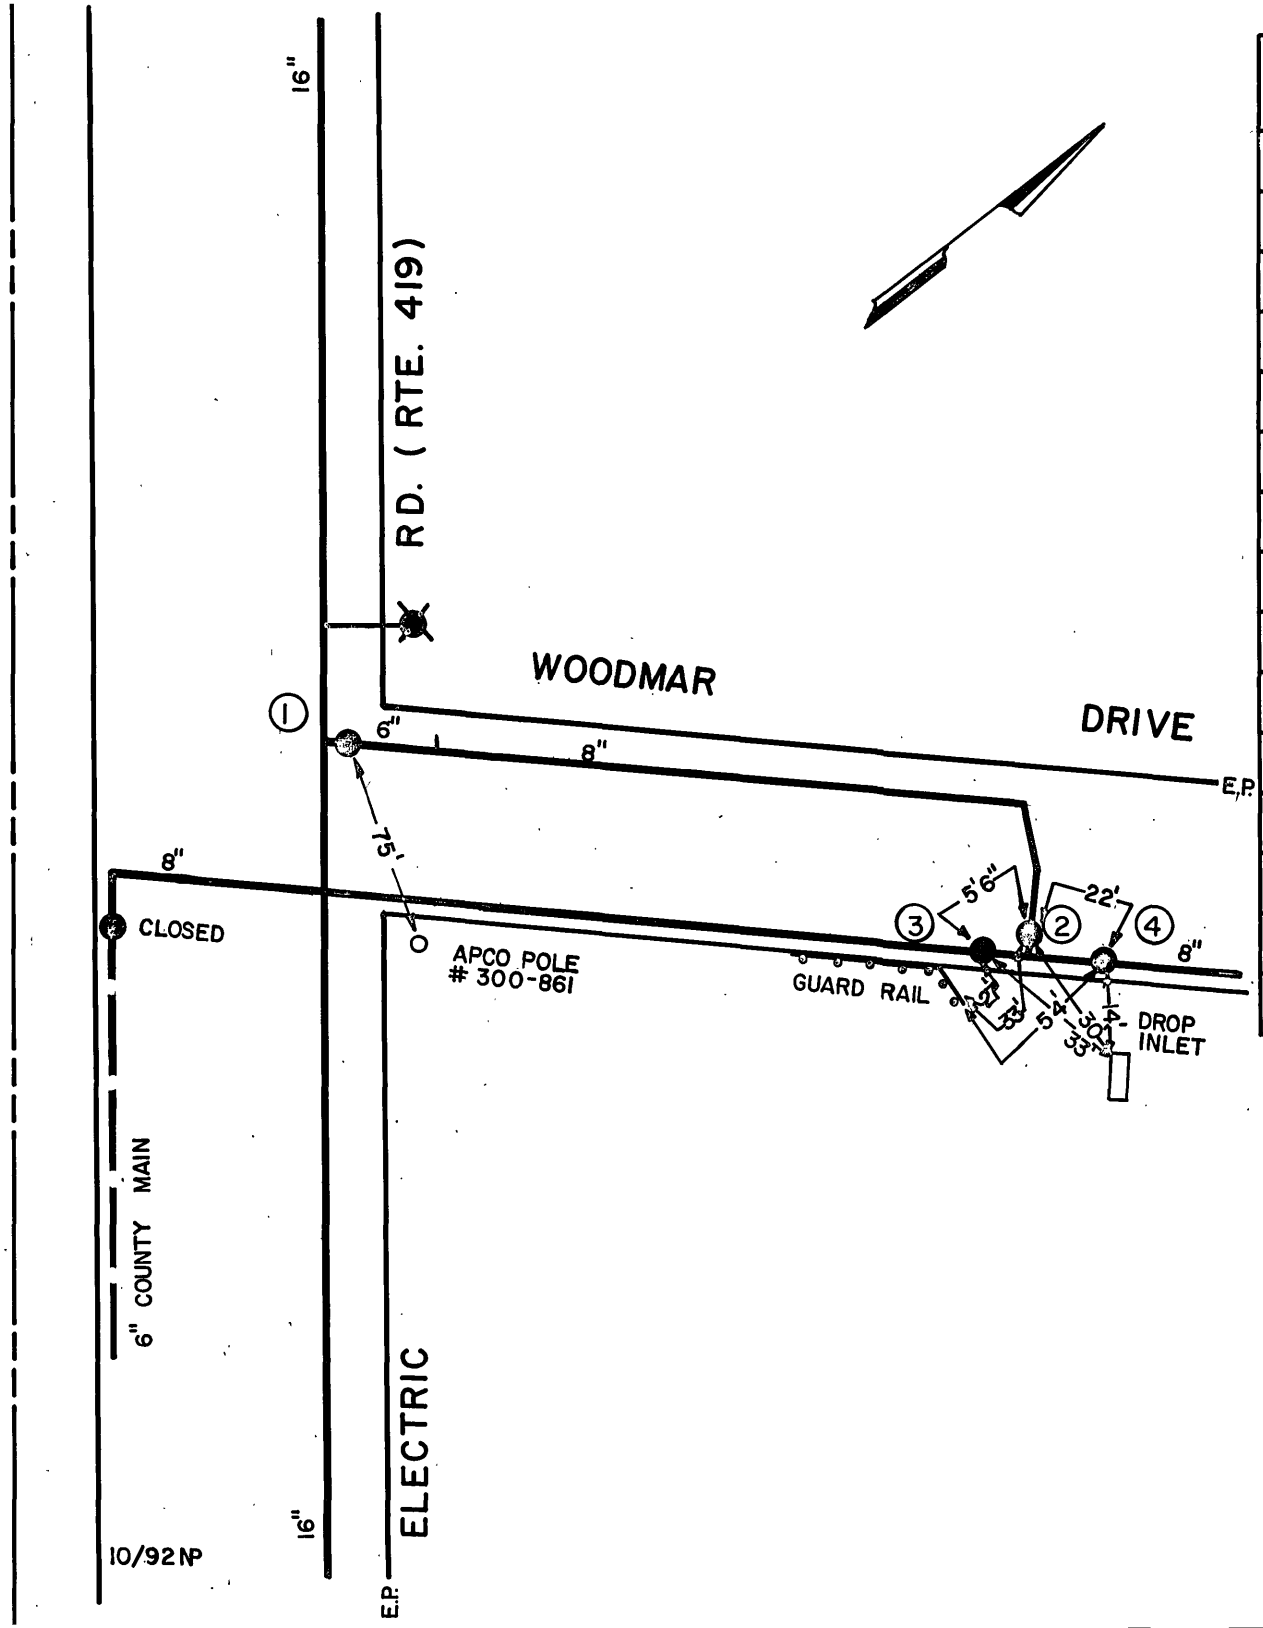

DATE	NO.	SIZE	MAKE	OPEN	TURNS
31 1981	1	6"	MUELLER	R	
1989	2	8" W/1"	MUELLER BLOW OFF	R	27
1989	3	8"	MUELLER		27
1989	4	1"	BLOW OFF		
	1	12'W	E.P.L.		

CITY OF ROANOKE - WATER DEP'T.

VALVE DIAGRAM

ELECTRIC ROAD (RTE. 419)

WOODMAR DRIVE

SEC. MAP 509 S. W.

DATE: PAGE NO.