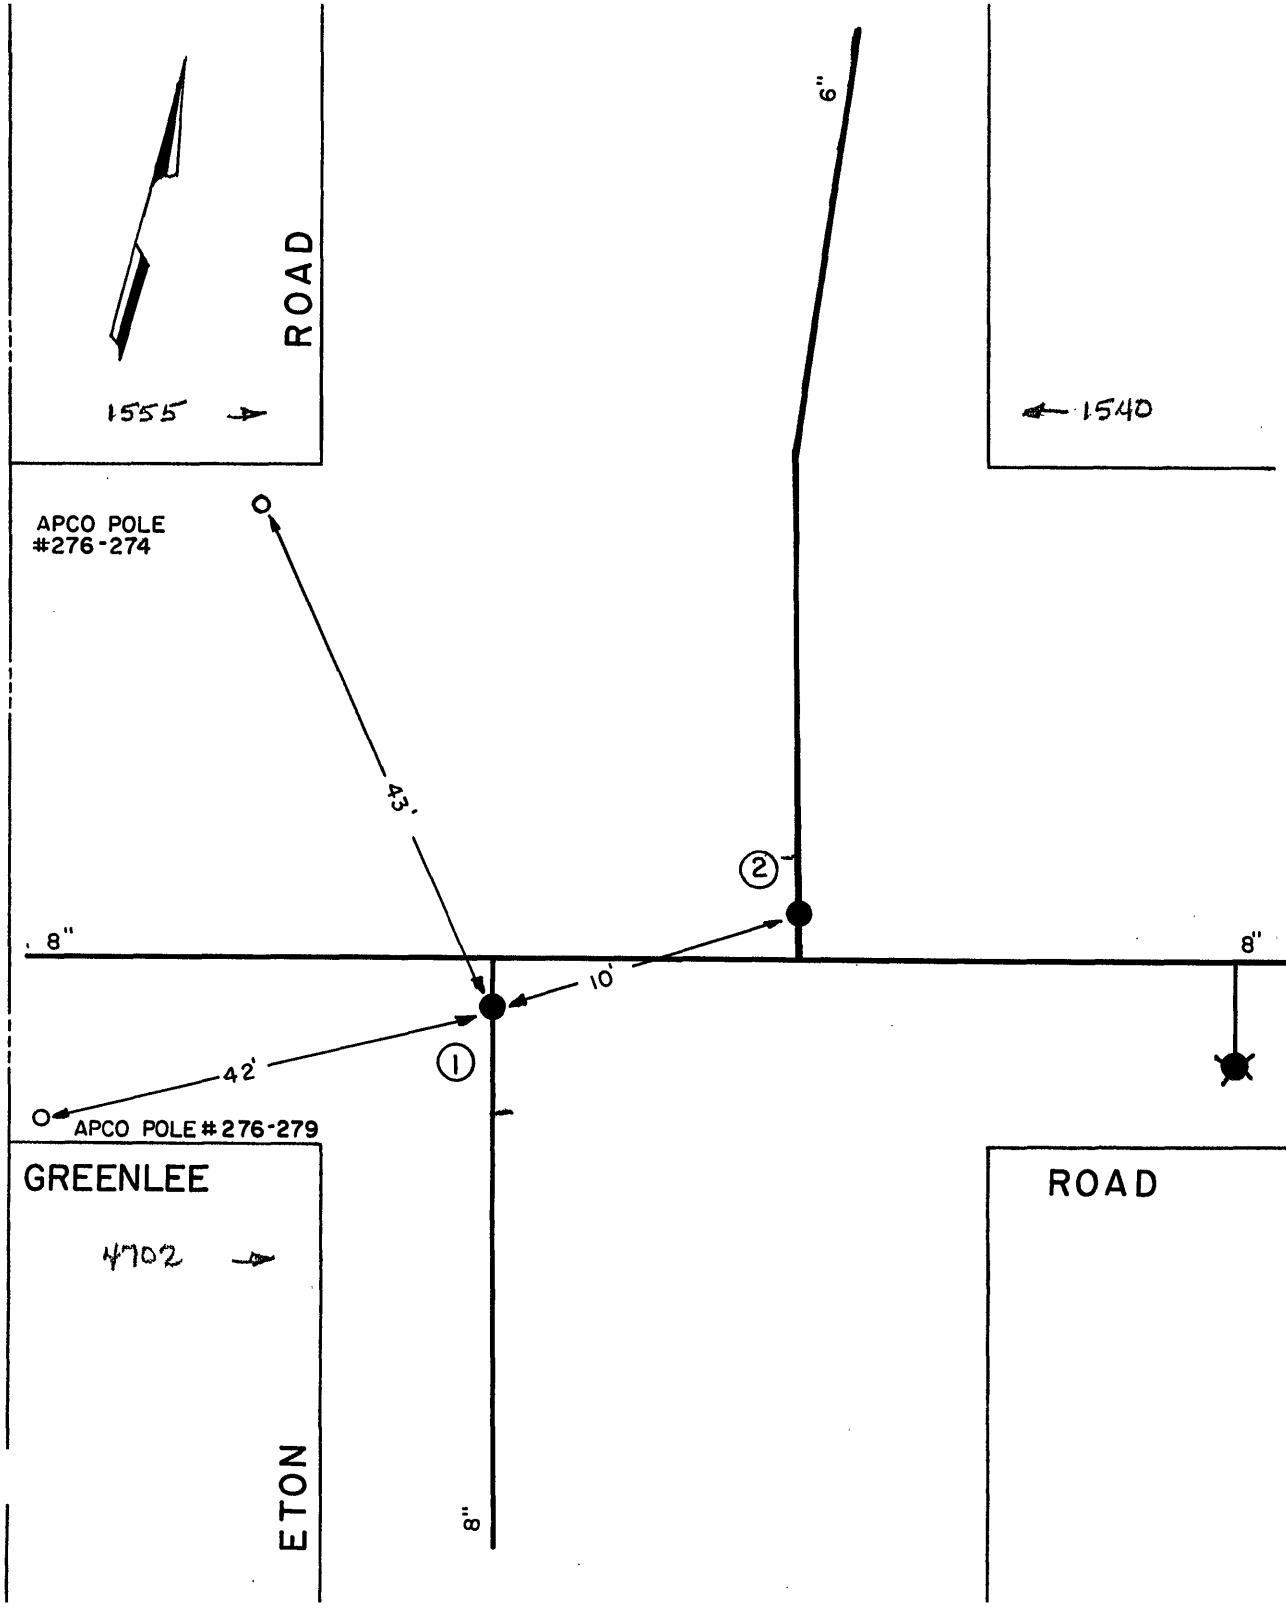


| DATE | NO. | SIZE | MAKE | OPEN | TURNS |
|---|---|---|---|---|---|
| 2-86 | 1 | 8" | MUELLER | R | 27 |
| 2-86 | 2 | 6" | MUELLER | R | 21 |
| | | | | | |
| | | | | | |
CITY OF ROANOKE—WATER DEP'T

VALVE DIAGRAM

ETON ROAD

GREENLEE ROAD

SEC. MAP 515 S.W.

DATE PAGE NO.