DATE	NO.	SIZE	MAKE	OPEN	TURNS
6-97	1	8"	Mull	R	27
6-97	2	4"	Mull	R	15

CITY OF ROANOKE—WATER DEPT
VALVE DIAGRAM

4500 Block VAN WINKLE SW

685' South of Griffin Rd

SEC. MAP 5+6

DATE 6-97 PAGE NO.

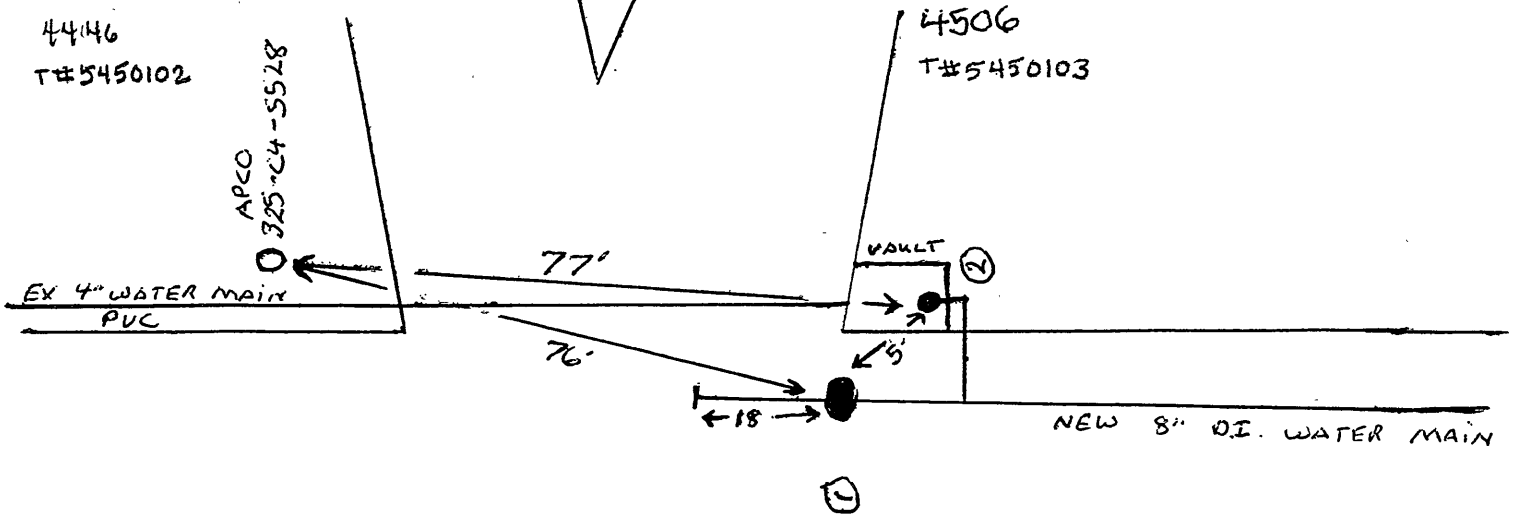

N

4500 Block VAN WINKLE SW