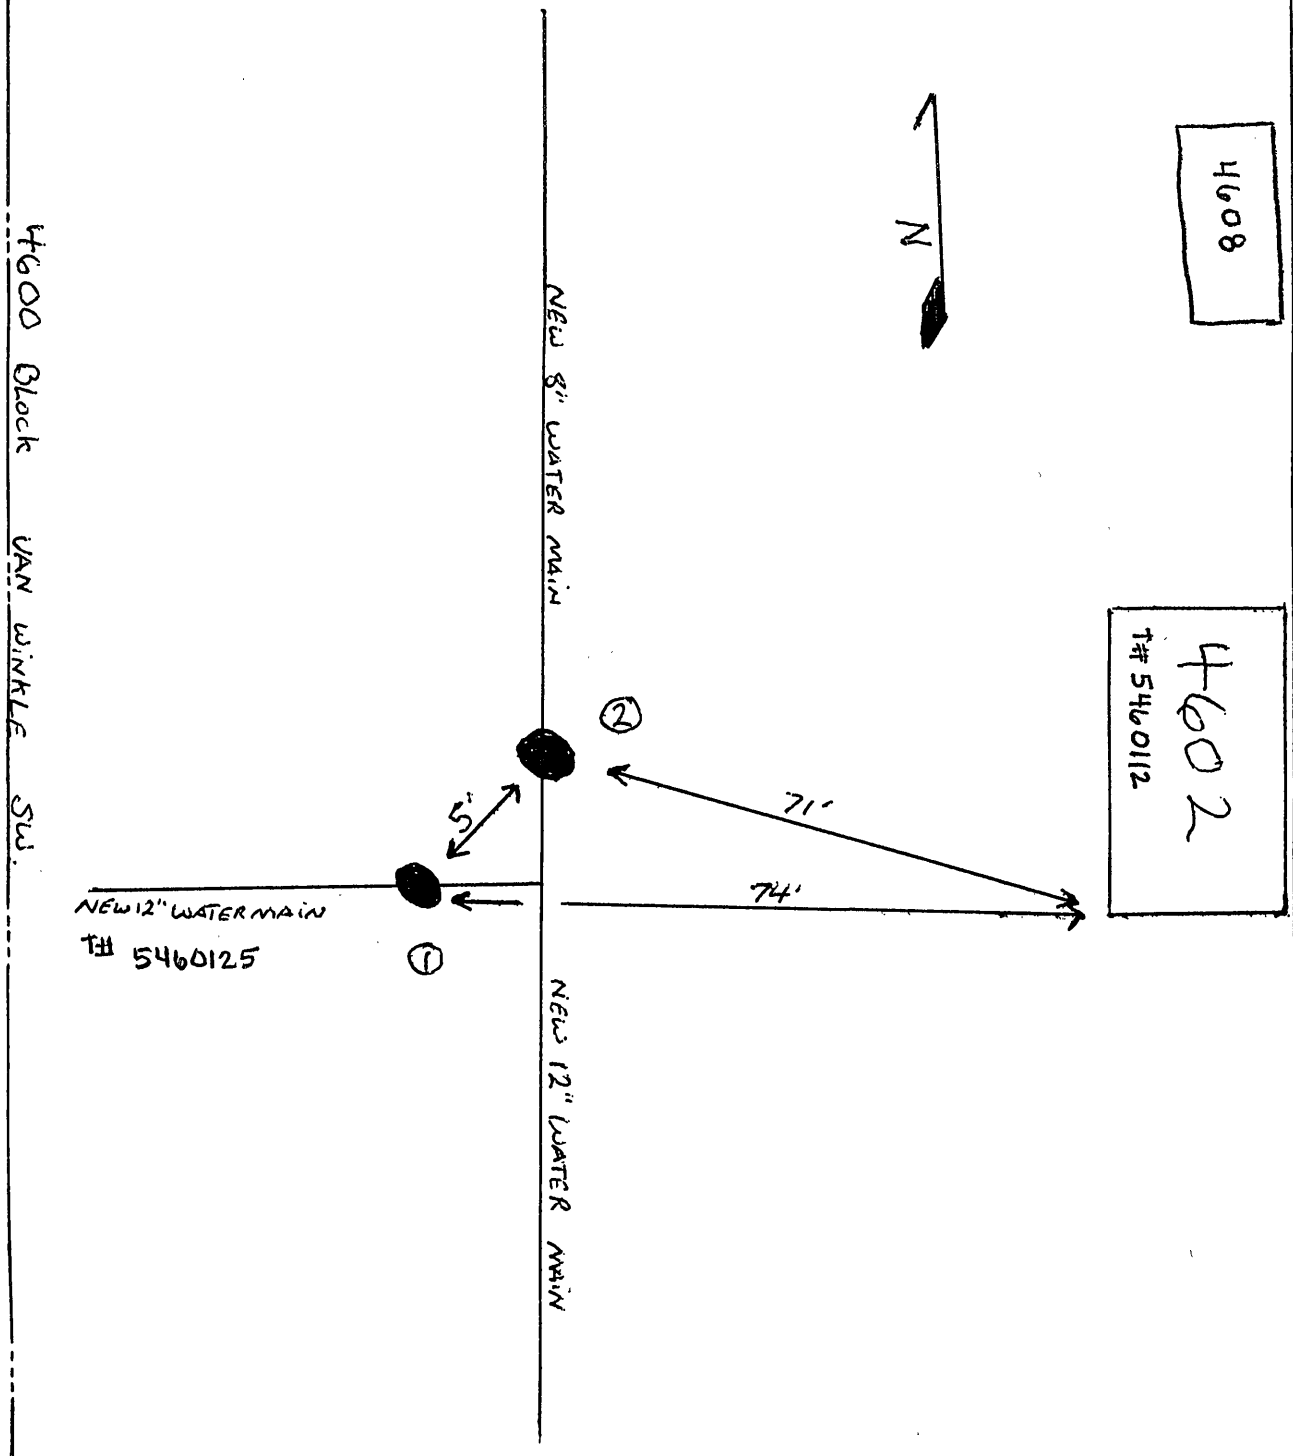

DATE	NO	SIZE	MAKE	OPEN	TURNS
6-97	1	12"	MULL	R	39
6-97	2	8"	MULL	R	27

CITY OF ROANOKE—WATER DEP'T

VALVE DIAGRAM

4600 Block VAN WINKLE SW

SEC. MAP 546

DATE 6-97 PAGE NO.