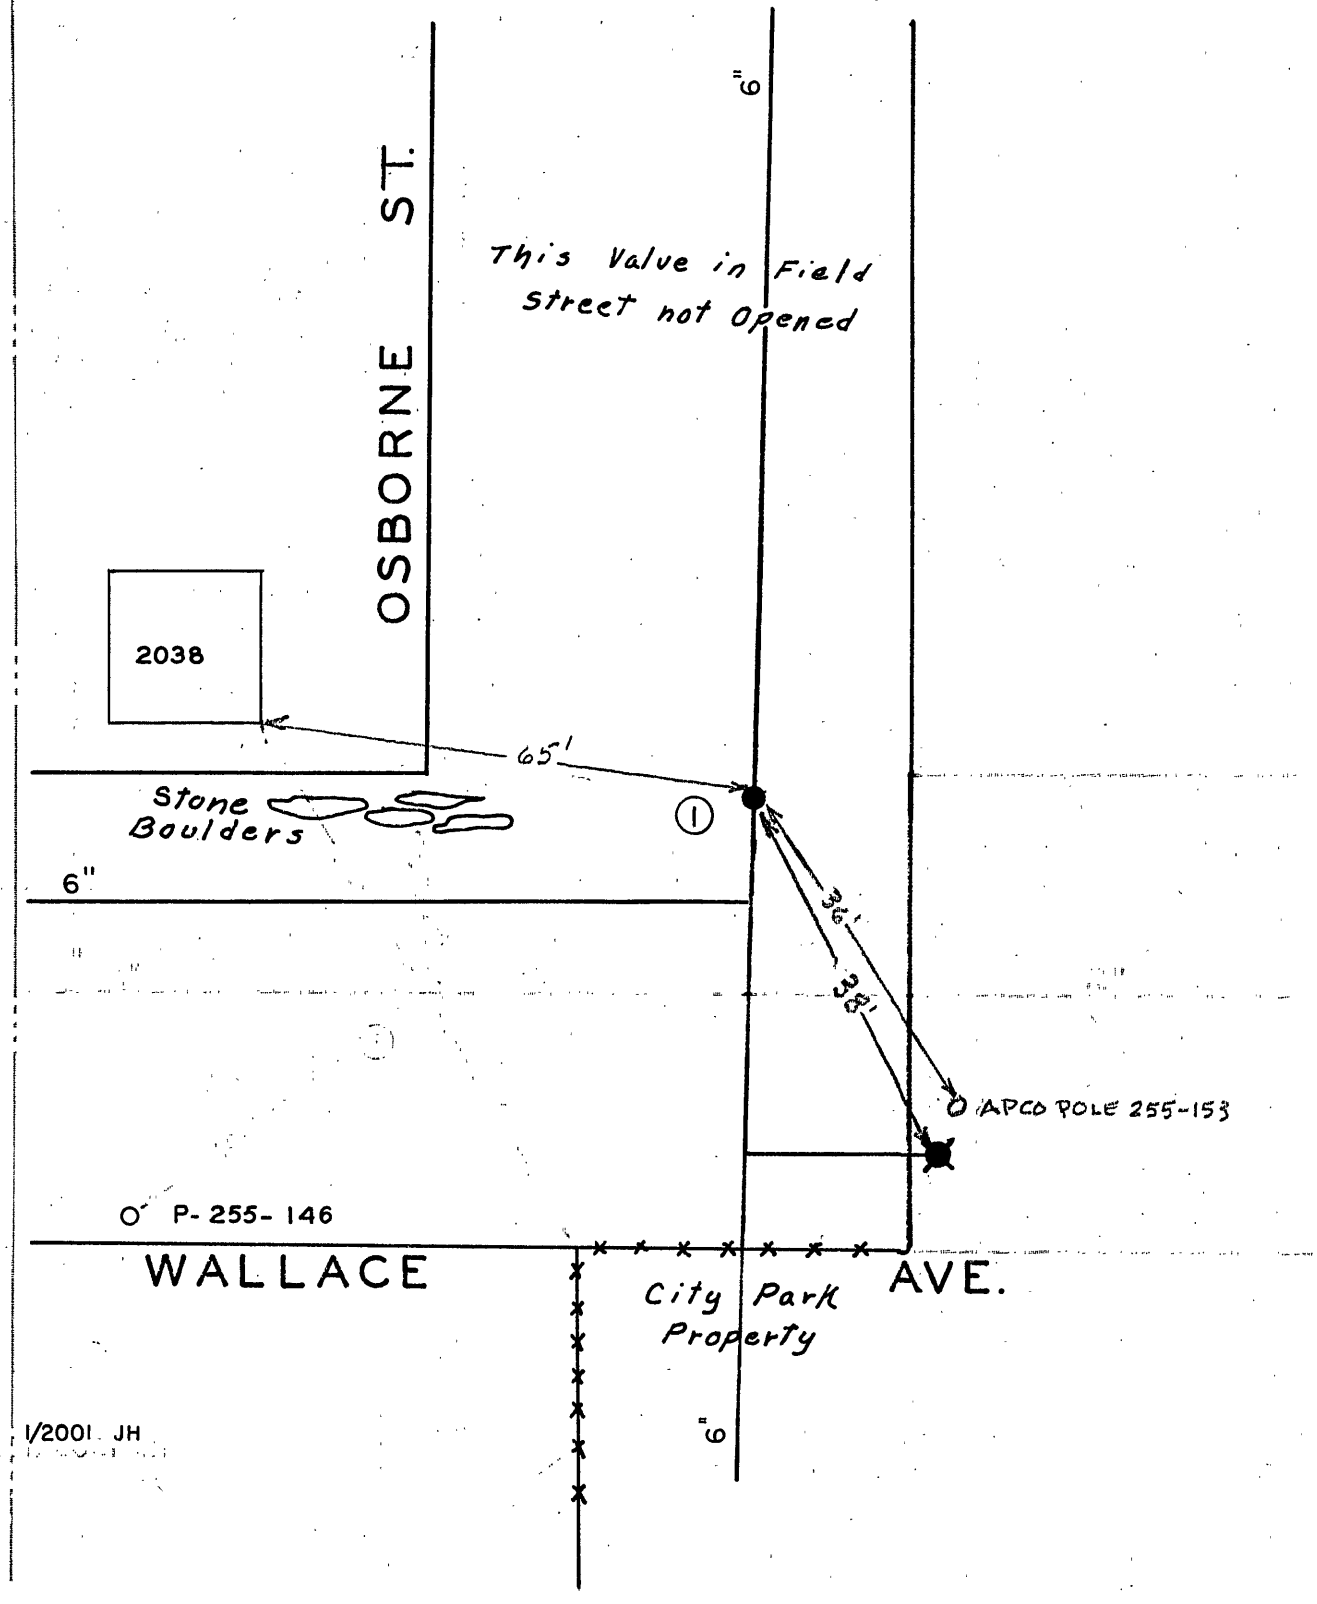

DATE	NO.	SIZE	MAKE	OPEN	TURNS
1990	1	6"	Mueller	R	21

CITY OF ROANOKE — WATER DEPT.
VALVE DIAGRAM
OSBORNE ST. & WALLACE
WALLACE AVE.

SEC. MAP 333 N.E.

DATE: PAGE NO.