MATCH LINE SHEET C1

MATCH LINE SHEET C3

TMP 4311021
HOOKER FURNITURE CORPORATION
D.B. 1479 PG. 351

TMP 4311021
HOOKER FURNITURE CORPORATION
D.B. 1479 PG. 351

NORFOLK AND WESTERN RAILWAY CO.

US SPRINT

RAILROAD ℄

10' MIN

TB 95-4

BM#16
EL=899.00

LIMIT OF CONSTRUCTION

TB 95-5

EXST SEWER AGREEMENT
DB 853 PG 90

NORFOLK AND WESTERN RAILWAY CO.

TB 95-6

S6

S7

S8

S9 JUNCTION BOX

S 42"

S 54"

54" S

8" G LOOP LINE

900

890

R O A N O K E R I V E R

WATER POLLUTION CONTROL PLANT

TINKER CREEK

NOTE:

1. SEE SHEET G3 FOR STRUCTURE INFORMATION.

PLAN
SCALE: 1"=30'

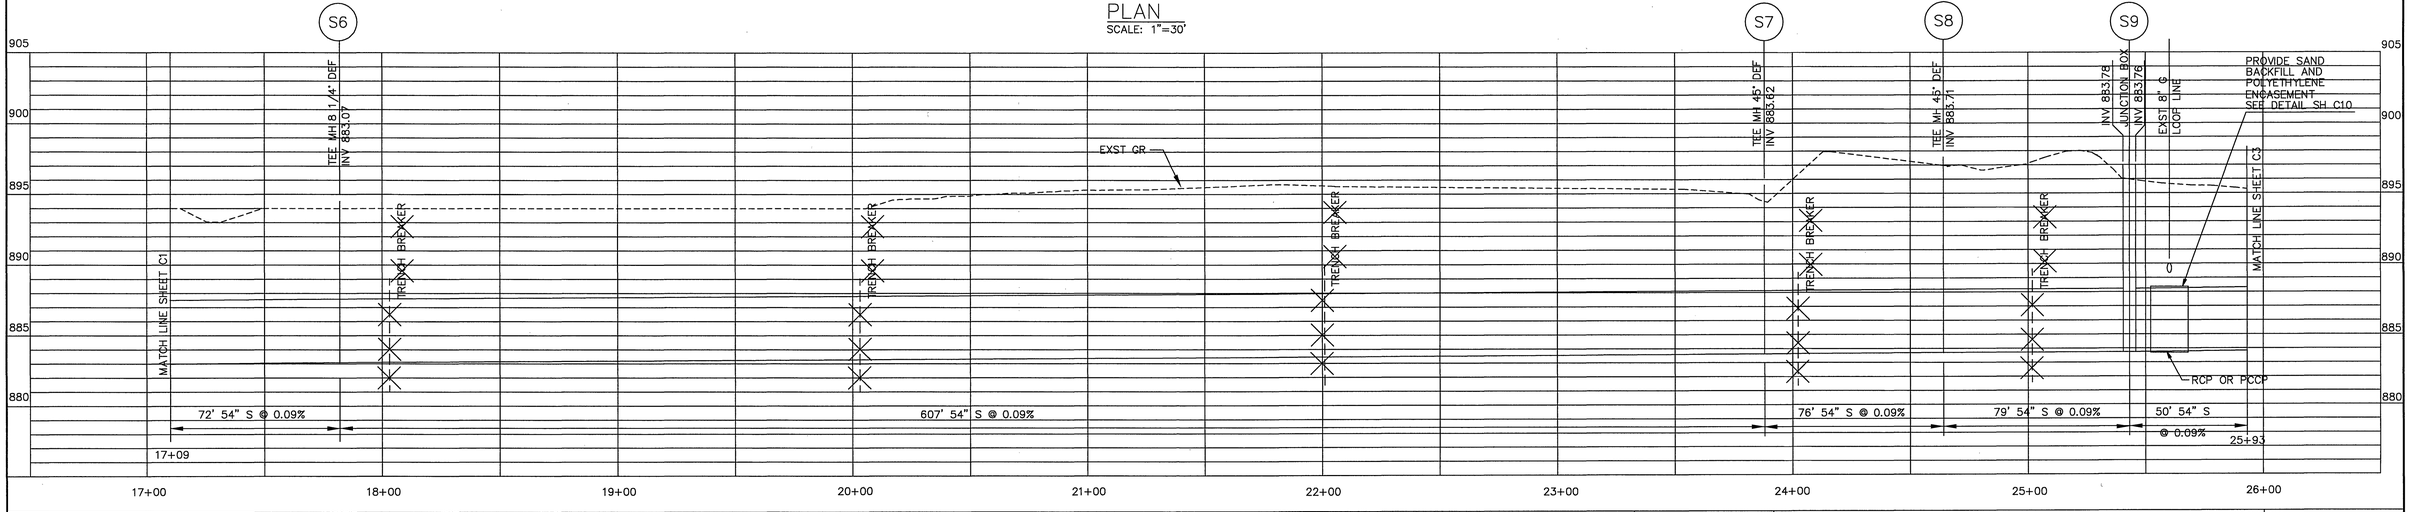

HAYES, SEAY, MATTERN & MATTERN, INC.
ARCHITECTS/ENGINEERS/PLANNERS
ROANOKE, VIRGINIA

DESIGNED: DMH
DRAWN: MHL
CHECKED:
APPROVED:

REVISIONS		
DATE	BY	DESCRIPTION
10/15/98	MNH	RECORD DRAWINGS SEE SHEET G1 FOR NOTE

GRAPHIC SCALES
VERTICAL 1" = 5' (5' 0 5' 10')
HORIZONTAL 1" = 30' (30' 15' 0 30' 60')

TINKER CREEK INTERCEPTOR SEWER
CITY OF ROANOKE, VIRGINIA

PLAN AND PROFILE
STA 17+09 TO STA 25+93

COMM. NO.: 7211 | SCALE: AS NOTED | DATE: MAY 17, 1996

PROJECT NO.: 6317
CONTRACT A
SHEET NO.
C2
RECORD DRAWINGS

7211C2A C7211 25 AUG 98 REV. E ACAD MNH PLOT SCALE: 1=30 XREF: 0'