

ABBREVIATIONS

(SEE SHEET 3)

LEGEND

(SEE SHEET 3)

John A. Williams


SUMMARY OF QUANTITIES

ITEM

UNIT

QUANTITY
ACTUAL PROPOSAL

ITEM	UNIT	ACTUAL	PROPOSAL
MOBILIZATION	L.S.	1	1
72" STORM DRAIN	L.F.	1153	1269
60" STORM DRAIN	L.F.	4015	4417
54" STORM DRAIN	L.F.	426	469
21" STORM DRAIN	L.F.	354	389
18" STORM DRAIN	L.F.	1269	1396
16" STORM DRAIN	L.F.	50	55
15" STORM DRAIN	L.F.	2870	3157
14" STORM DRAIN	L.F.	50	55
3'X5' PRECAST BOX STORM DRAIN	L.F.	67	74
4'X5' PRECAST BOX STORM DRAIN	L.F.	575	633
JUNCTION BOX BASE-LESS THAN 95 SQUARE FEET	EA.	4	5
JUNCTION BOX BASE-95 TO 120 SQUARE FEET	EA.	9	10
JUNCTION BOX BASE-MORE THAN 120 SQUARE FEET	EA.	6	7
MANHOLE TEE BASE	EA.	2	2
4' DIAMETER BASE	EA.	13	14
4' DIAMETER RISER (SD)	V.F.	158	174
INLET-DI 1	EA.	2	2
INLET-DOUBLE DI 1	EA.	1	1
INLET-DI 1-R	EA.	1	1
INLET-DI 3A	EA.	13	14
INLET-DI 3B-4'	EA.	6	7
INLET-DI 3B-6'	EA.	2	2
INLET-DI 3B-12'	EA.	2	2
INLET-DI 3B-16'	EA.	1	1
INLET-DI 3B-20'	EA.	4	4
INLET-DI 3C-6'	EA.	3	3
INLET-DI 3C-8'	EA.	3	3
INLET-DI 3C-18'	EA.	1	1
STORM DRAIN MANHOLE FRAME AND COVER	EA.	33	36
DI-1-R-FRAME AND COVER ONLY	EA.	1	1
16" SANITARY SEWER	L.F.	4062	4469
14" SANITARY SEWER	L.F.	2131	2344
12" SANITARY SEWER	L.F.	23	25
10" SANITARY SEWER	L.F.	25	28
8" SANITARY SEWER	L.F.	1632	1795
6" SANITARY SEWER	L.F.	266	293
SANITARY SEWER MANHOLES	V.F.	452	497
8" SANITARY SEWER DROP CONNECTION	V.F.	78	86
10" SANITARY SEWER DROP CONNECTION	V.F.	4	4
SANITARY SEWER MANHOLE FRAME AND COVER (STD)	EA.	25	28
SANITARY SEWER MANHOLE FRAME AND COVER (WATER TIGHT)	EA.	9	10
6" WATER LINE	L.F.	1253	1378
6" WATER VALVES	EA.	4	5
AGGREGATE BASE MATERIAL	TN	3432	3775
BITUMINUS CONCRETE BASE MATERIAL	TN	2317	2549
BITUMINUS CONCRETE SURFACE MATERIAL	TN	2520	2772
SURFACE TREATMENT PAVEMENT	SY	368	405
CONCRETE CURB AND GUTTER	L.F.	7192	7911
CONCRETE SIDEWALK	SY	1284	1357
CONCRETE ENTRANCES	SY	1253	1378
TRENCH STABILIZATION MATERIAL	TN	2690	2959
ROCK	CY	14463	15909
GRAVEL SURFACE REPLACEMENT	TN	474	521
SELECT BACKFILL MATERIAL	CY	4995	5495
MISC. REINFORCED CONCRETE-NOT FORMED	CY	150	165
SANITARY SEWER LATERAL	L.F.	1176	1294

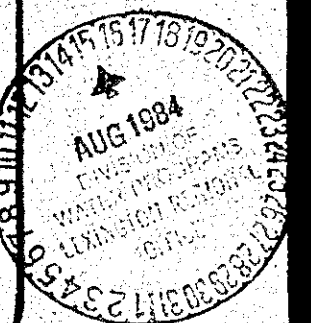

PROJECT NUMBER 5825-1

SHEET NUMBER 2 OF 41