EXIST. HOUSE COLLECTOR

SEE SH 19 FOR ADDITION SEWER

MATCH LINE STA. 11+00 SH. 10

CONN. EXST. SAN. LAT. TO NEW 8" SAN.

(ABANDON)
San. MH.
Top 1007.29
6" Invt. In 999.44
8" Invt. In 999.59
Invt. Out 999.59

(FOR SANITARY PROFILE SEE SHEET 54)

SAN. MH. #116
STA. 11+21.5,
8' RT. ℄ B

REMOVE EXST. ENTR., CURB AND GUTTER, REPLACE WITH NEW

MH. #15
STA. 14+70.5,
12' RT. ℄ B

D.I. #17
STA. 14+81 ℄ B
B. F. GOODRICH

SAN. MH. #117
STA. 14+97,
8' RT. ℄ B
PAVED LOT

E.O.L. STA. 16+07.96 ℄ B

PROVIDE AGGREGATE BASE TO TRANSITION DRIVE FROM WALK TO YARD (TYP.)

REMOVE EXST. PVMT. AND REPLACE WITH NEW PVMT. TO NEW GRADES

NEW ENTR.

NEW WALK

NEW 5' WALK

NEW CG-6

NEW PVMT.

EXST. MH. #118

PLUG

PLUG (REMOVE)

LIMIT OF REGRADE & OVERLAY

SET TOP OF ENTR. TO PICK UP SWALE

REMOVE EXST. GRATE AND CONC., REPLACE WITH BIT. PVMT.

REMOVE INLET AND PIPE

REPLACE CONC. ENTR.

D.I. #16
STA. 14+81 ℄ B
D.I.
Top 985.44
Invt. Out 984.64
BERGLUND CHEVROLET
AMC/TRUCKS

(CAP)
Drainage Well No. 113
Top 987.16
(Full Of Water)

San. MH.
Top 986.33
6" Invt. In 978.73
8" Invt. In 978.53
12" Invt. In 978.33
12" Invt. Out 978.23

San. MH.
Top 985.85

NOTE: 1. CONNECT SEWER LATERALS IN CLOVER AVE. TO NEW 8" SEWER. CITY WILL PROVIDE TV LOG OF EXST. SEWER.

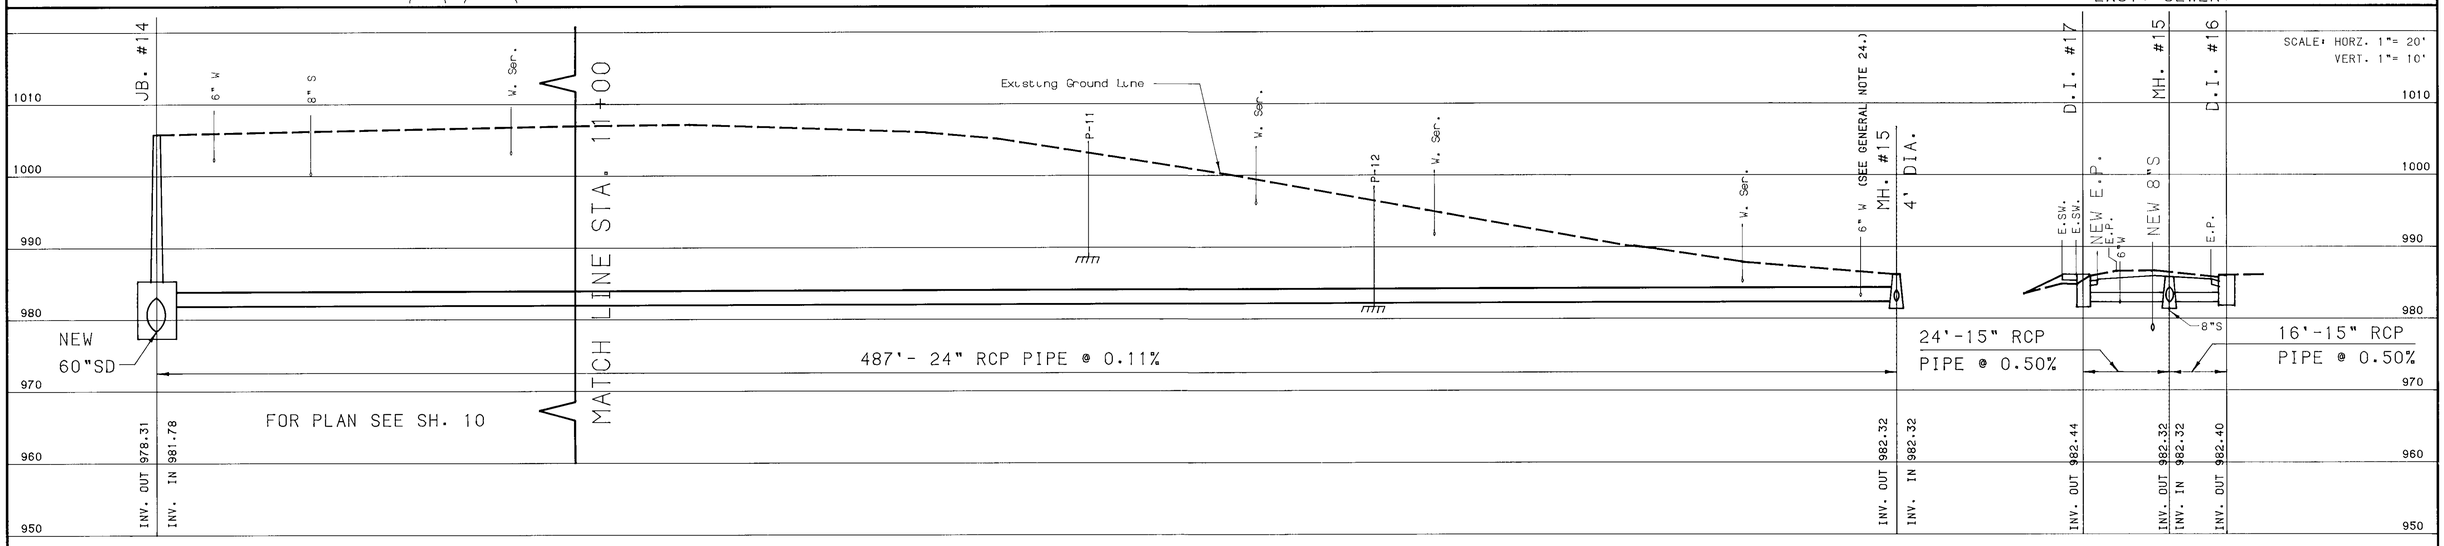

Mattern & Craig
CONSULTING ENGINEERS - SURVEYORS
701 FIRST STREET, ROANOKE, VIRGINIA 24016, (703) 345-9342

DESIGNED: ARB/SWH
CHECKED: SHM
APPROVED:

COMMONWEALTH OF VIRGINIA
STEWART W. HUBBELL
No. 07420
PROFESSIONAL ENGINEER

NORTH

REVISION	DATE	DESCRIPTION	BY	APP.
1	DEC. 89	RECORD DRAWING	JLJ	SWH

DATE
JULY 1987
COMM.
580/581

WILLIAMSON ROAD STORM DRAIN- PHASE 2
CONTRACT II-A
ROANOKE, VIRGINIA

PLAN AND PROFILE

SHEET 18

PLAN NO. 5826