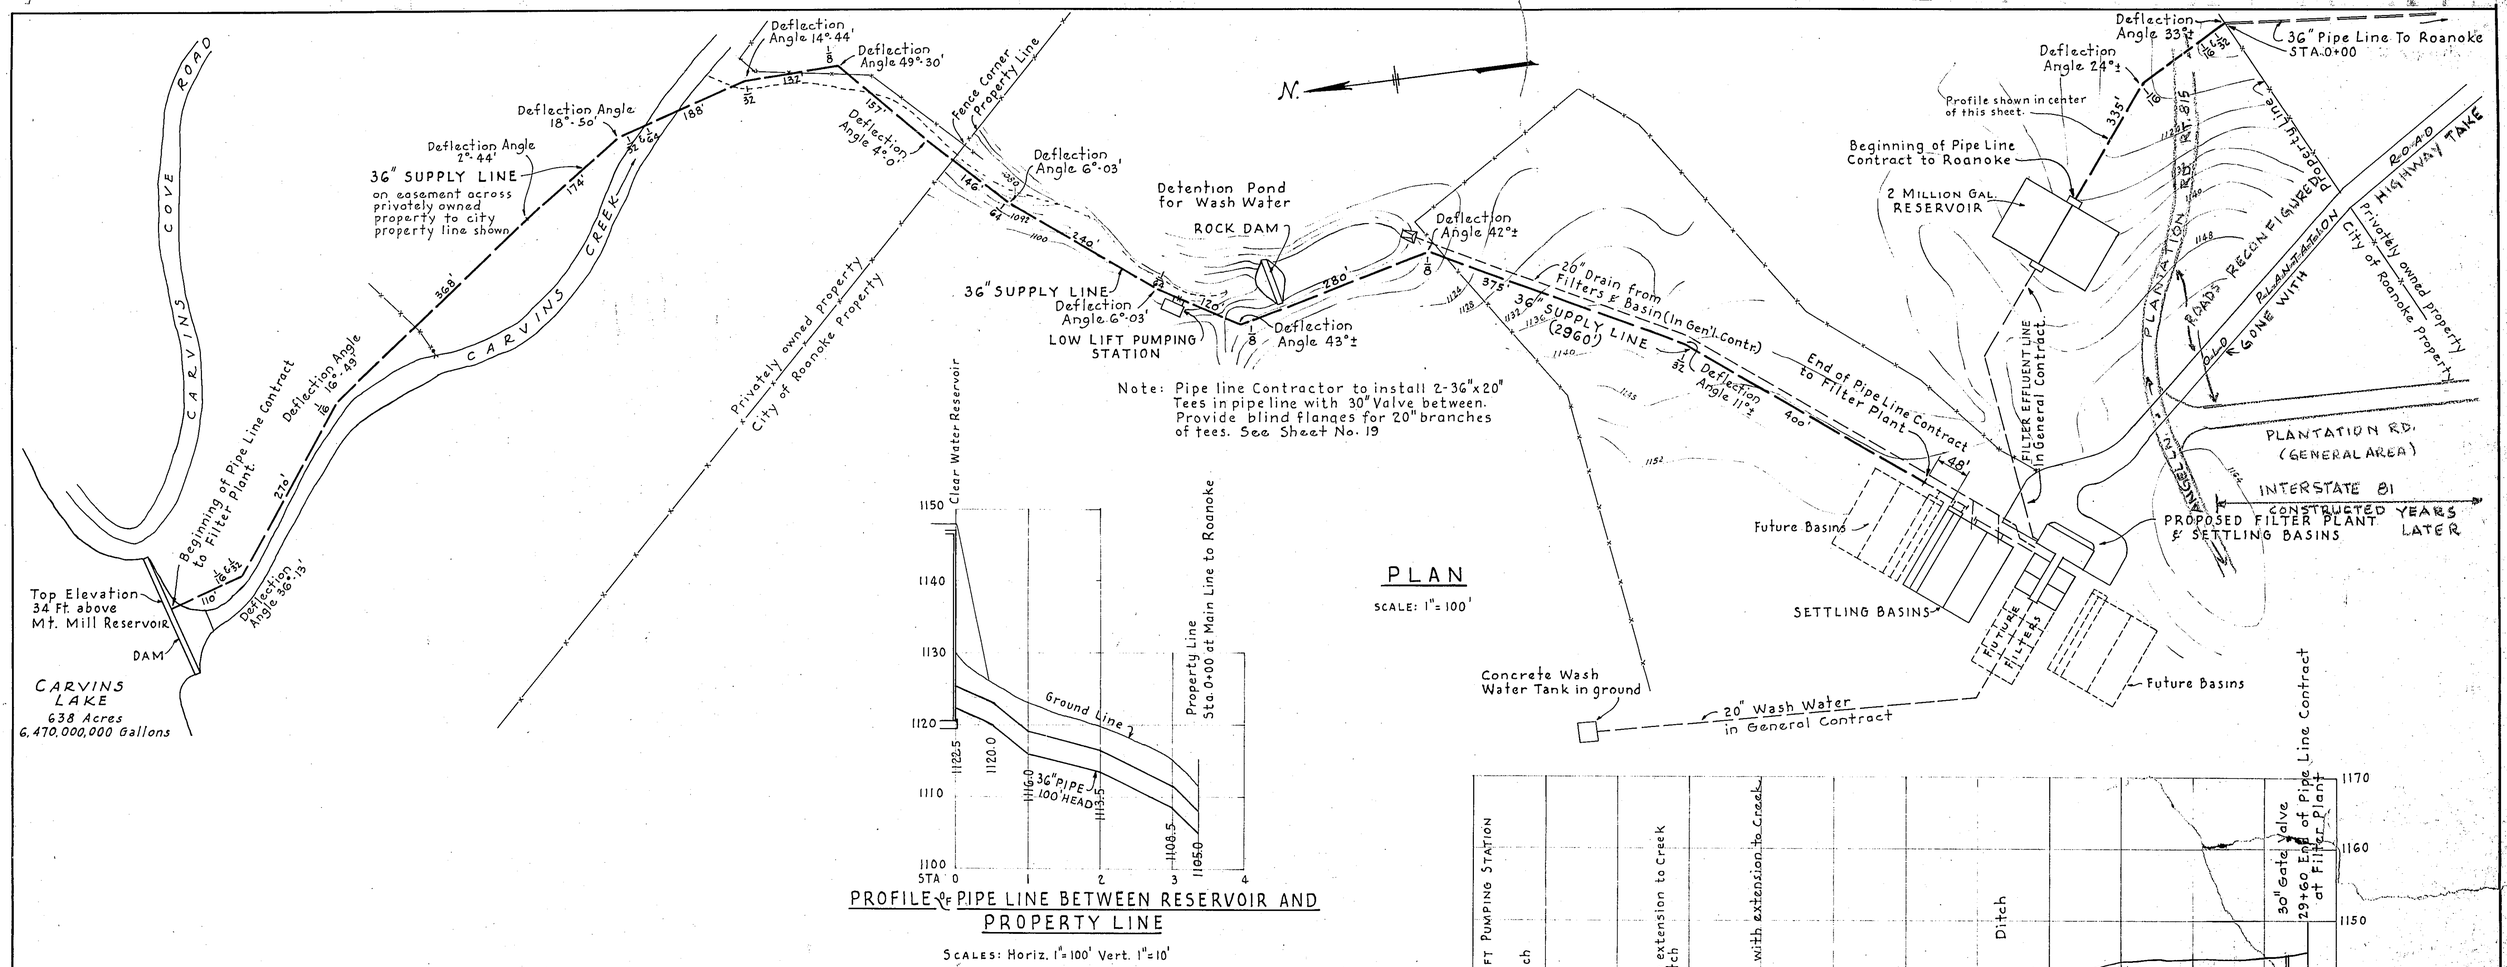

PLAN

SCALE: 1" = 100'

PROFILE OF PIPE LINE BETWEEN RESERVOIR AND PROPERTY LINE

SCALES: Horiz. 1" = 100' Vert. 1" = 10'

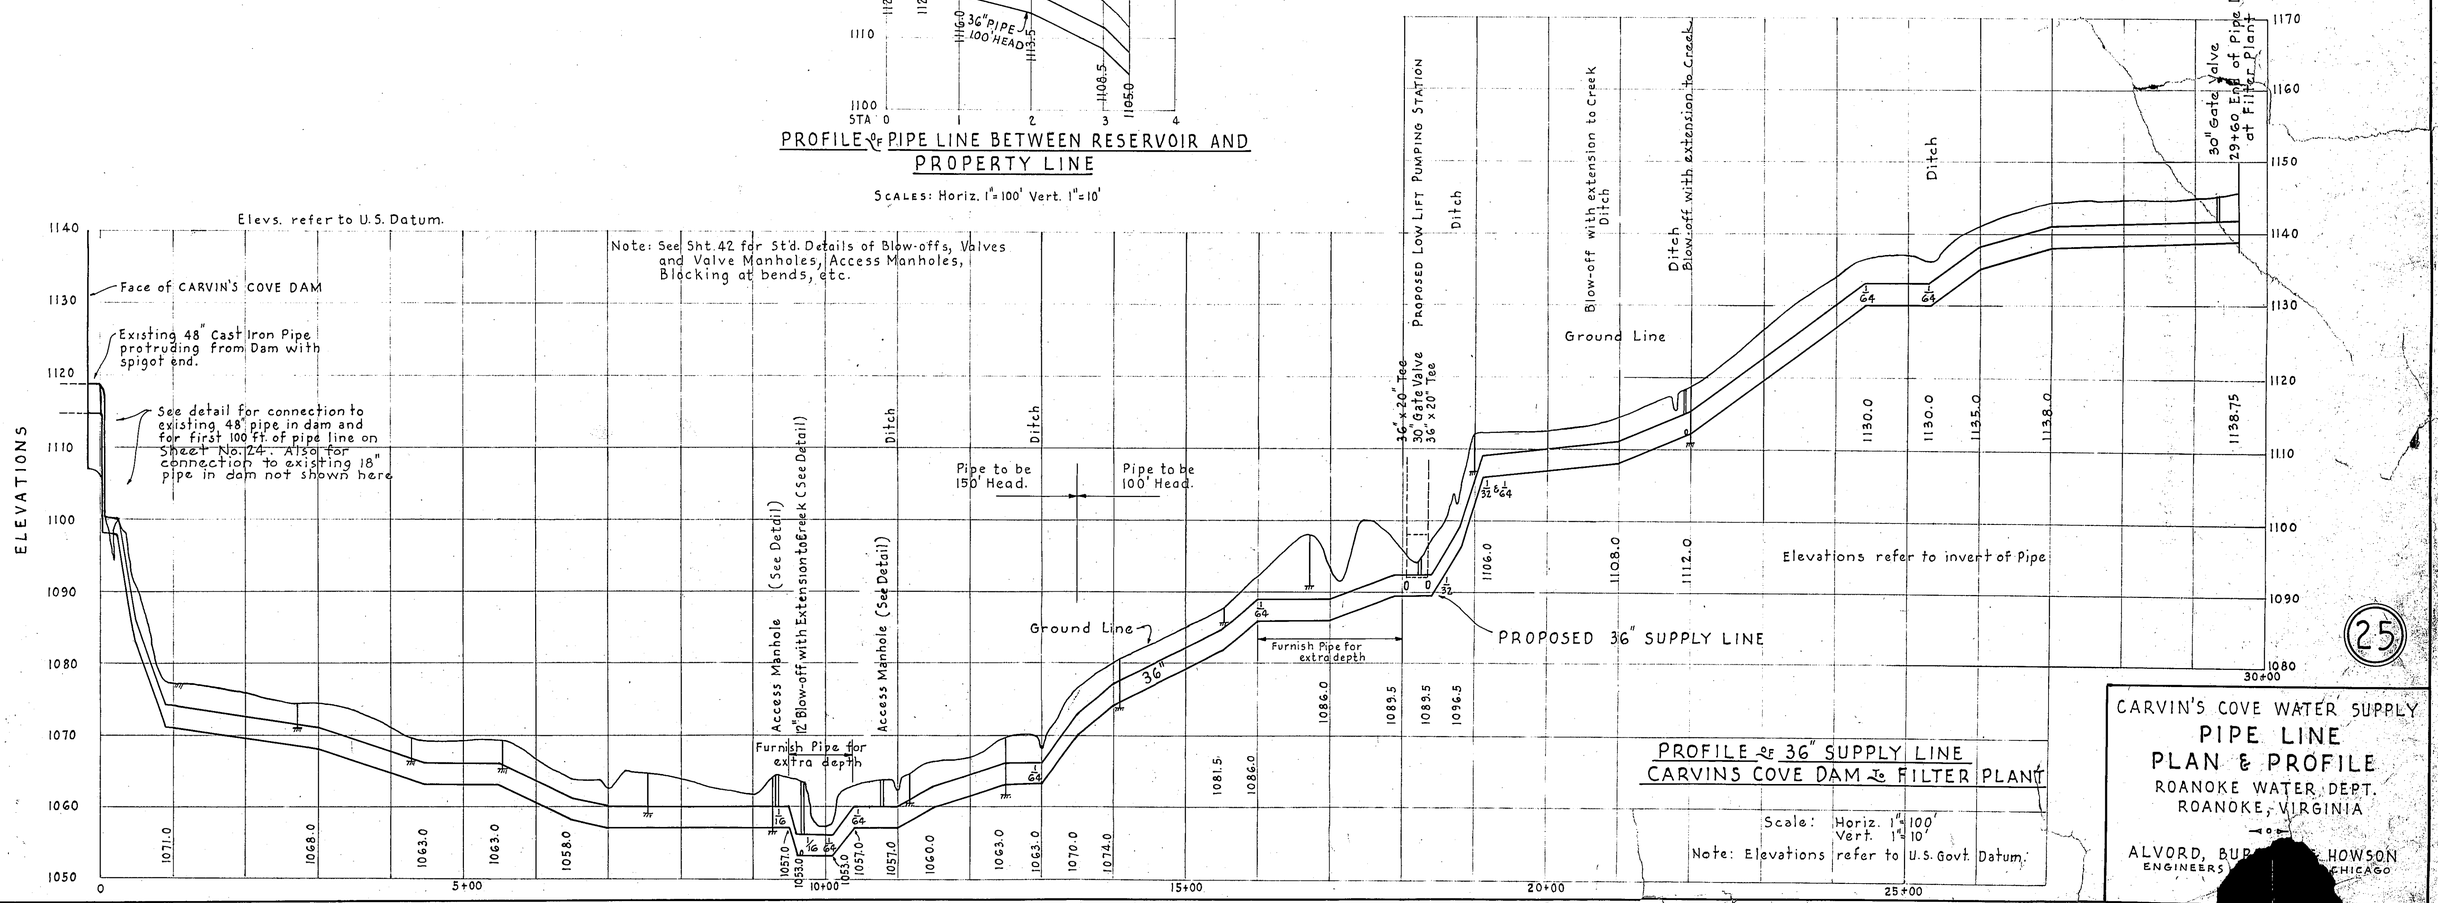

PROFILE OF 36" SUPPLY LINE CARVINS COVE DAM TO FILTER PLANT

Scale: Horiz. 1" = 100' Vert. 1" = 10'

Note: Elevations refer to U.S. Govt. Datum.

CARVIN'S COVE WATER SUPPLY
PIPE LINE
PLAN & PROFILE
ROANOKE WATER DEPT.
ROANOKE, VIRGINIA

ALVORD, BURDICK & HOWSON
ENGINEERS CHICAGO

25