
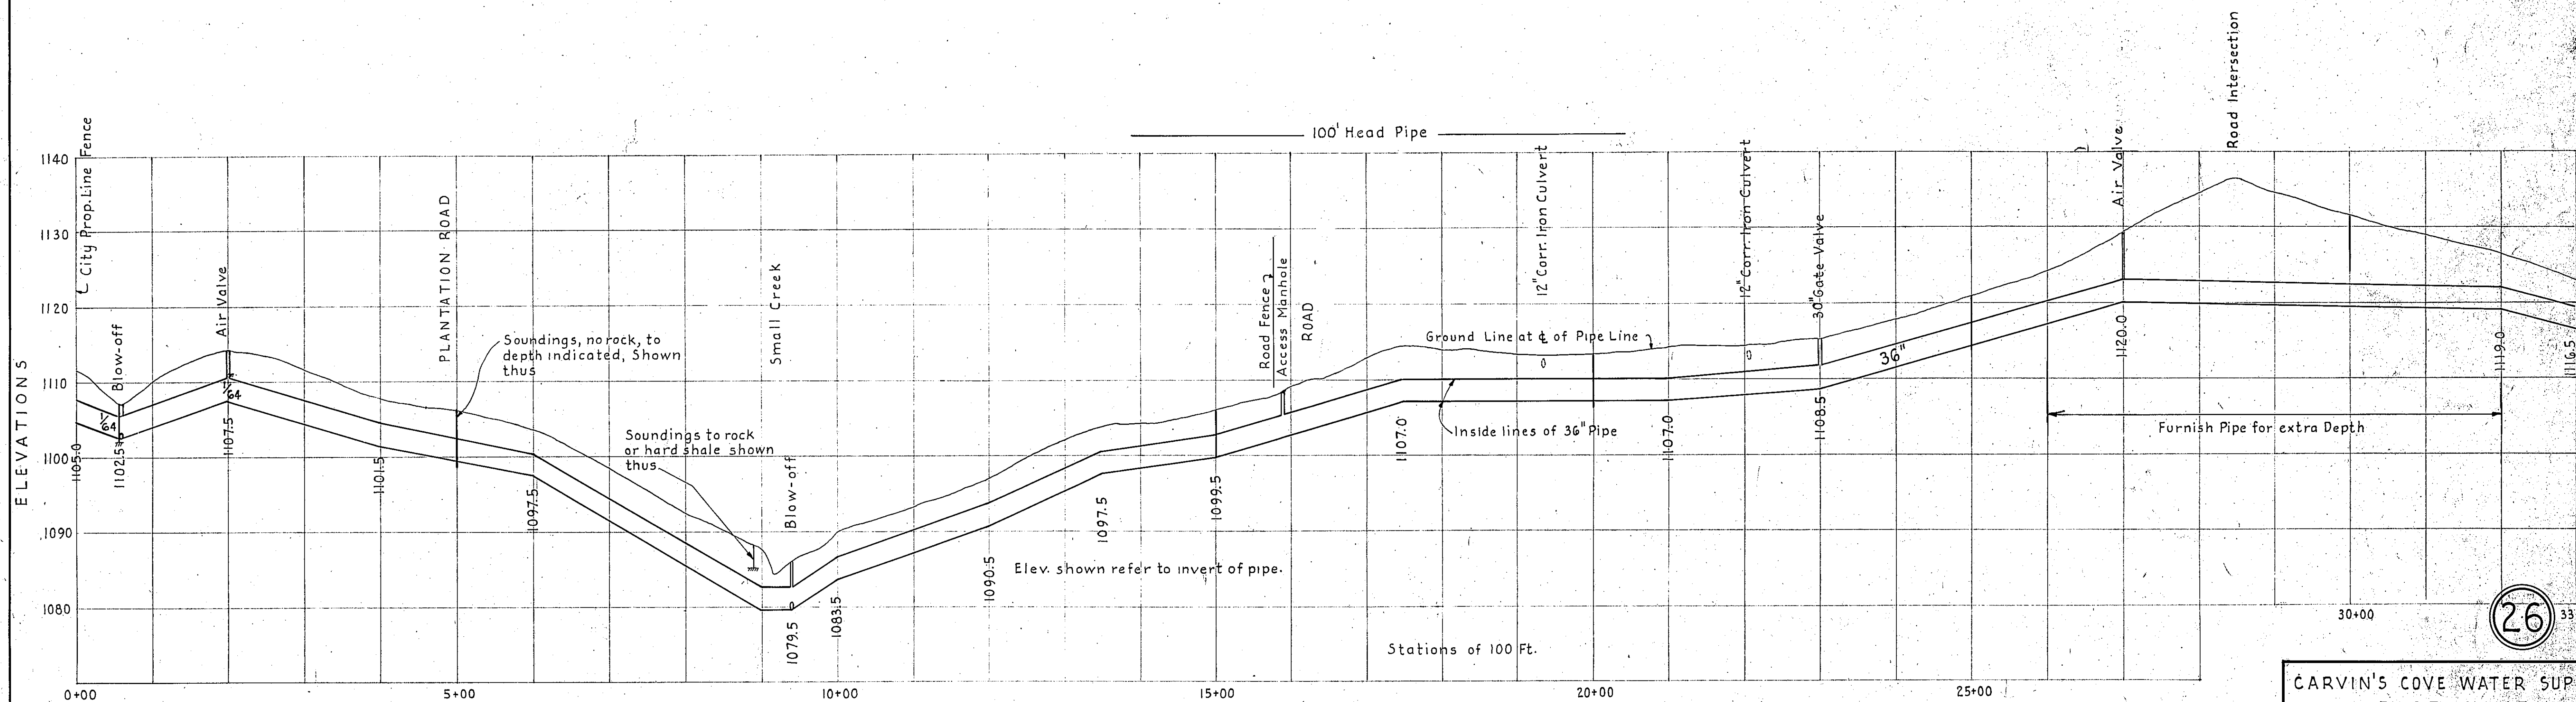


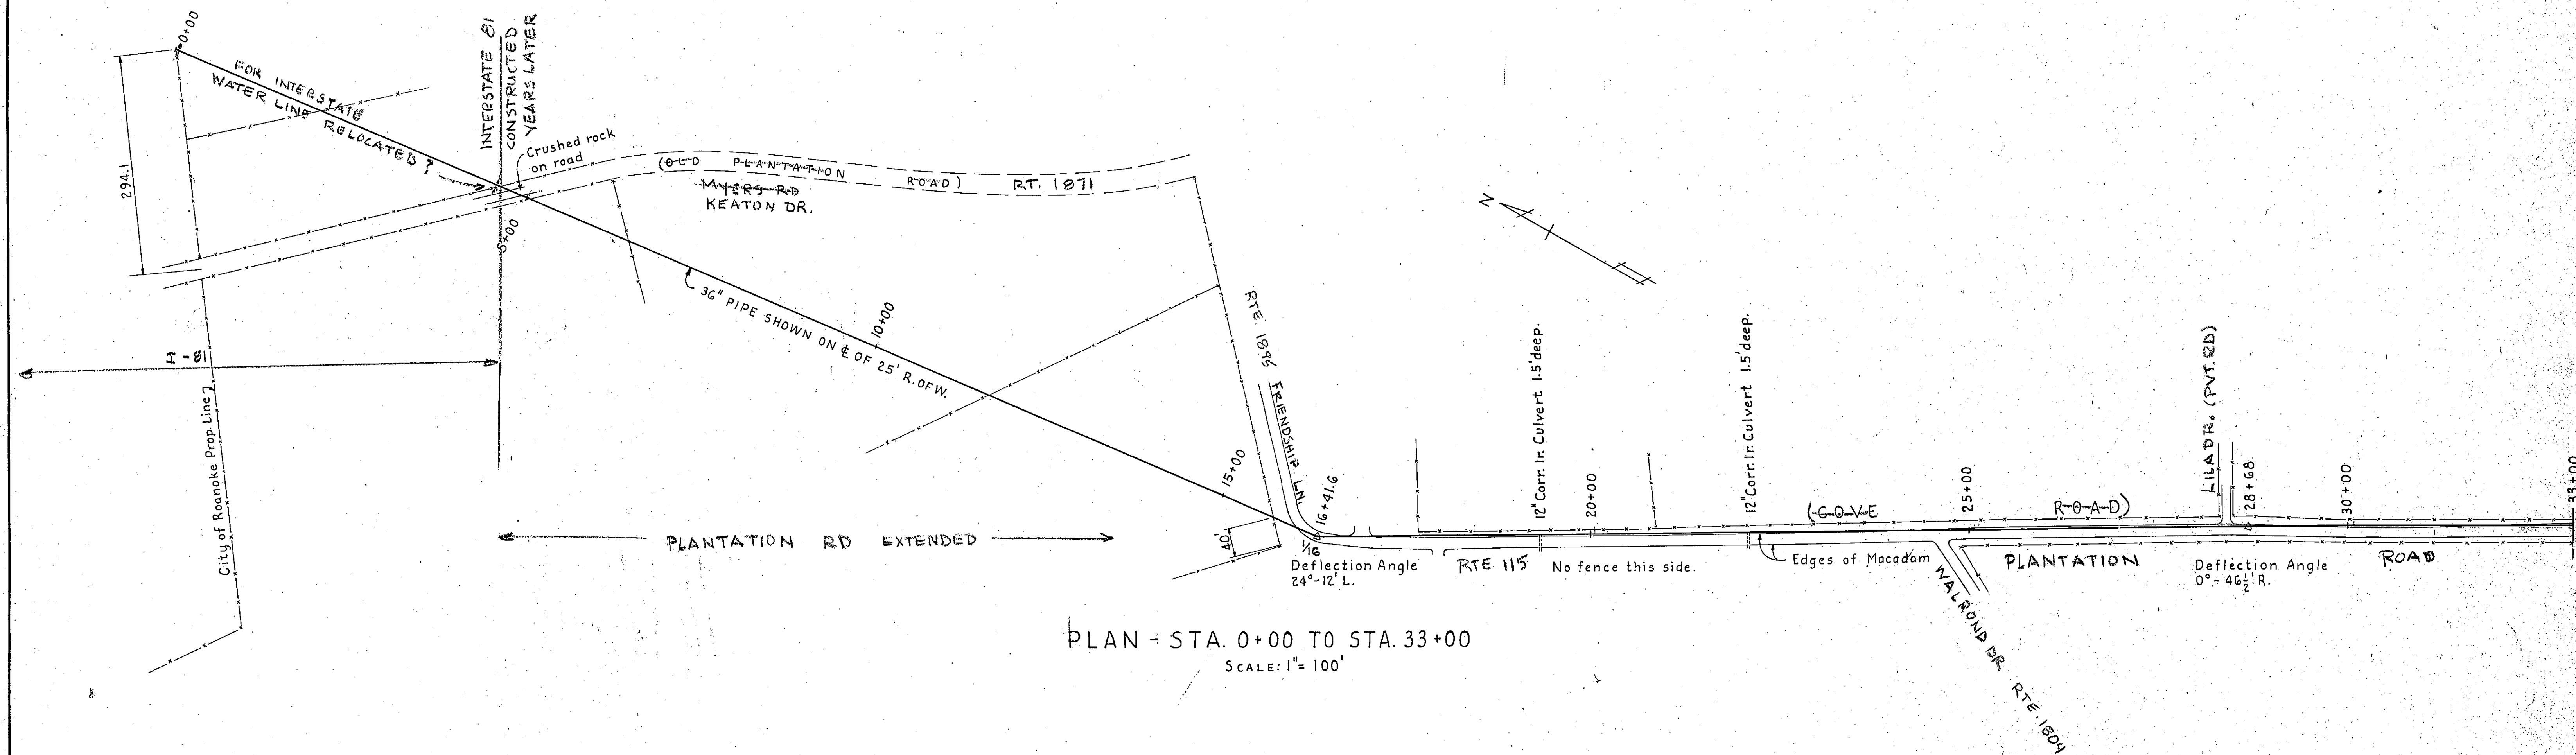

Note: Elevs. refer to U.S. Datum.