



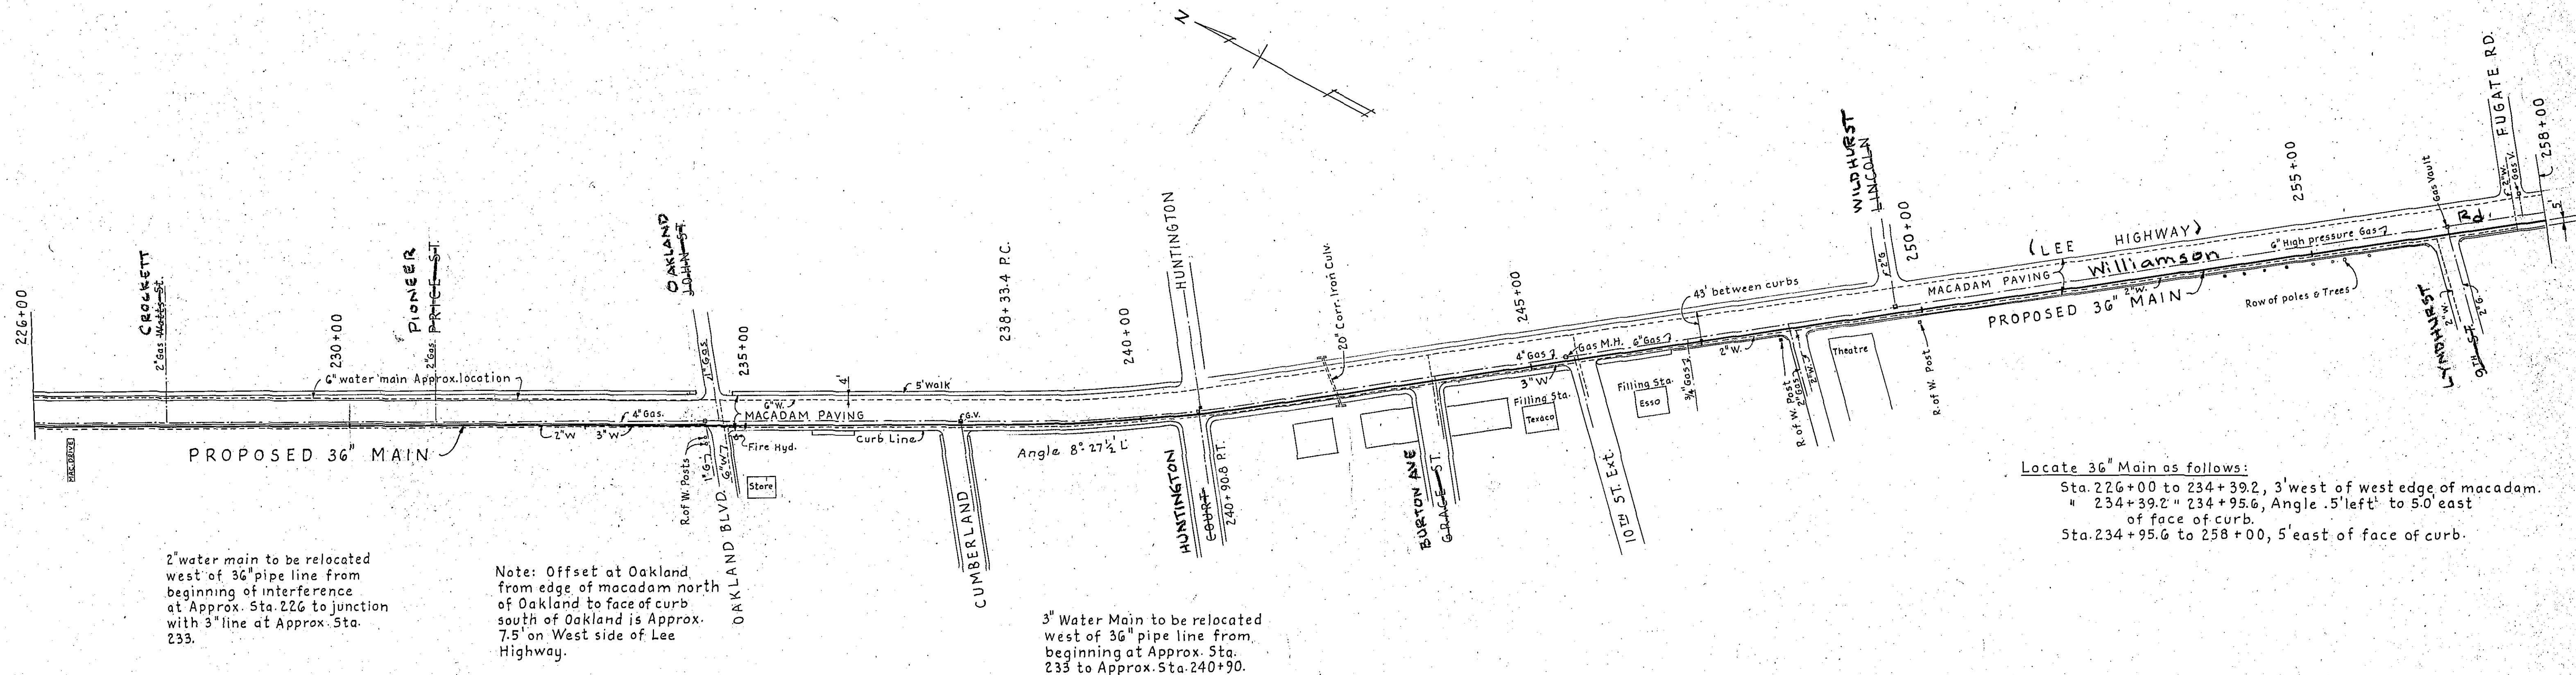

PLAN - STA. 226+00 to 258+00

SCALE: 1" = 100'

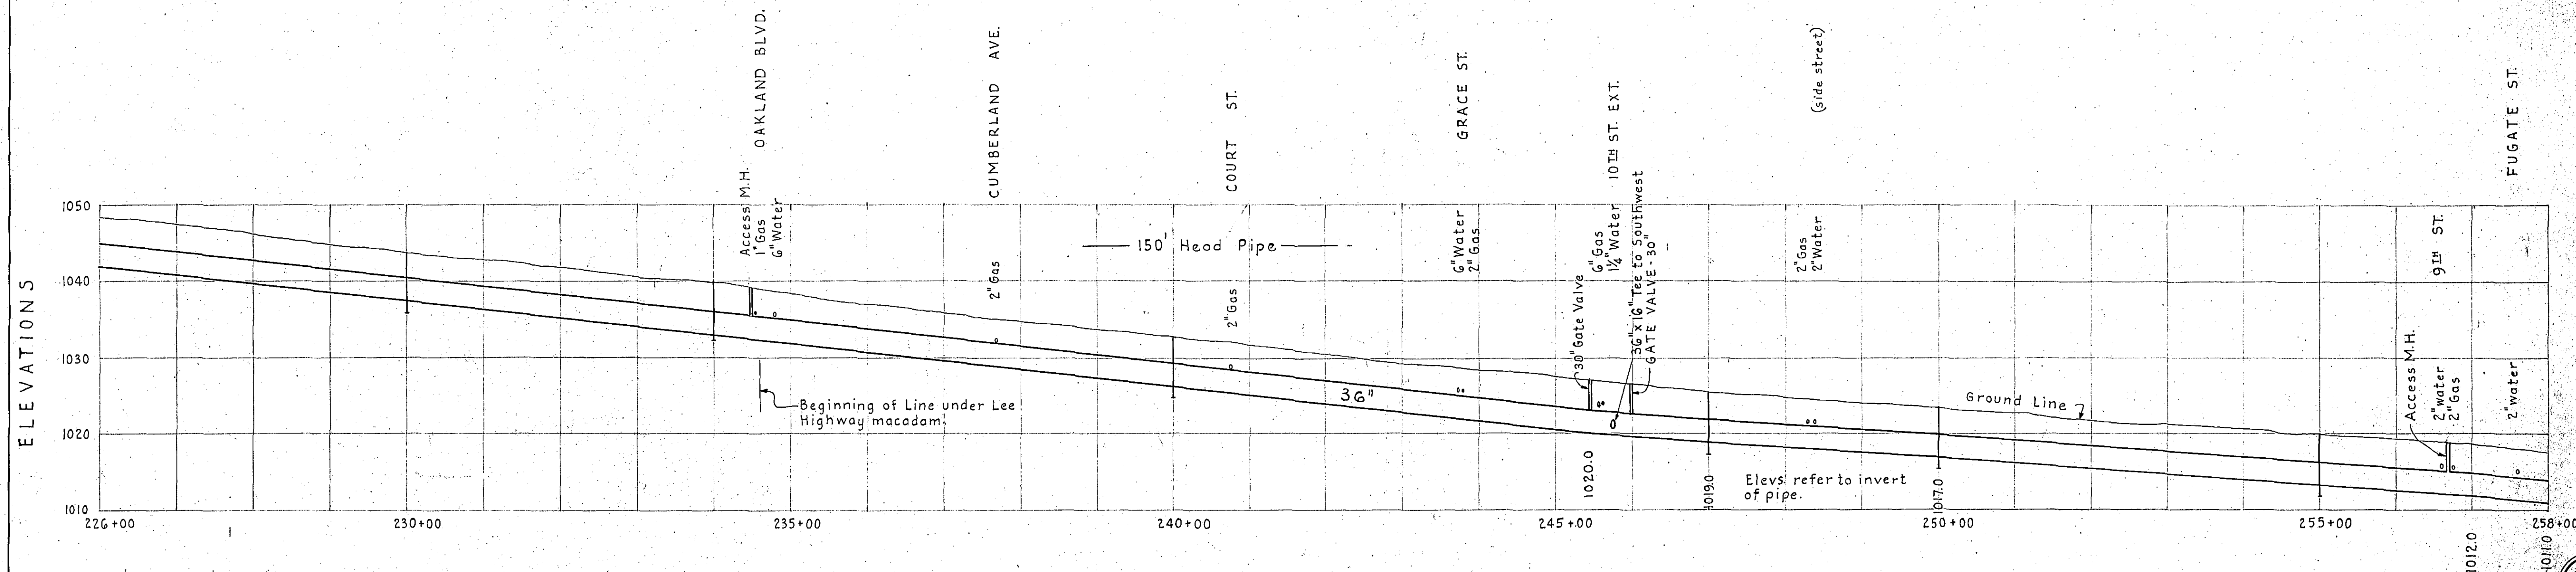

PROFILE

SCALES: Horiz. 1" = 100'
 Vert. 1" = 10'

Elevs. refer to U.S. Datum.