



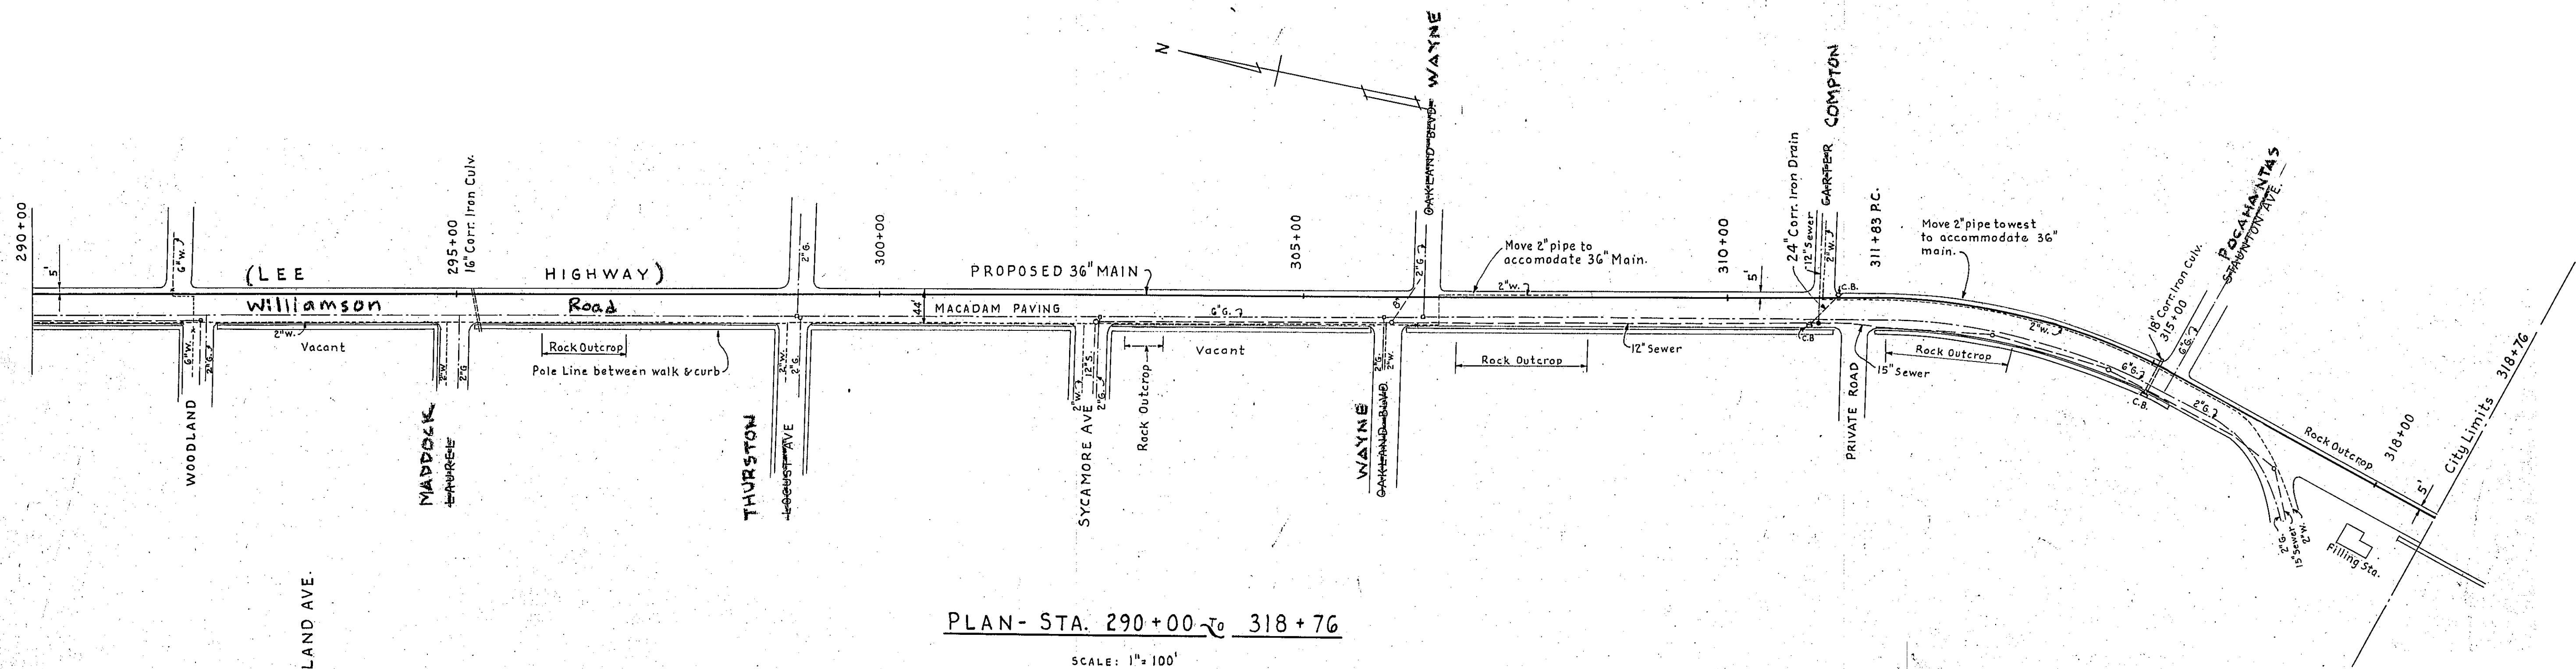

PLAN- STA. 290+00 to 318+76

SCALE: 1"=100'

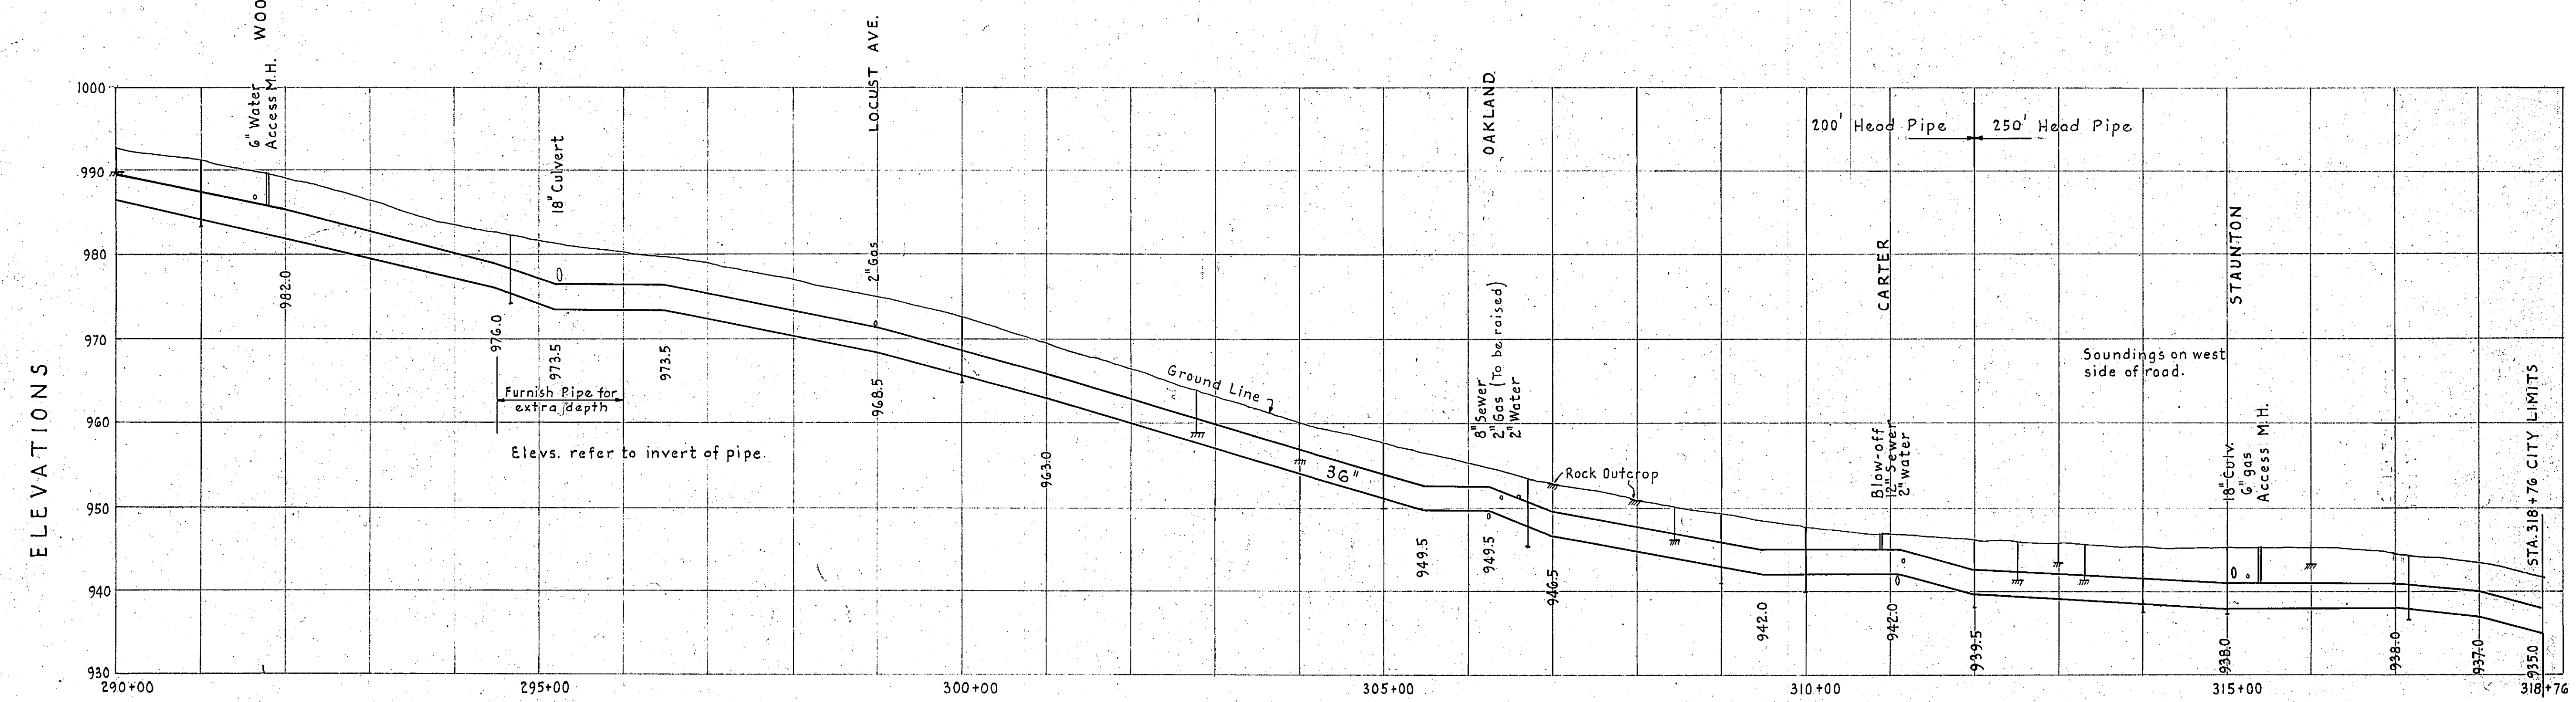

PROFILE

Scales { Horiz: 1"=100'
Vert: 1"=10'

Elevs. refer to U.S. Datum