


0

50

100

150

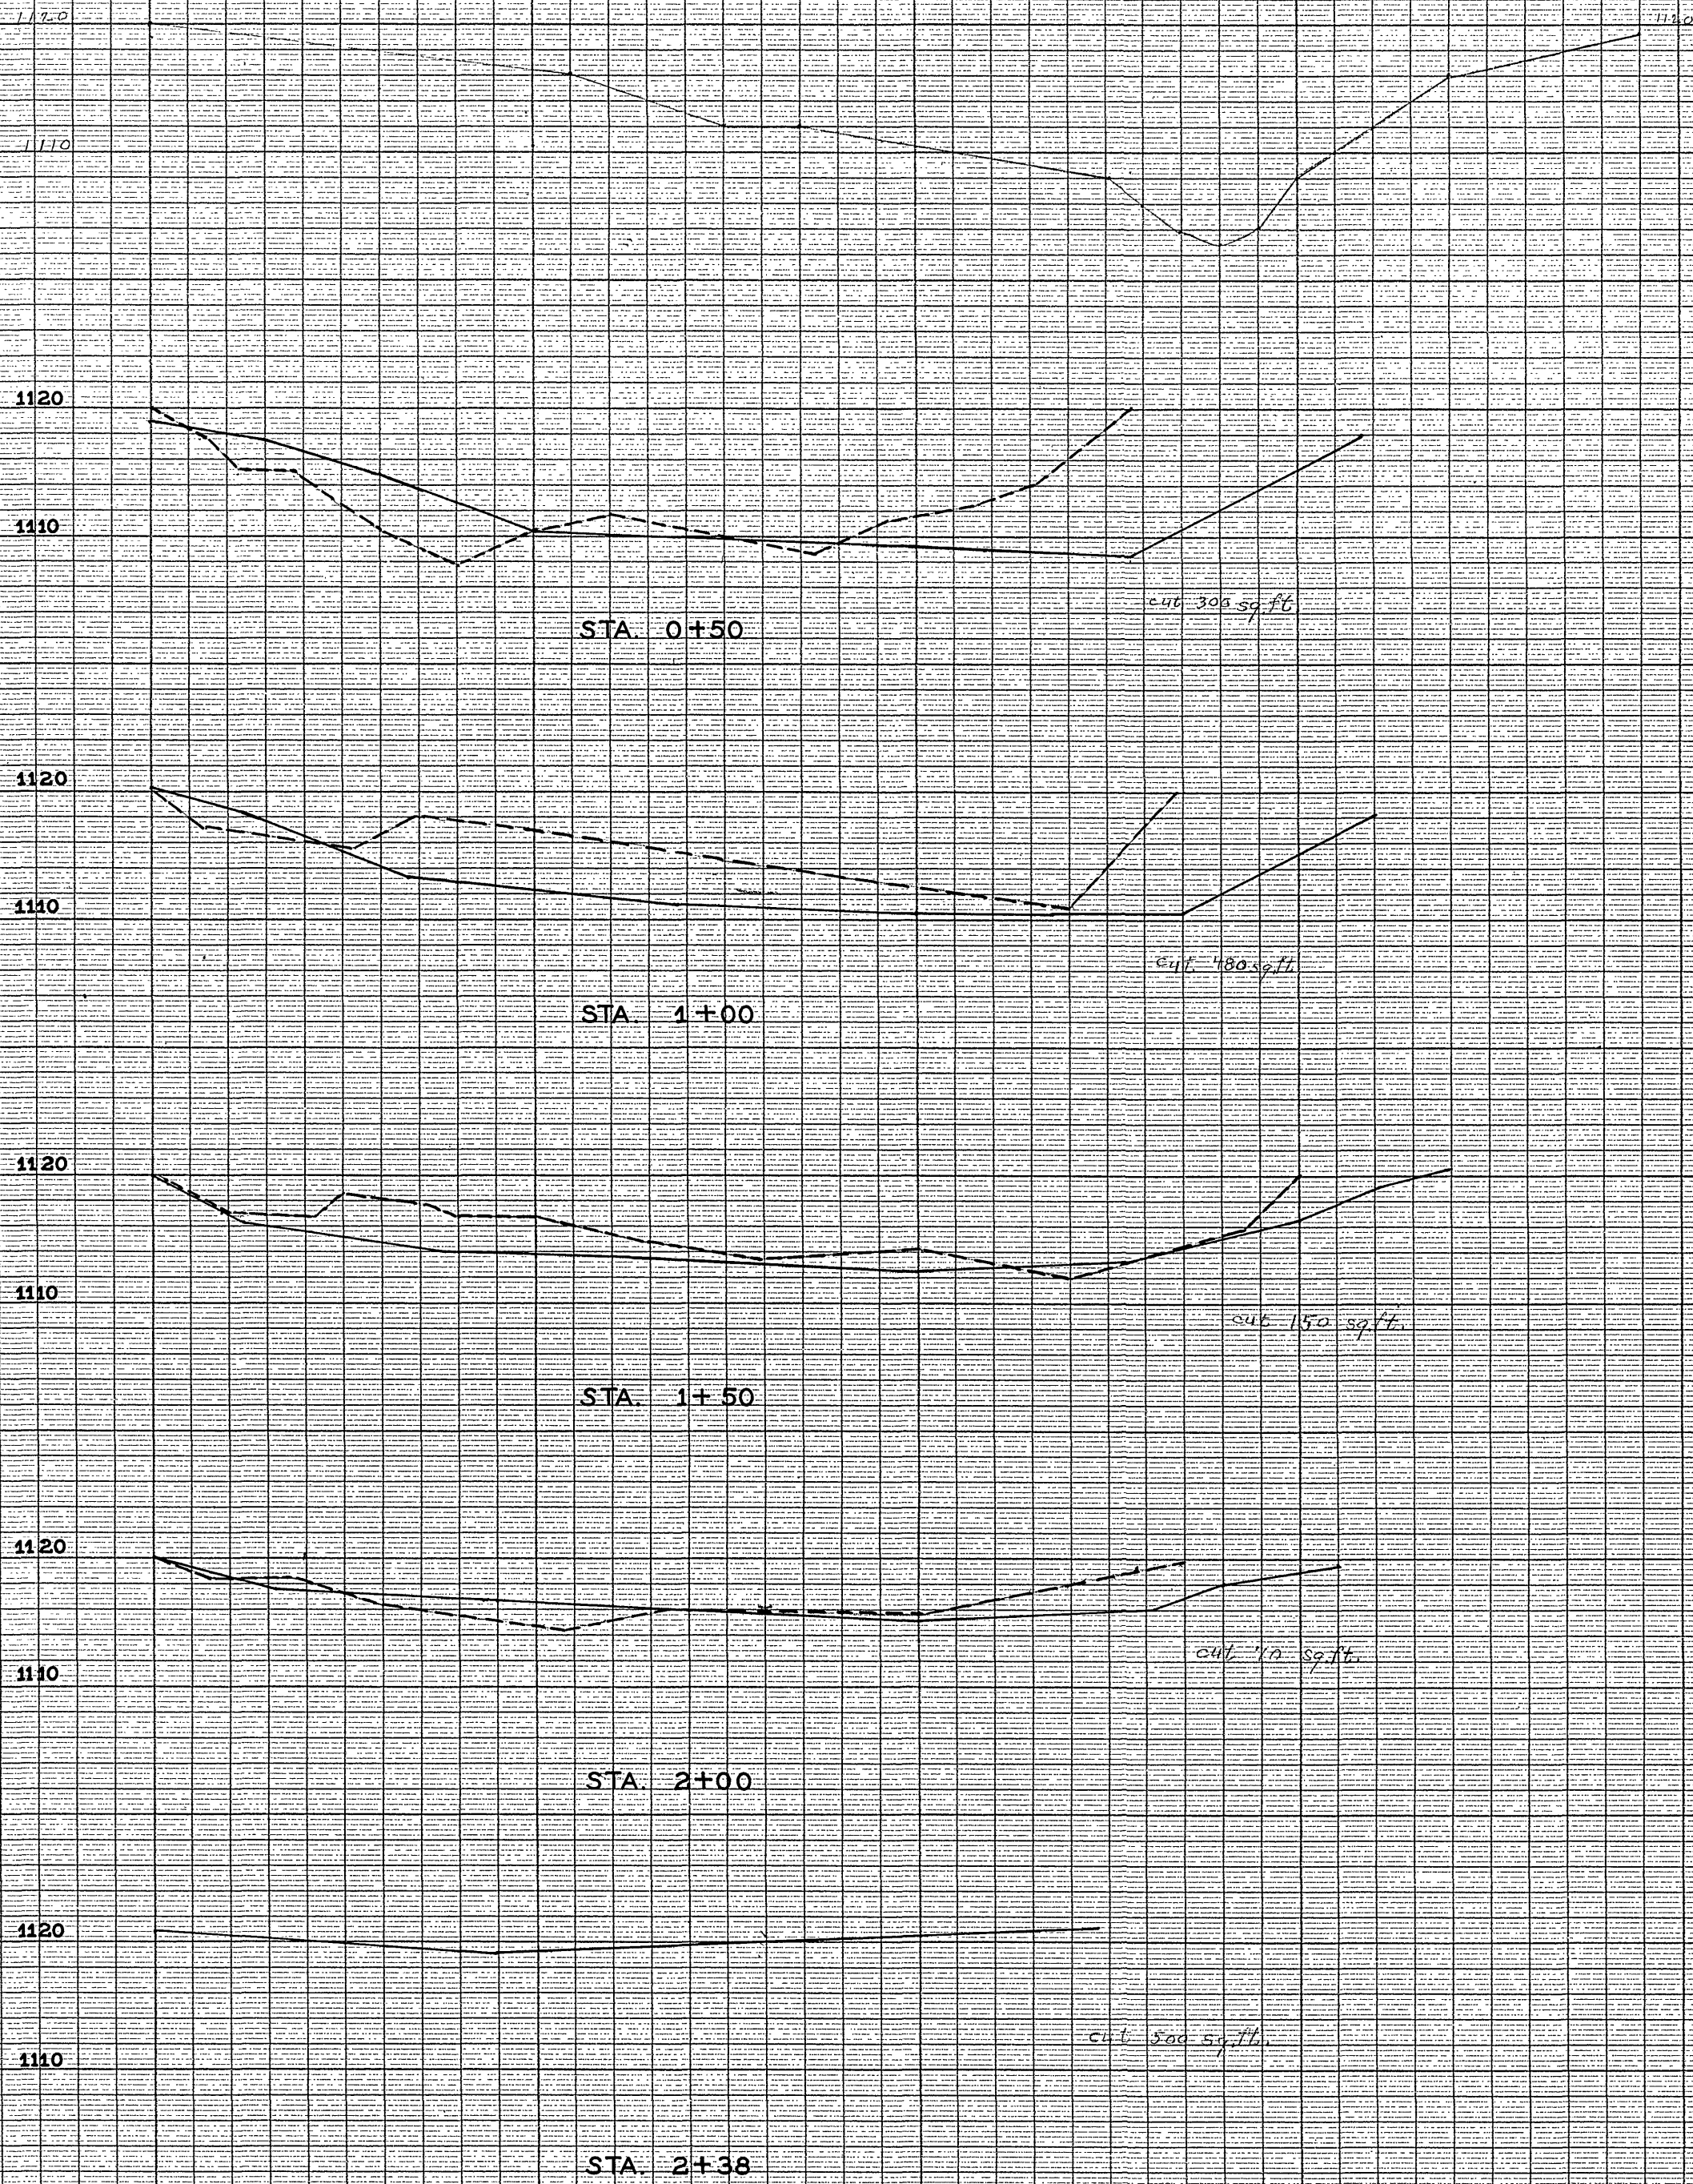

C.C. Secondary Settling Basin
Final Cross Section
Cut Yds. Material Excavation

CARVINS COVE
SECONDARY SETTLING BASIN
FINAL CROSS SECTION CUBIC YARDS
MATERIAL EXCAVATION

Tilt 20
angle C.C. Sec. Settling Basin

F3-D4

164