


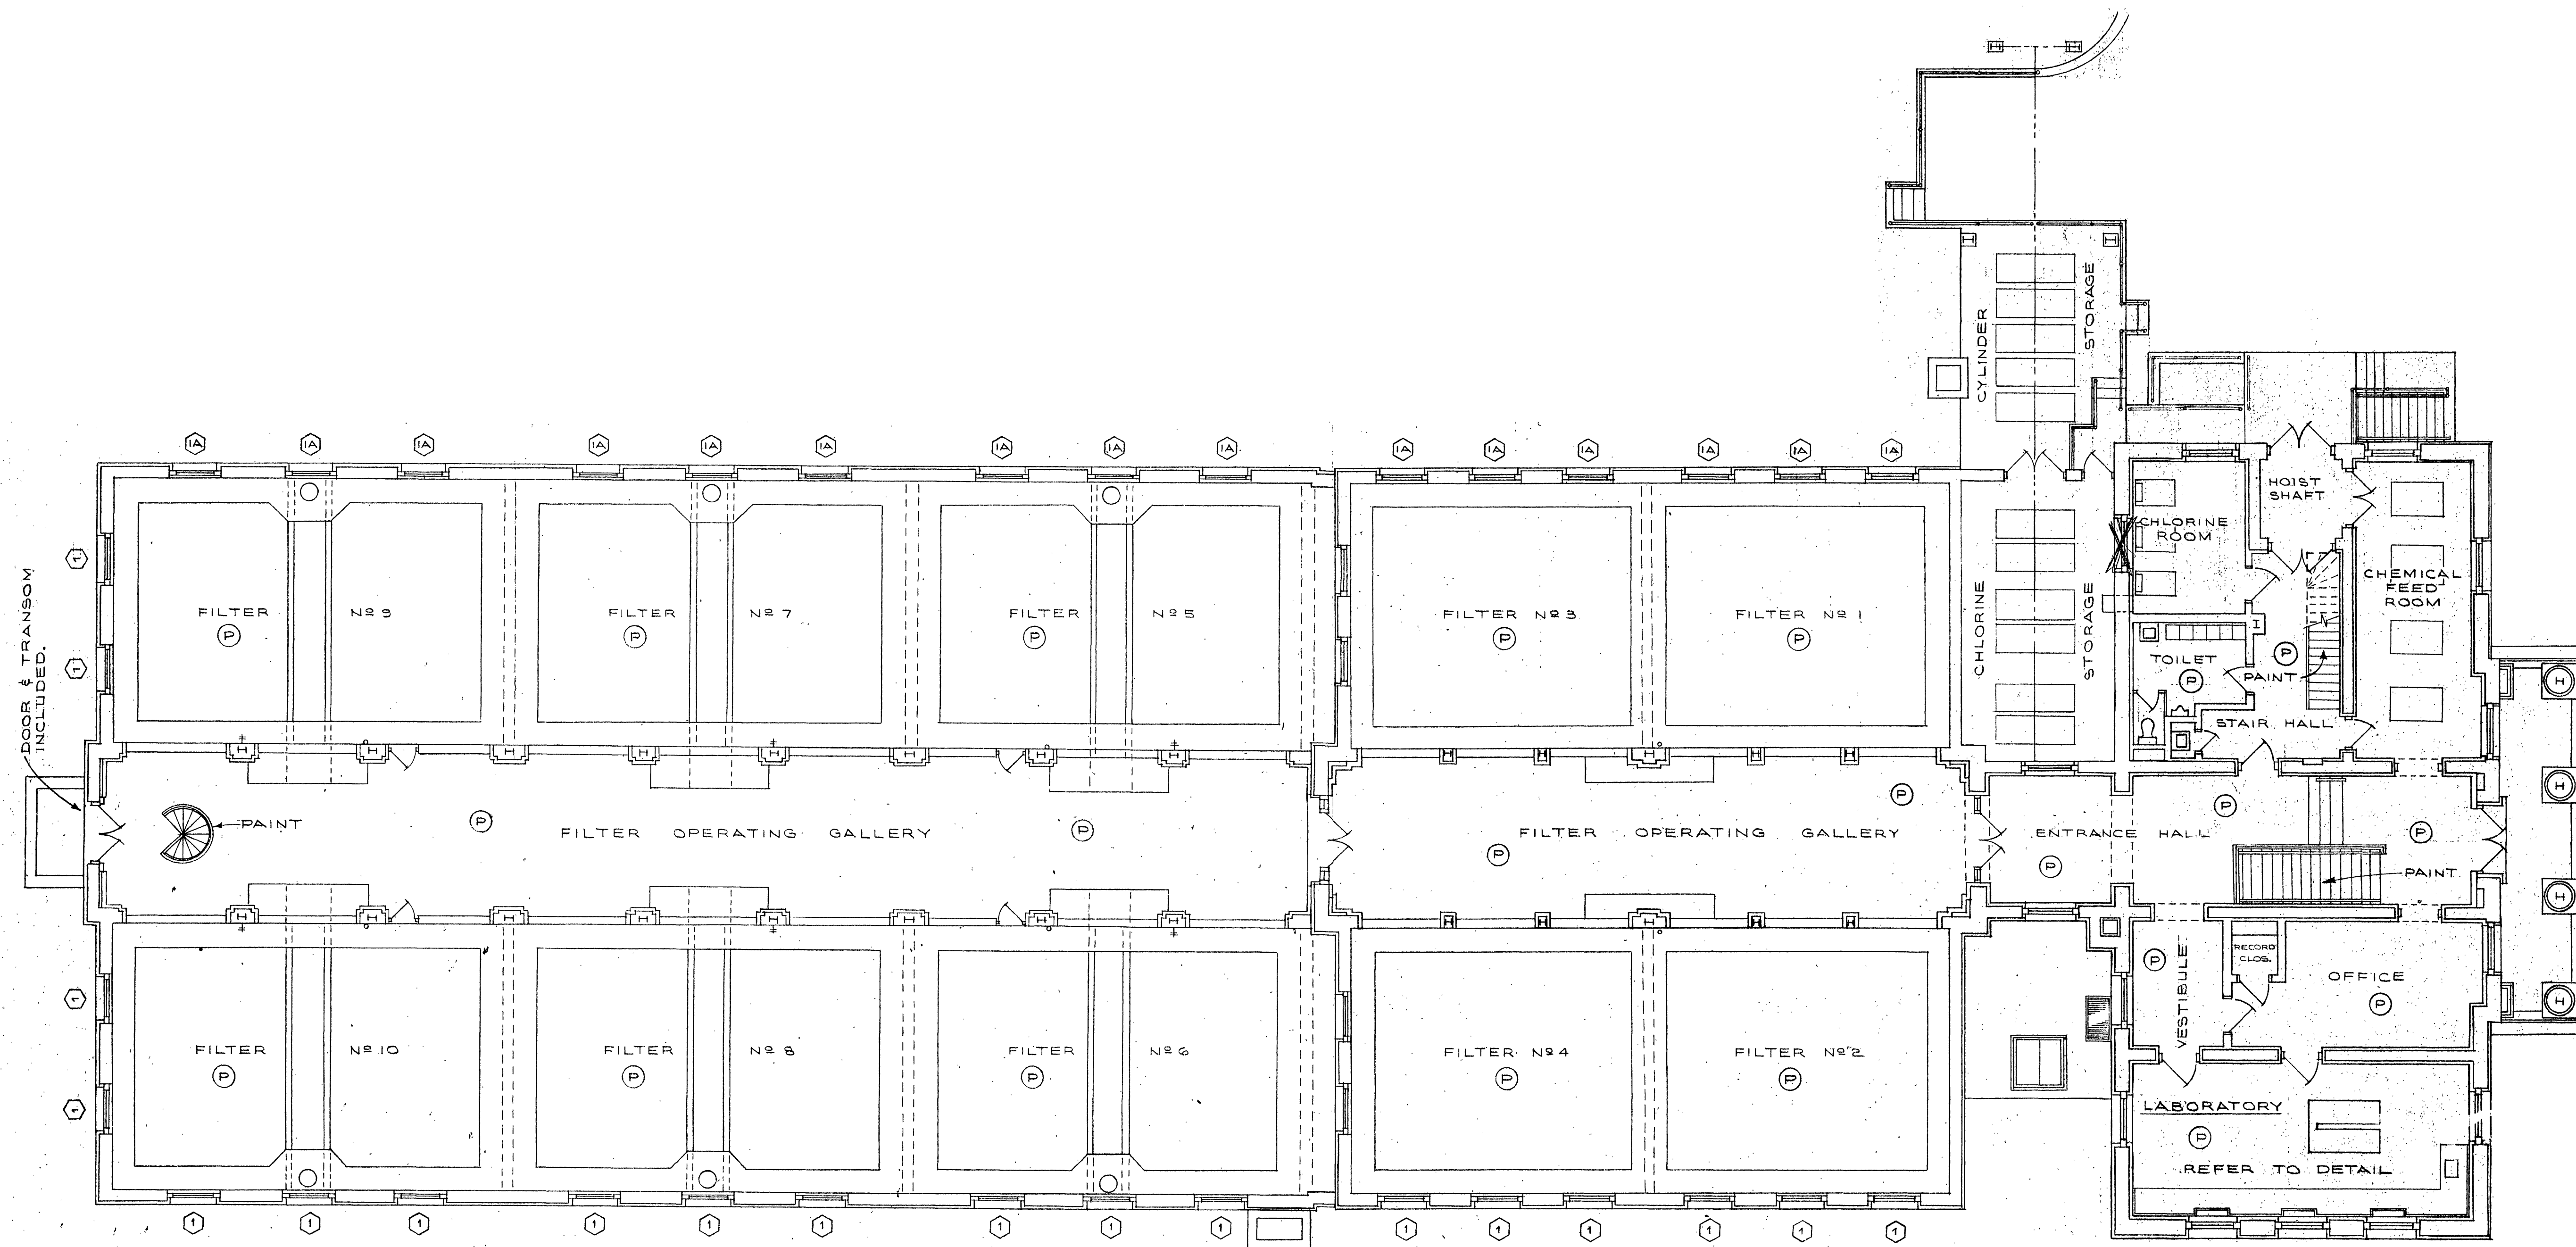

MAIN FLOOR PLAN
SCALE: 1/8" = 1'-0"

REV. 2 NOTE: (P) INDICATES THE AREA TO BE PAINTED.

1A & 1 TYPICAL WINDOWS
FILTER OPERATING
AREA FIRST FLOOR.
PAINT OUTSIDE ALSO.

NEW INTERIOR PAINTING	20 FS
NEW STORM WINDOWS & DOOR	10 FS

11-7-77	2	FIRST FLOOR PAINTING	LBC
11-29-76	1	INTERIOR PAINTING	LBV
DATE	REV.	DESCRIPTION	BY
MAIN FLOOR PLAN			
CITY ENGINEER			
PLANS OF CARVIN'S COVE FILTER PLANT ROANOKE, VIRGINIA			DRAWN: LBV
CITY OF ROANOKE OFFICE OF CITY ENGINEER ROANOKE, VIRGINIA			CHECKED: LBC
CONTRACTOR MUST VERIFY ALL DIMENSIONS AT PROJECT BEFORE PROCEEDING WITH WORK			DATE: 5-76
			JOB NO. 4266
			SHEET 1