

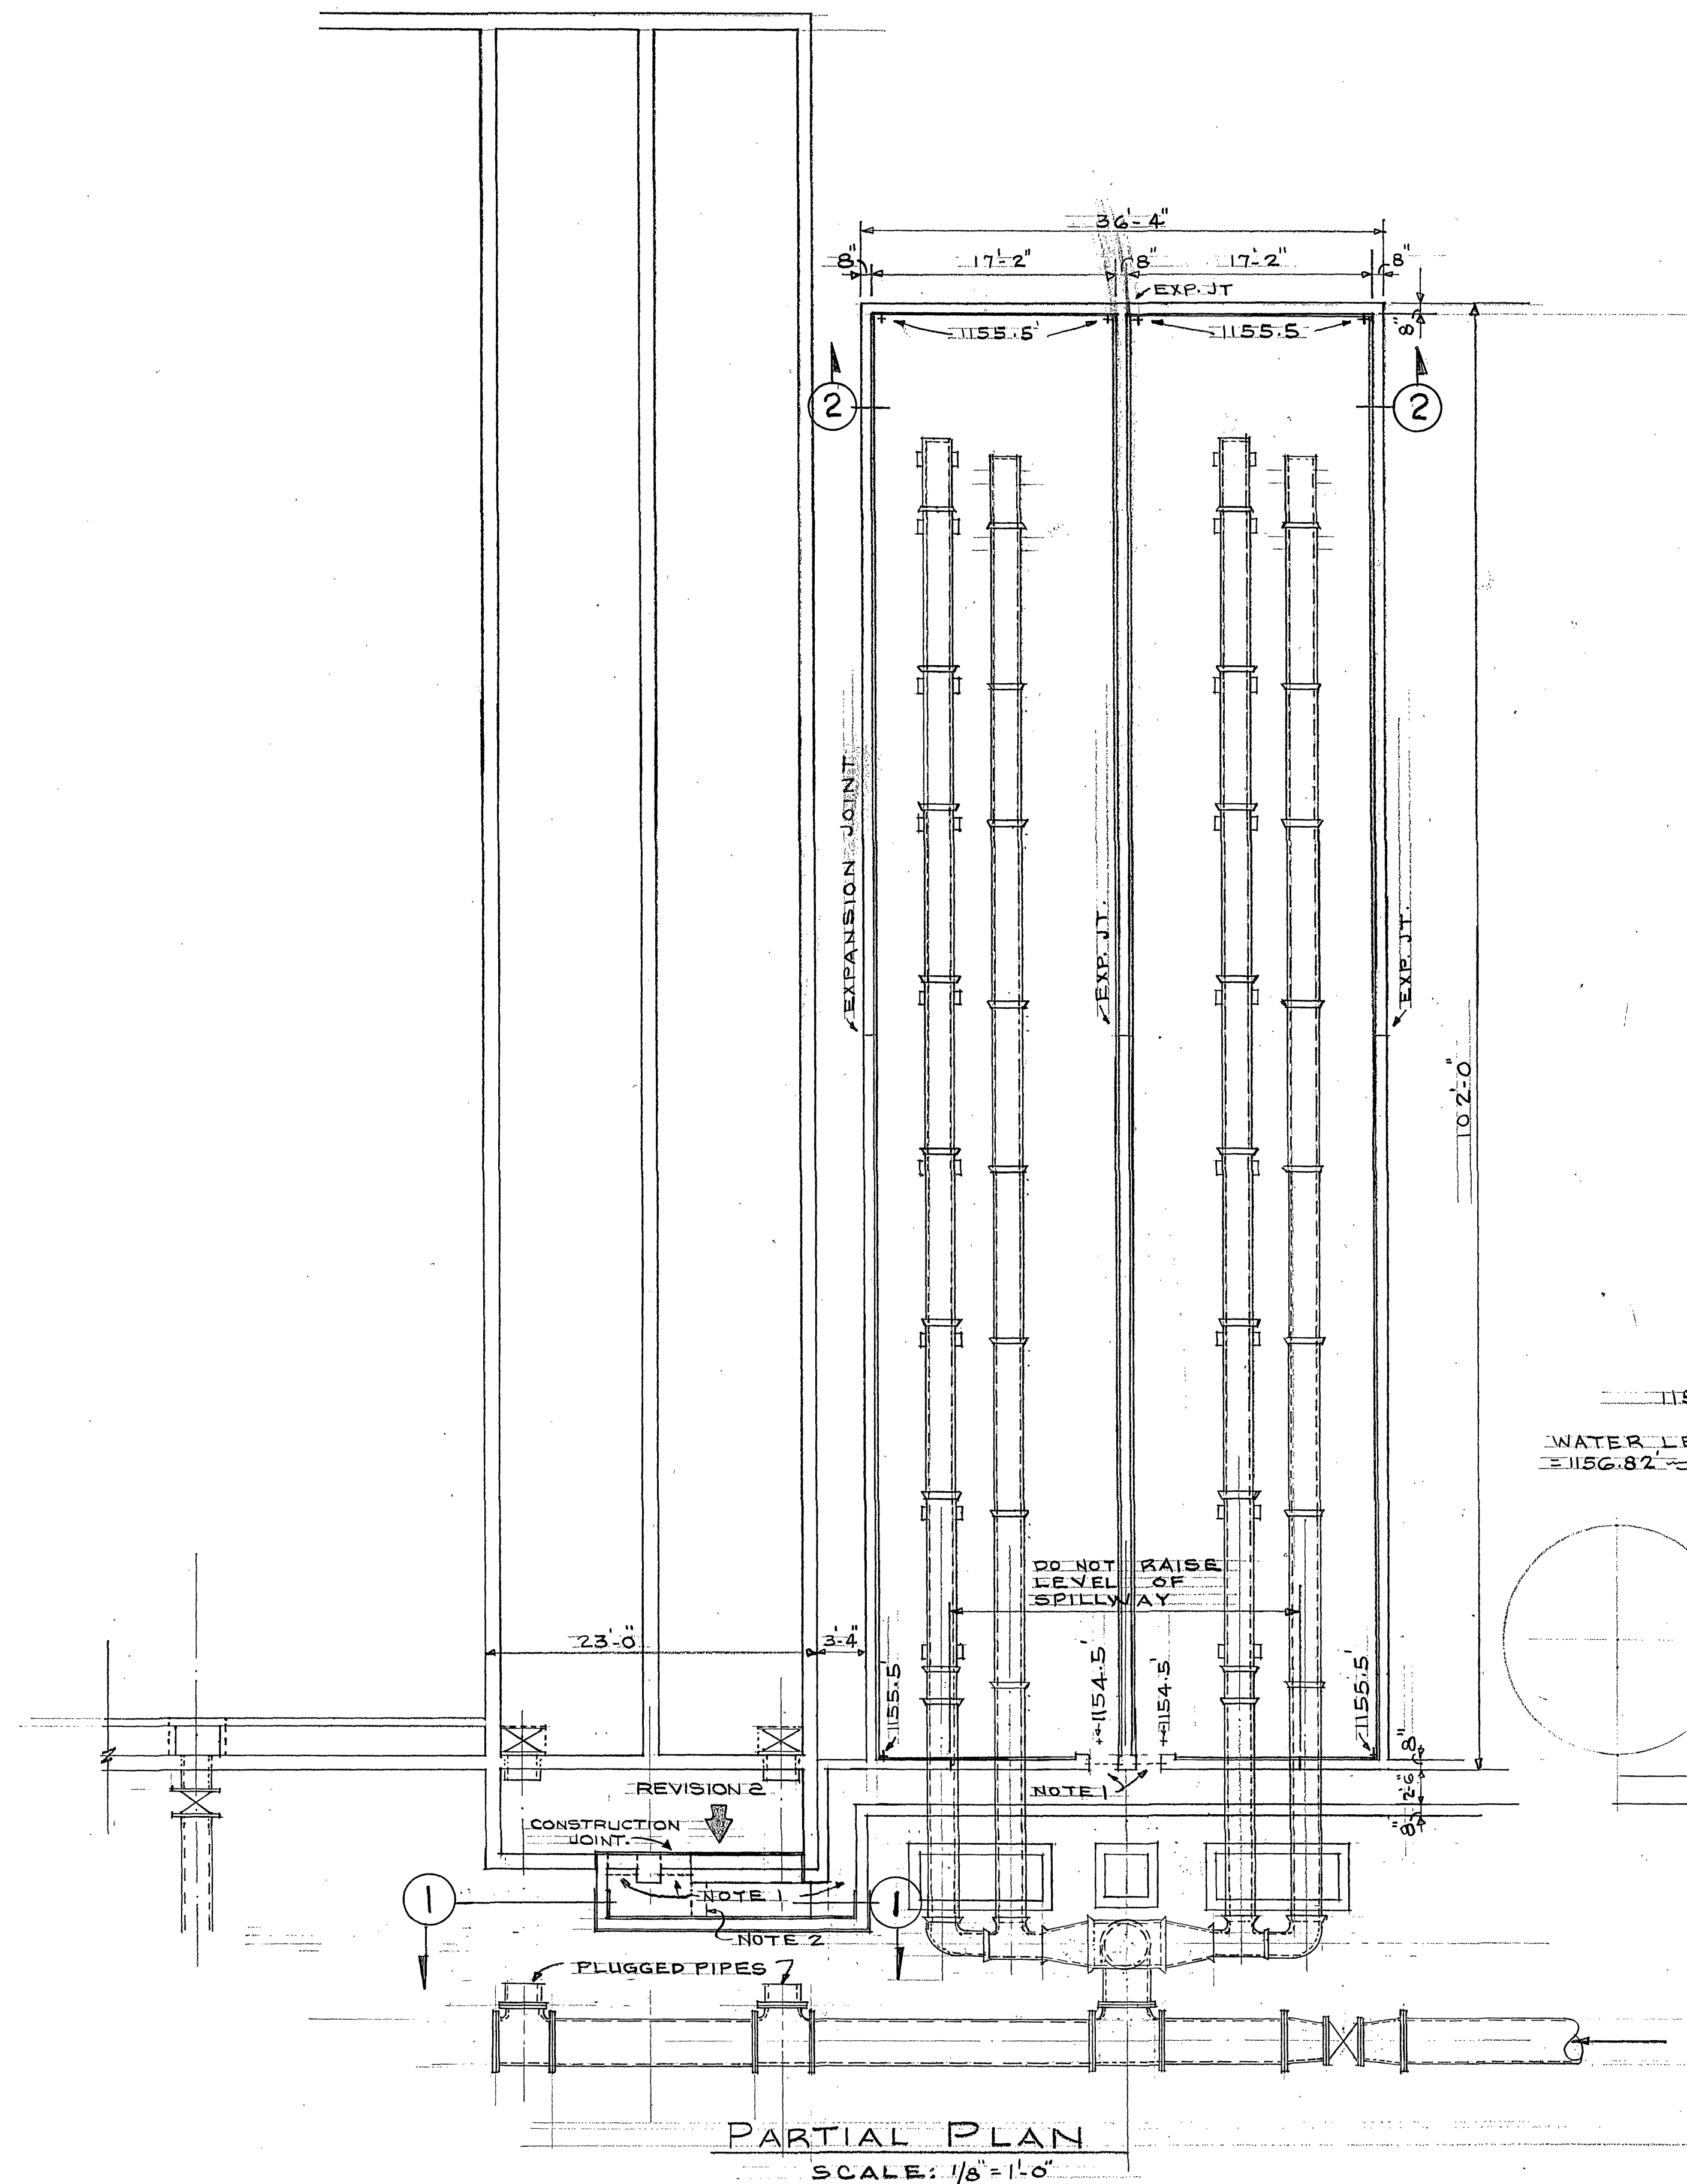


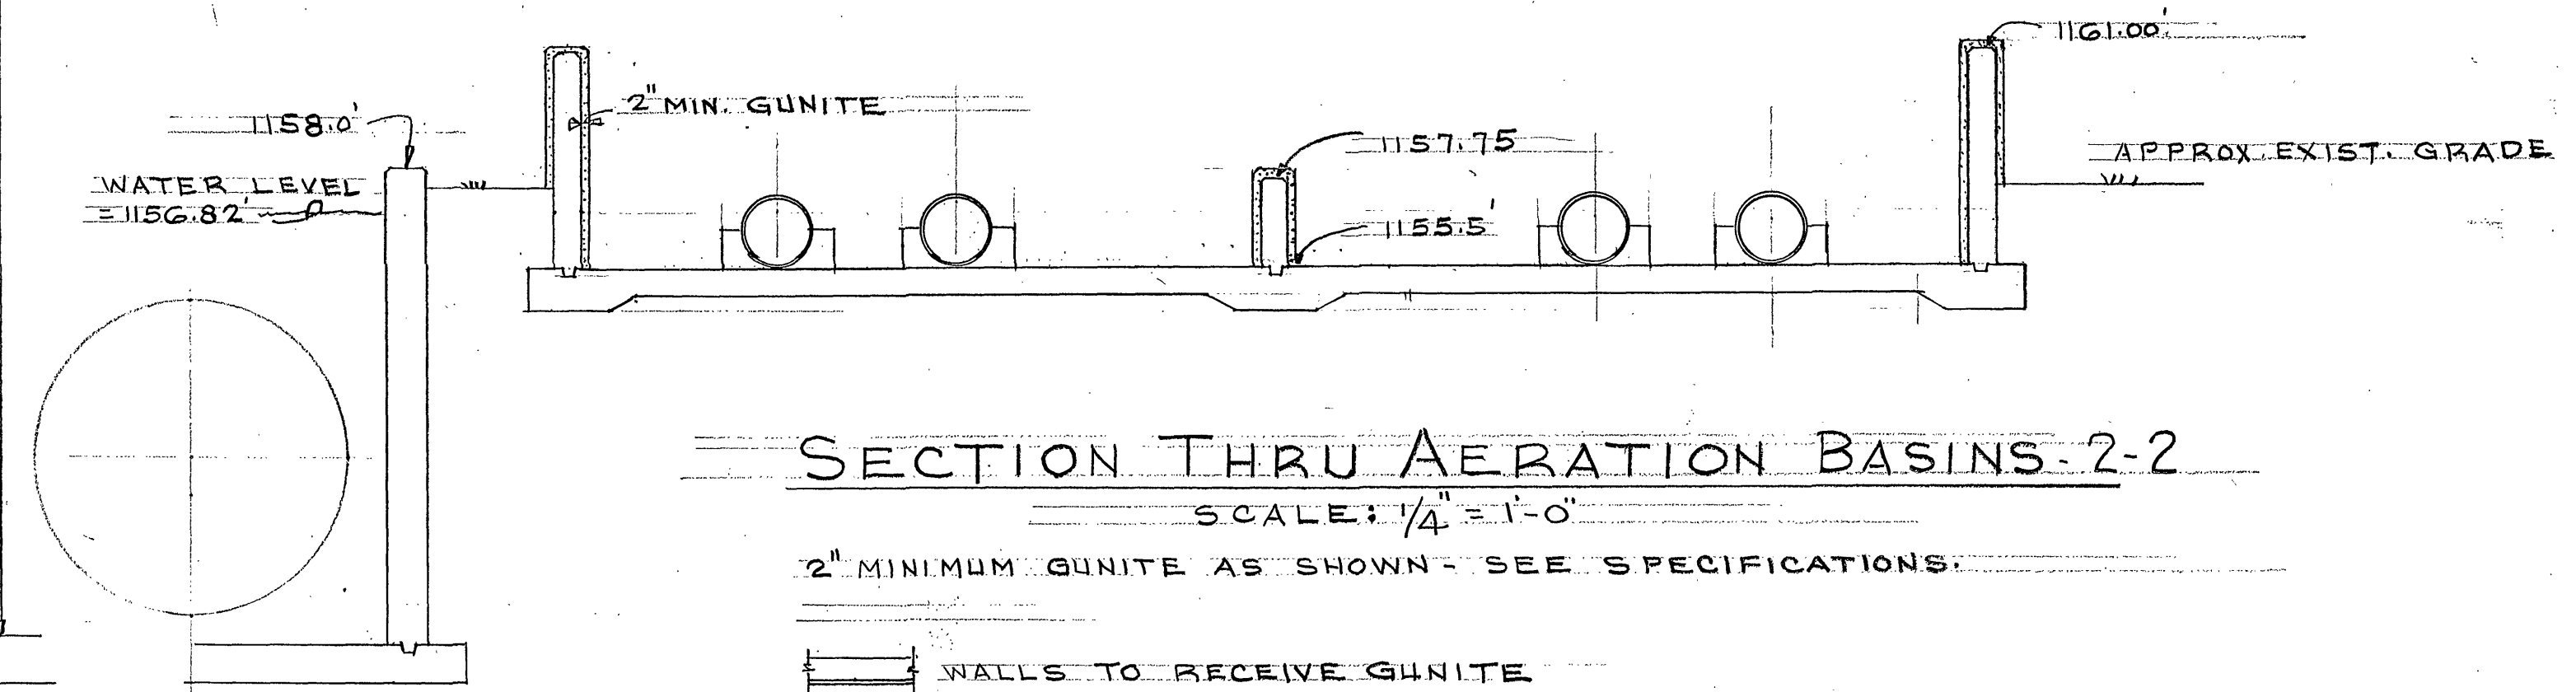

NOTE 1.
CONCRETE IN PASSAGEWAYS HAS
SPALLED BADLY AND IS IN DIRE
NEED OF REPAIR. RETAIN AS MUCH
OF ORIGINAL PASSAGE OPENING WIDTH
AS POSSIBLE.

NOTE 2.
BEAM OVER IS 12 1/2" W x 8" D. RETAIN REINF.
& REBUILD CONCRETE PORTION OF
BEAM.

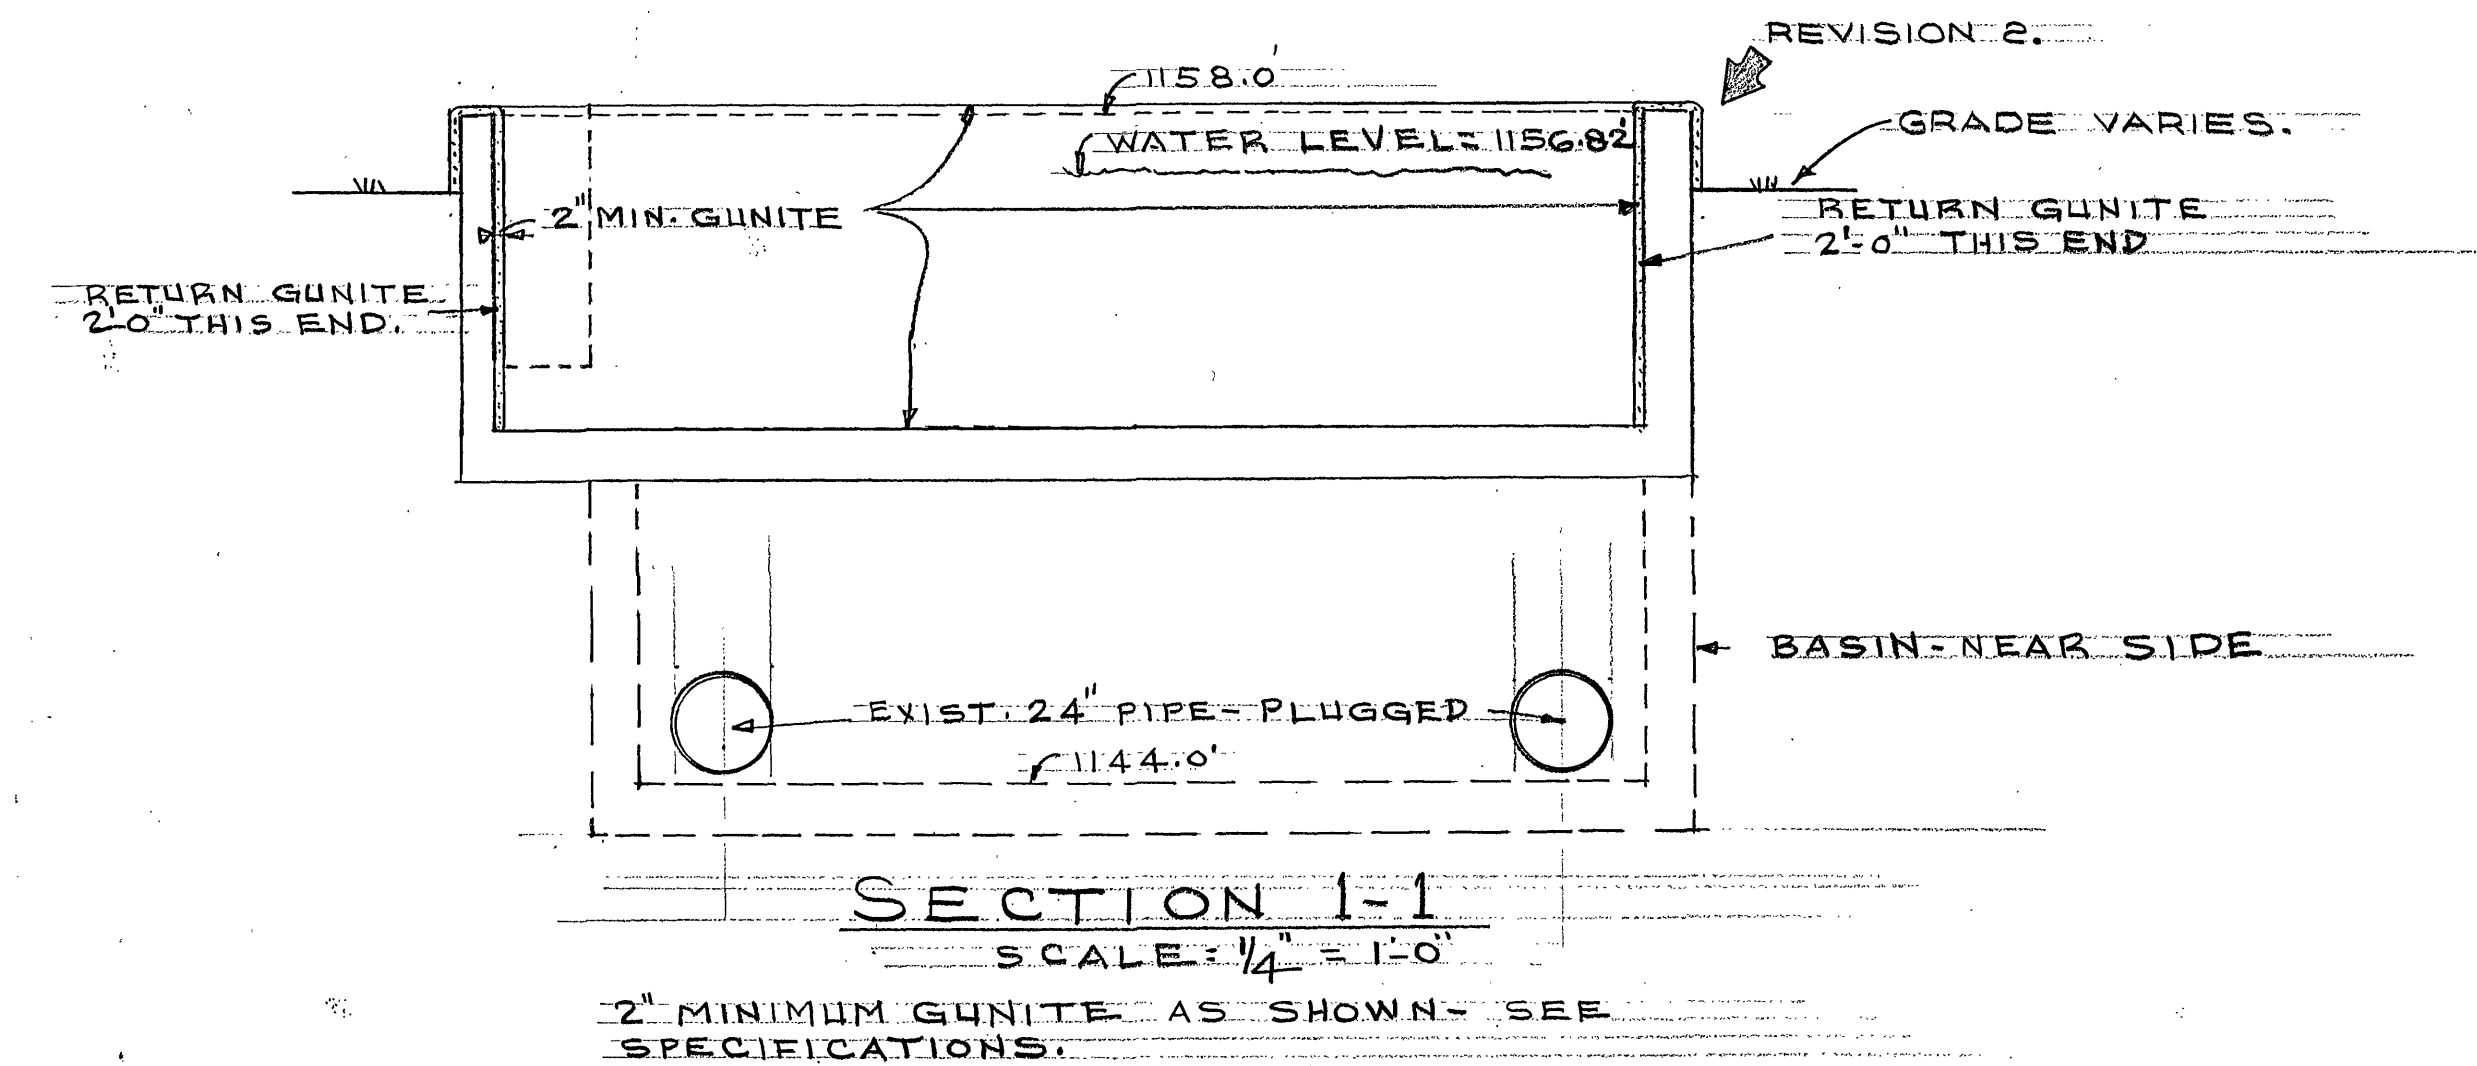

0-3-79	2	ADDENDUM II	LBV
8-24-79	1	GUNITE ON WALLS ONLY	LBG
DATE	REV.	DESCRIPTION	BY
