




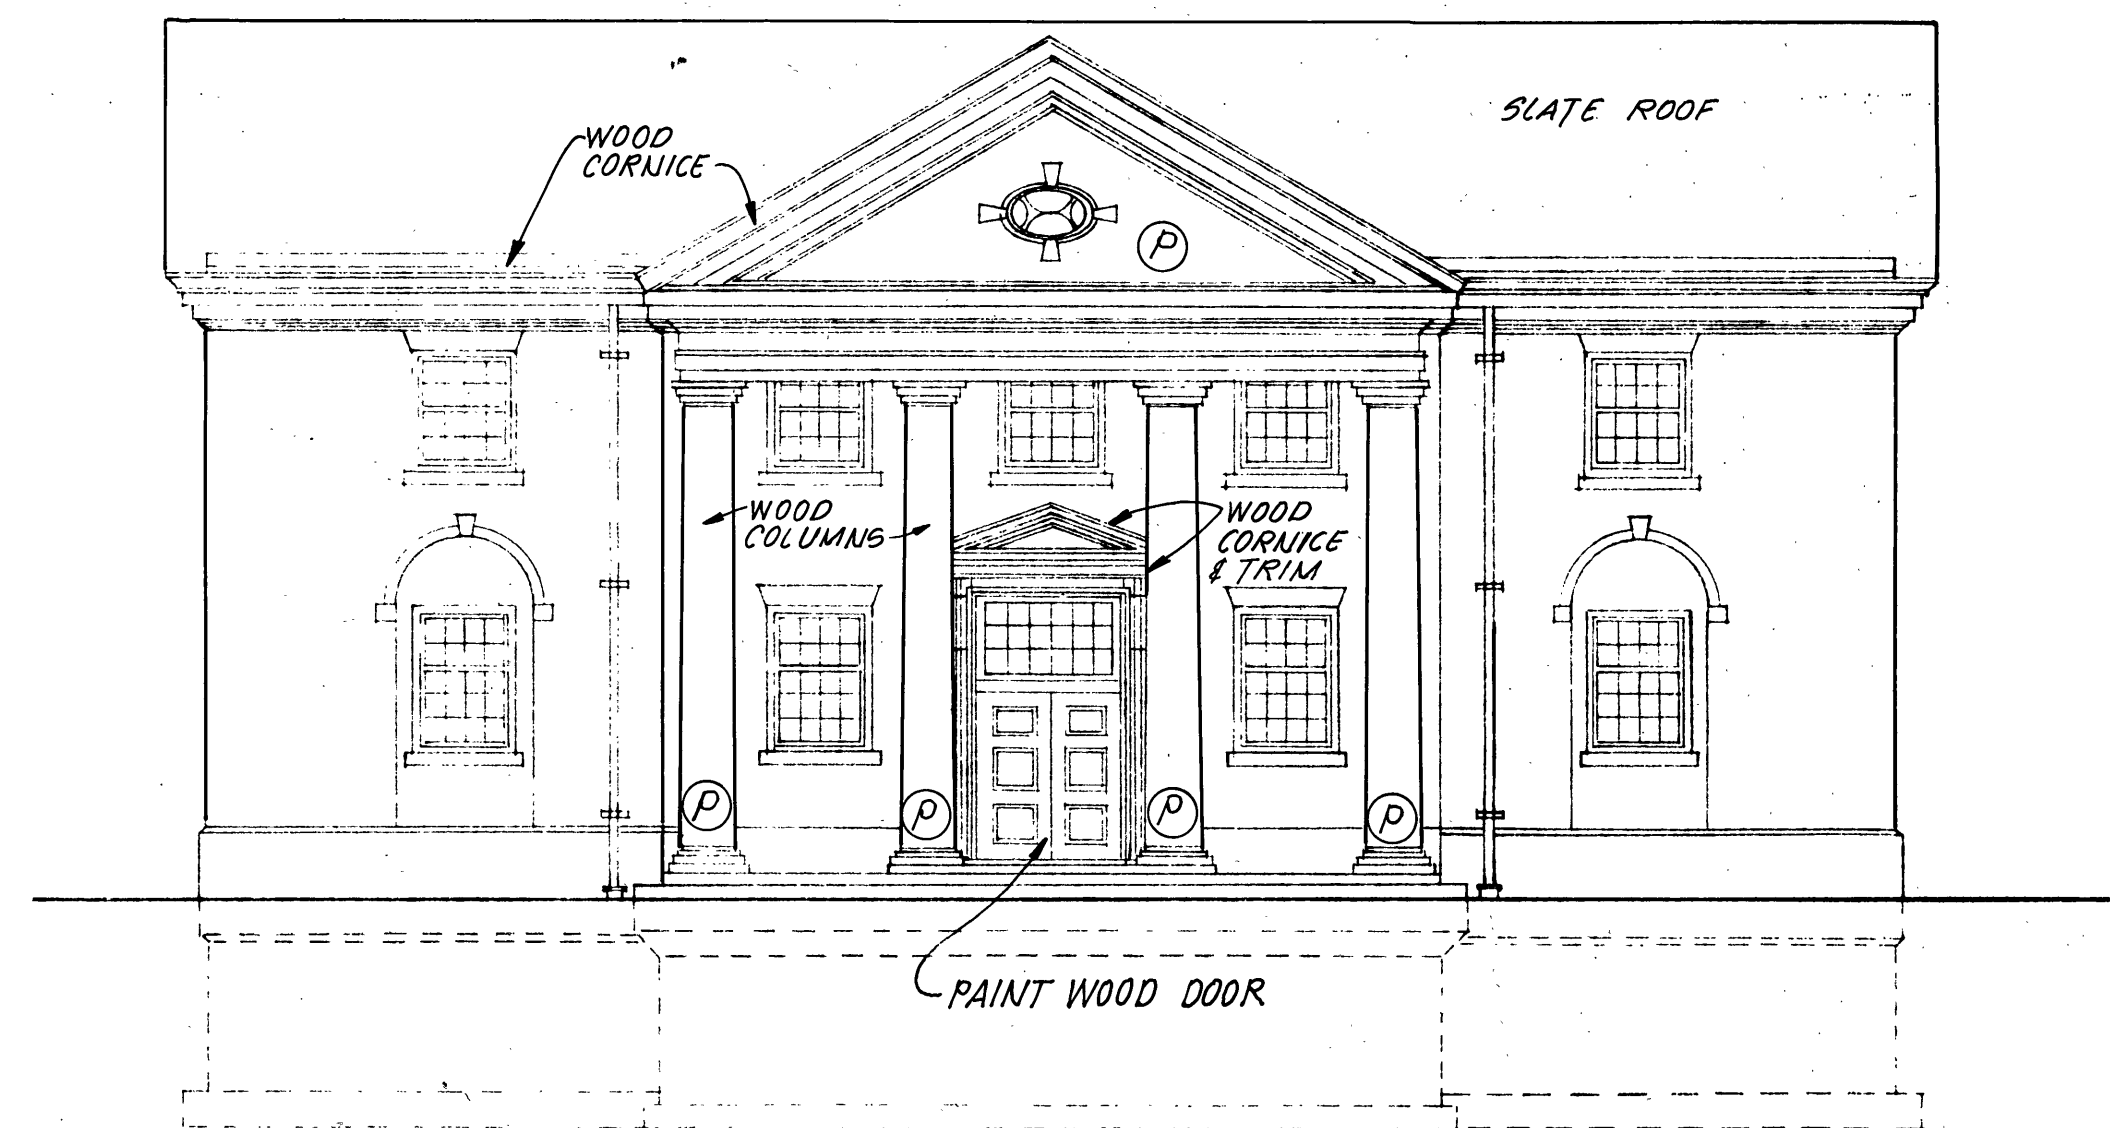

FRONT ELEVATION
SCALE: 1/8" = 1'-0"

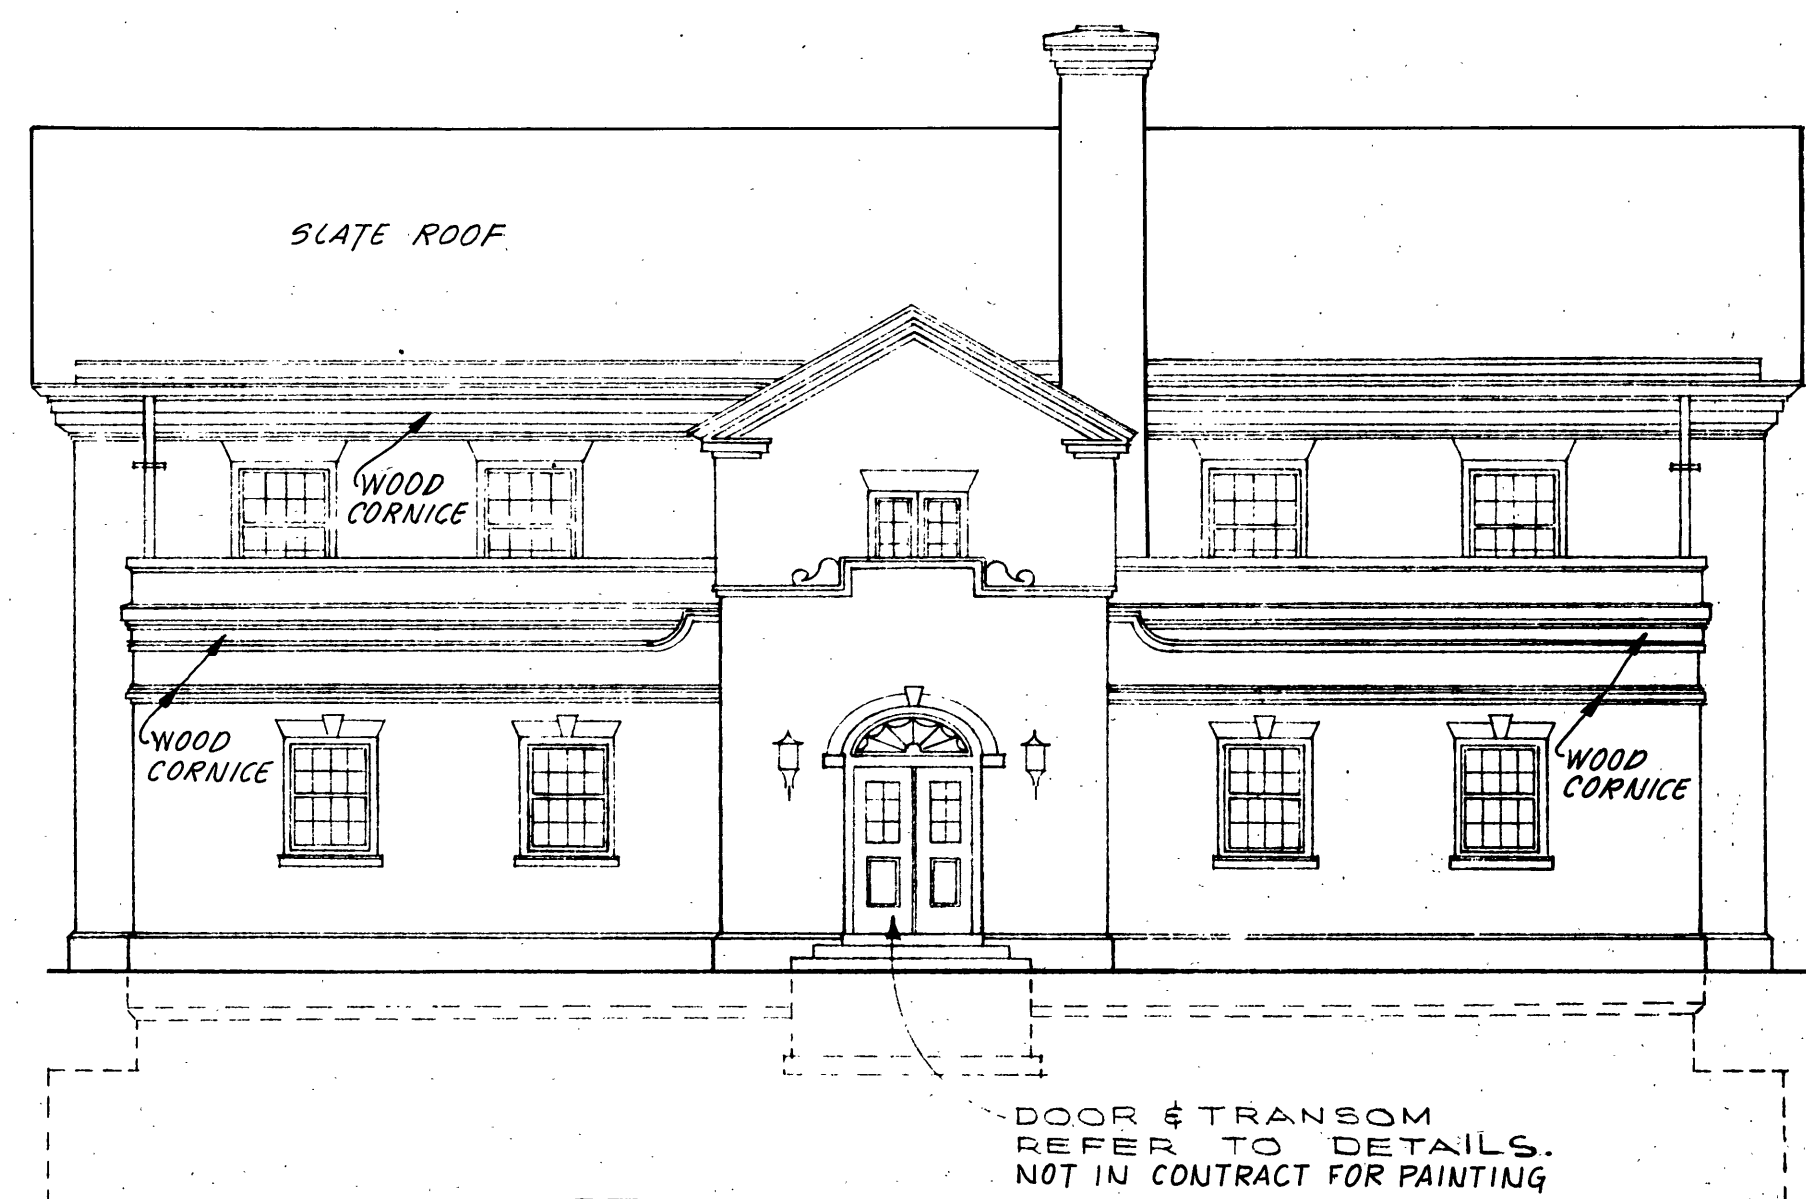


REAR ELEVATION
SCALE: 1/8" = 1'-0"

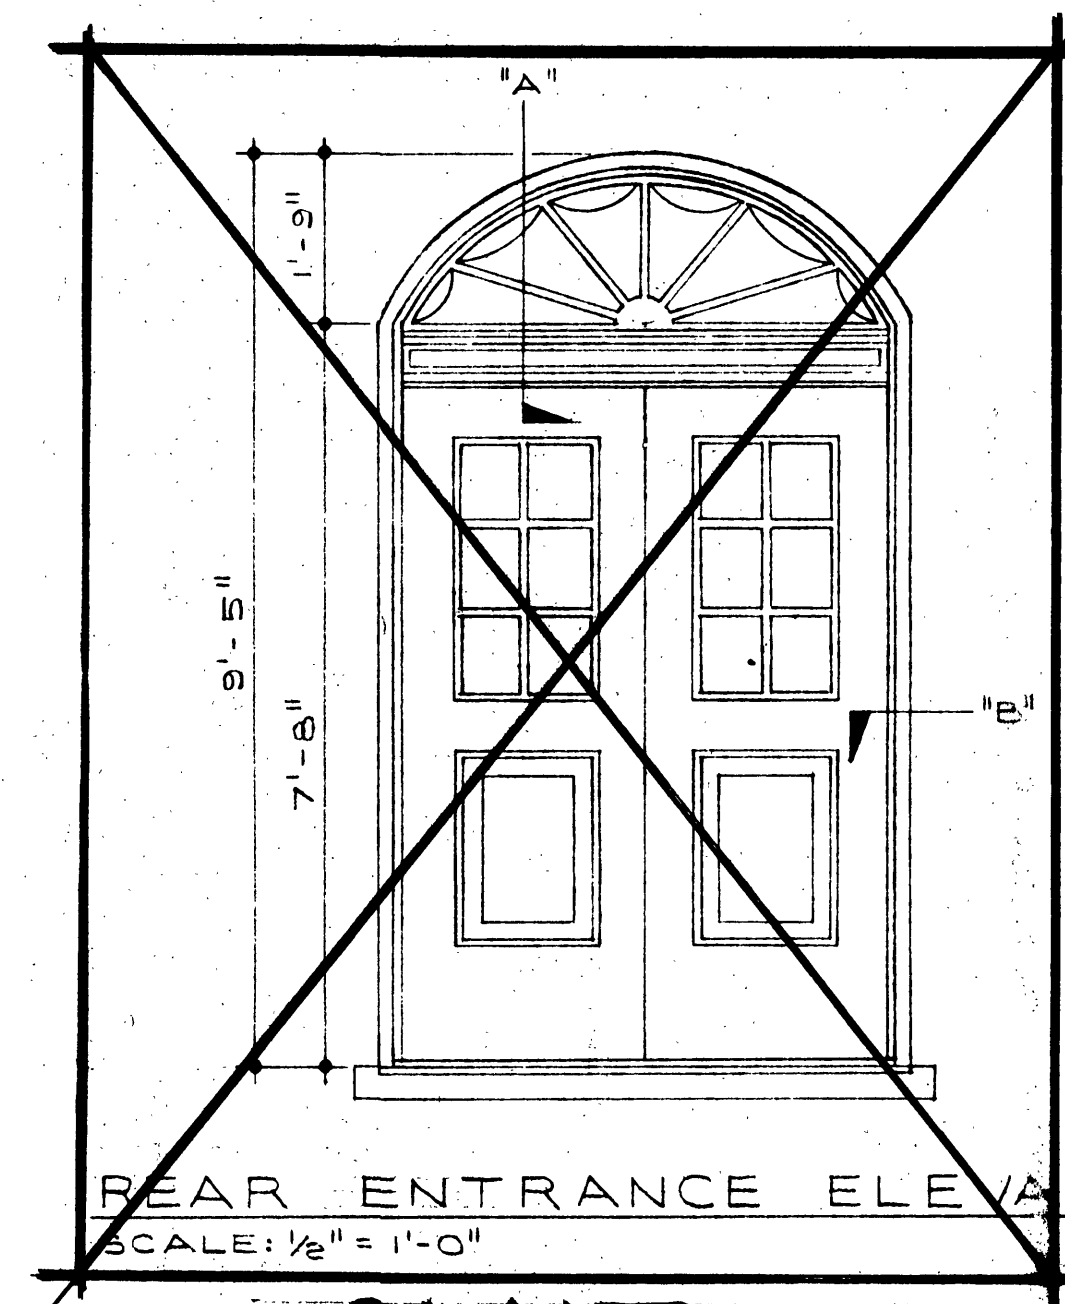


REAR ENTRANCE ELEVATION

OMIT

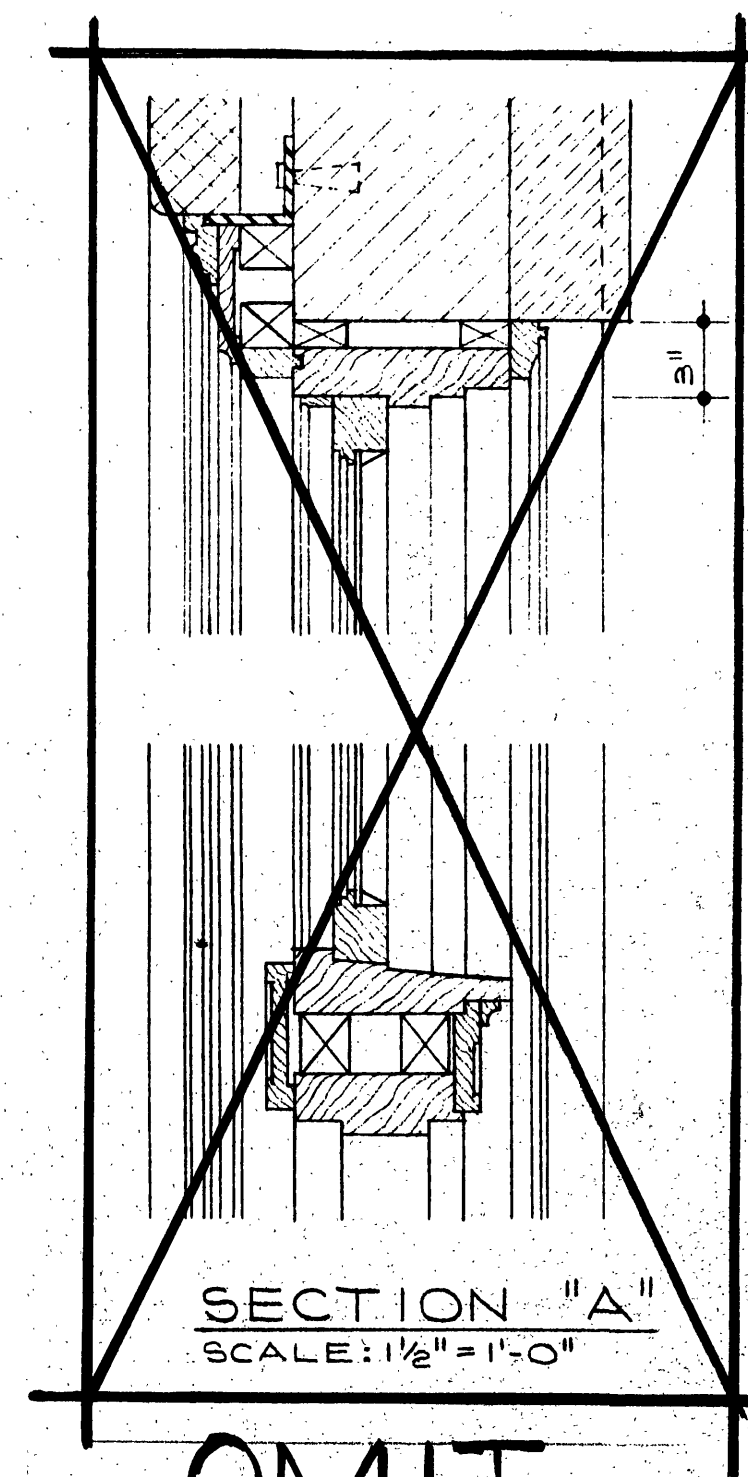


SECTION "A"

OMIT

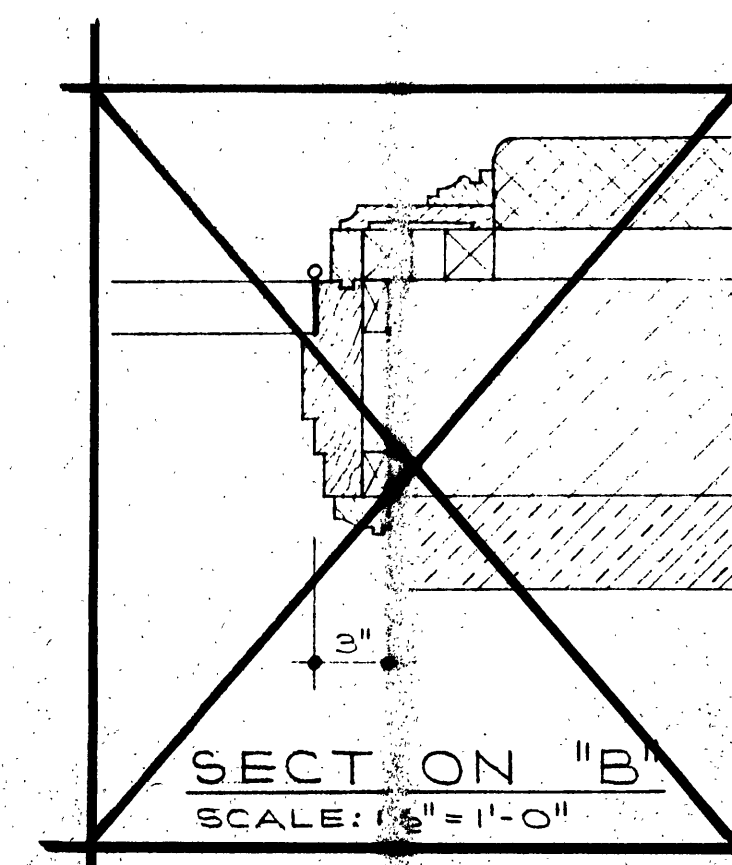


SECTION "B"

OMIT

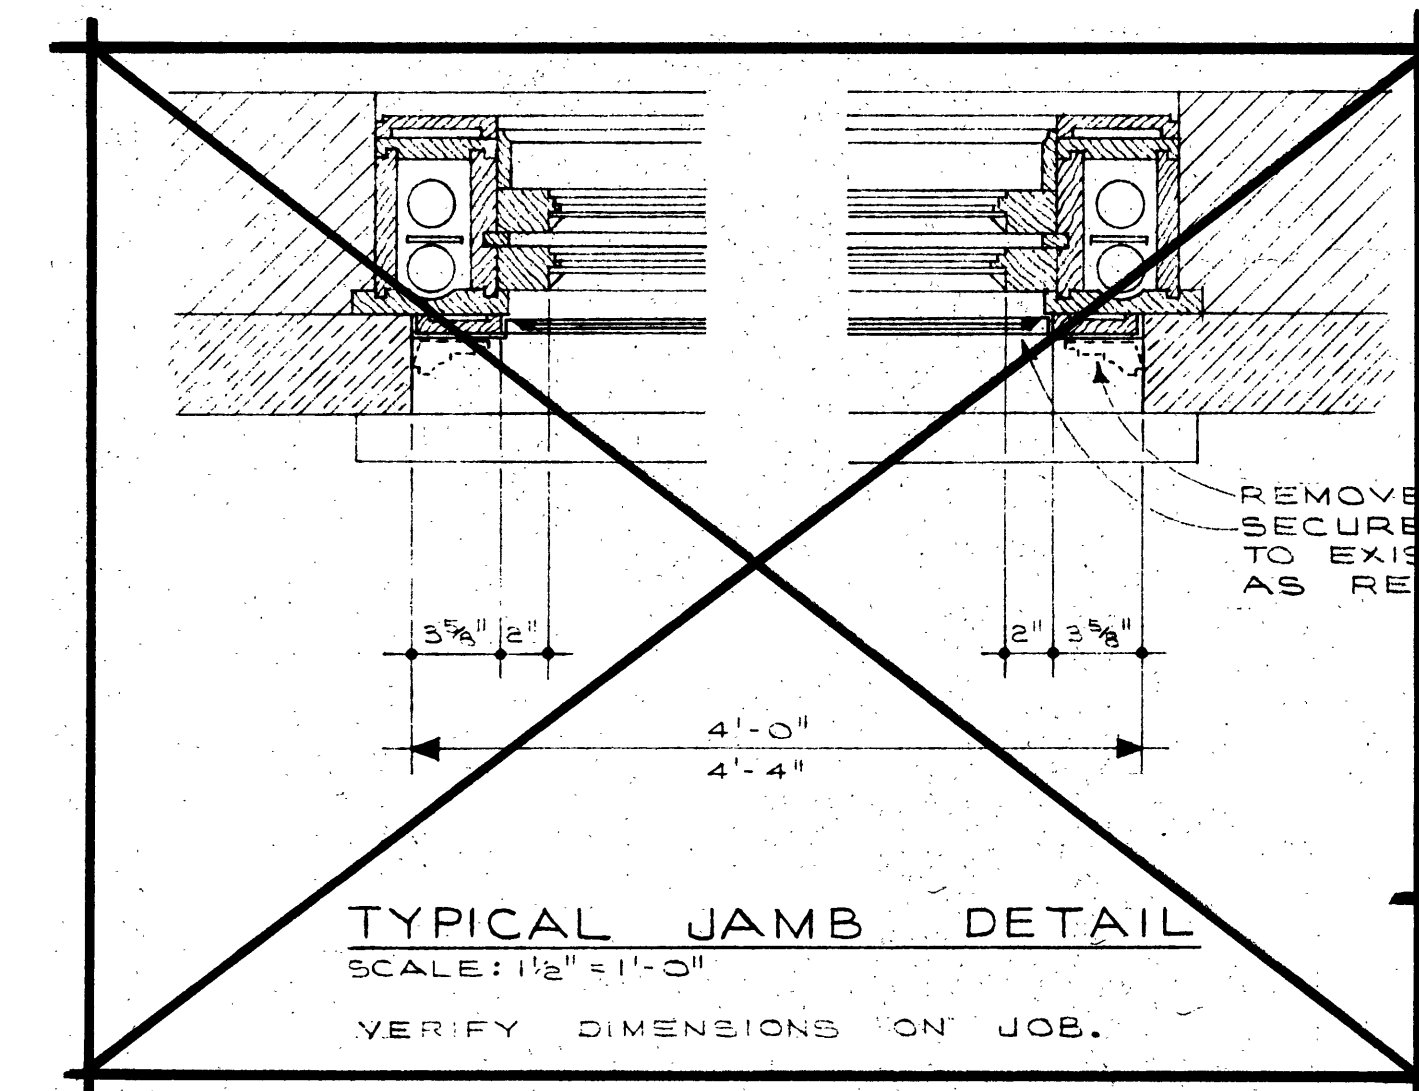

TYPICAL JAMB DETAIL
SCALE: 1 1/2" = 1'-0"
VERIFY DIMENSIONS ON JOB.

OMIT

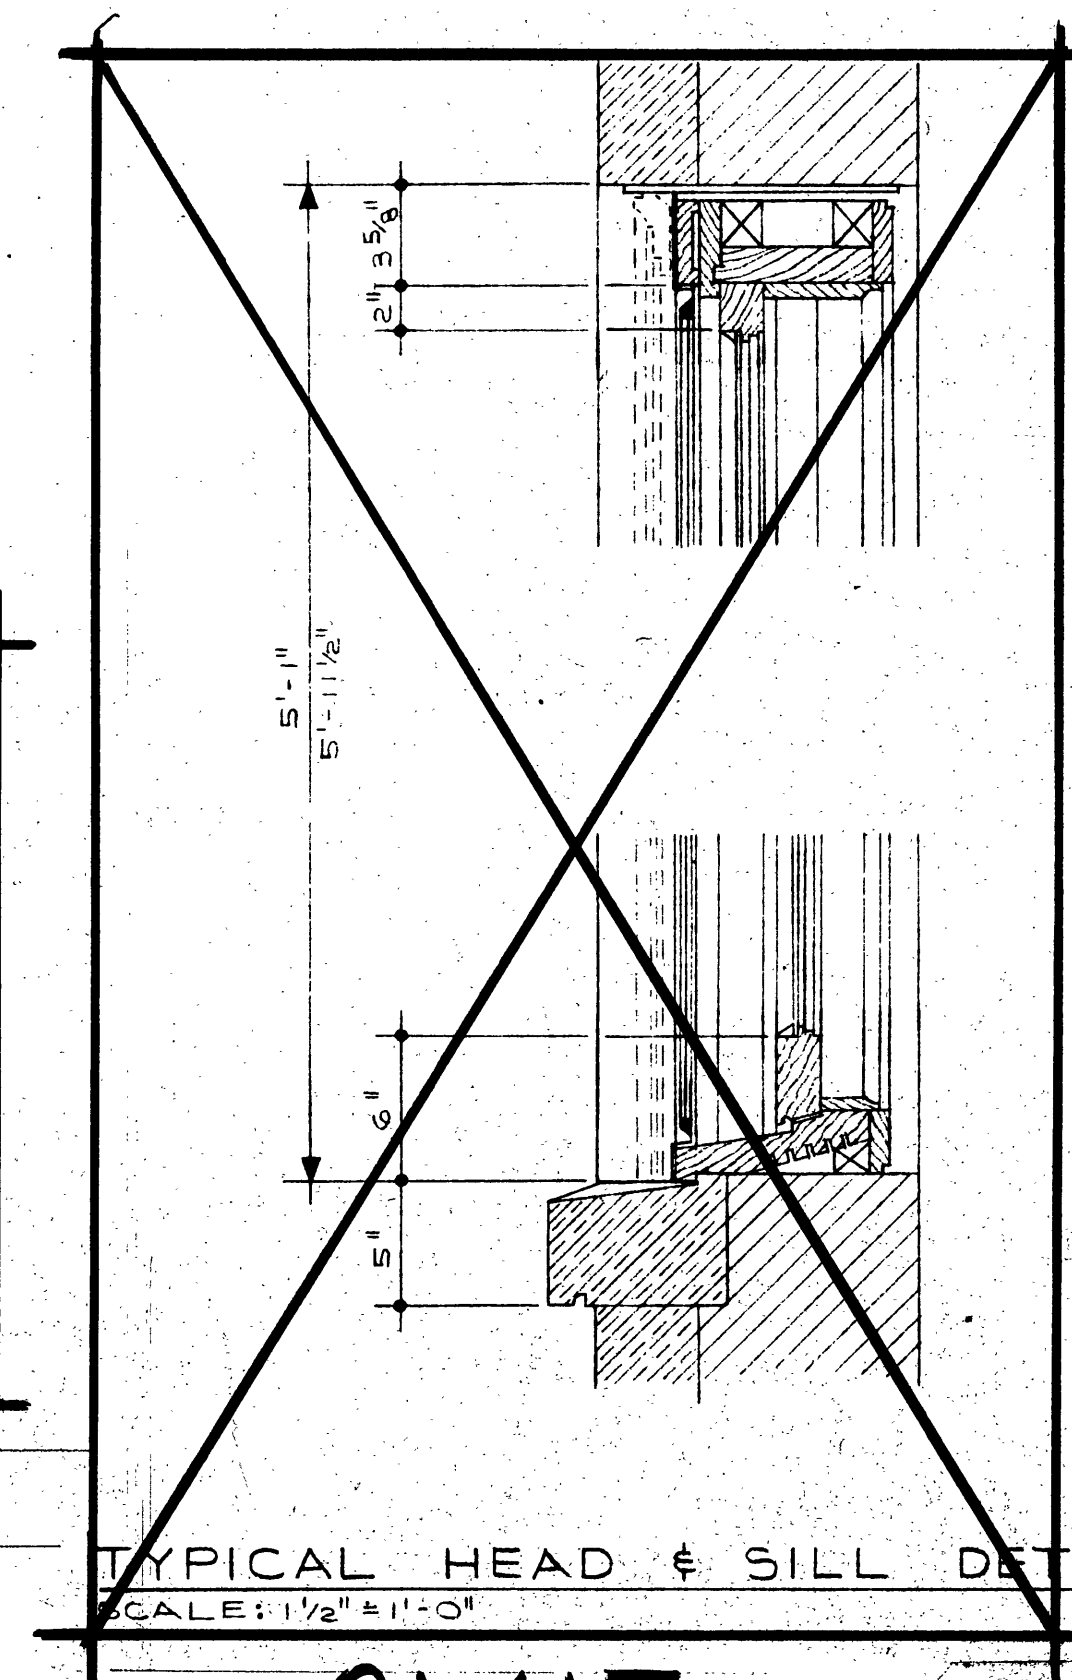

TYPICAL HEAD & SILL DETAIL
SCALE: 1 1/2" = 1'-0"

OMIT

TYPICAL WINDOW DIMENSIONS			
TYPE	JAMB	DIMENSIONS	HEAD & SILL
1 & 1A	-	4'-0"	5'-1"
2	-	4'-4"	5'-11 1/2"
3	-	4'-4"	5'-1"

NOTE:
PAINT AREAS INDICATED WITH (P)

REVISION	DATE	DESCRIPTION	BY	APP.
DESIGNED <i>SAM</i>		FRONT AND REAR ELEVATIONS CARVINS COVE FILTER PLANT		
DRAWN <i>RSM</i>				
CHECKED <i>GRC</i>				
APPROVED				
SUBMITTED		EXTERIOR PAINTING		
Mattern and Craig CONSULTING ENGINEERS ROANOKE, VIRGINIA			SCALE: NOTED	COMM. NO. 567
			DATE: DEC. 1985	SHEET 3