


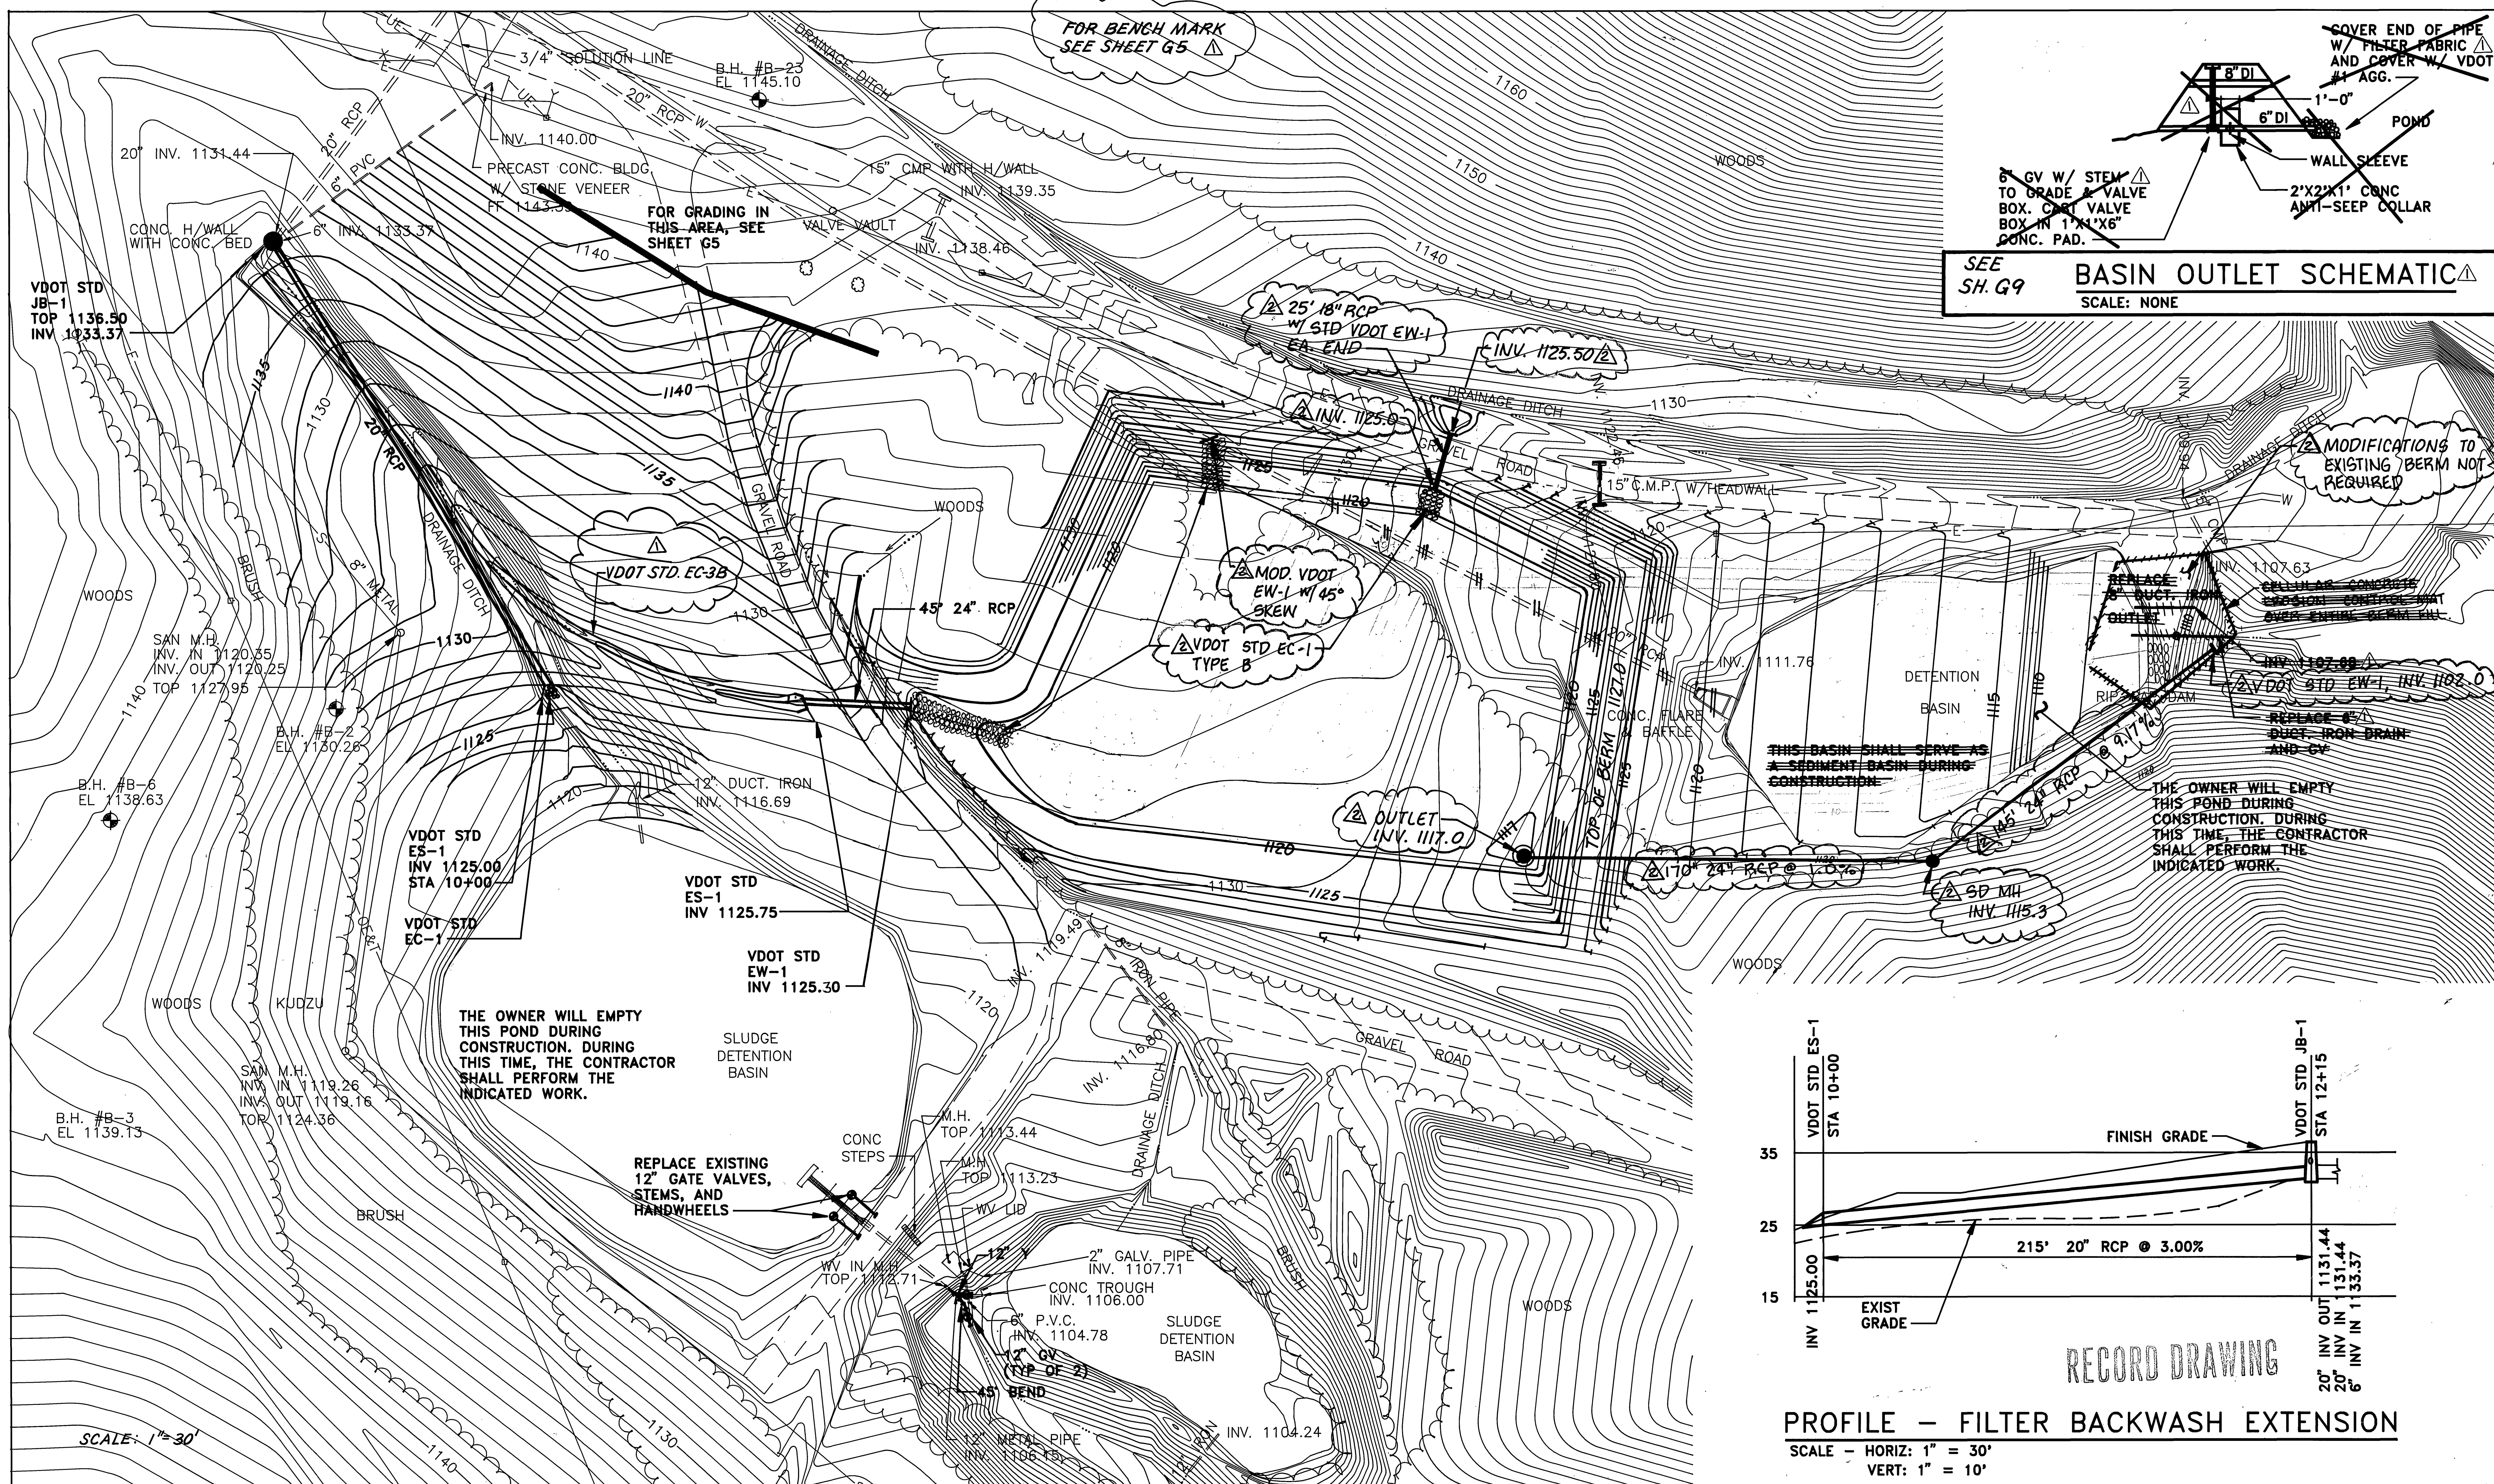

MATTERN & CRAIG CONSULTING ENGINEERS • SURVEYORS ROANOKE VIRGINIA	DESIGNED: RWB			REV.	DATE	DESCRIPTION	BY	APP.	CARVINS COVE FILTER PLANT IMPROVEMENTS – PHASE I ROANOKE, VIRGINIA	DATE MARCH 1992
	DRAWN: FMP			1	12/10/92	ROANOKE CO. COMMENTS C.O.#1	WCB	SWH		COMM. NO. 1138
ALVORD, BURDICK & HOWSON ENGINEERS CHICAGO	CHECKED: SWH			2	2/9/93	REVISIONS TO DETENTION BASIN	TAM	SWH	SHEET G6	
GENERAL MODIFICATIONS TO SLUDGE DETENTION BASINS										