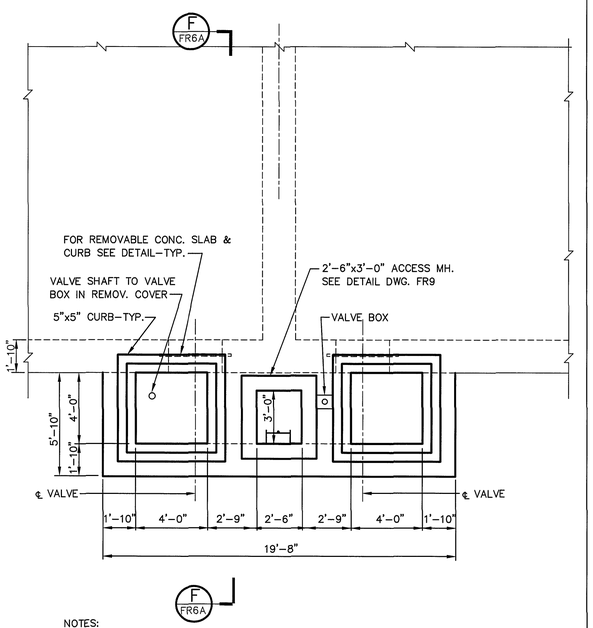

NOTES:
1. FOR RESERVOIR, PIPE DIMENSIONS, DETAILS AND NOTES NOT SHOWN SEE DRAWING FR6.

RESERVOIR EFFLUENT VALVE VAULT SECTIONAL PLAN

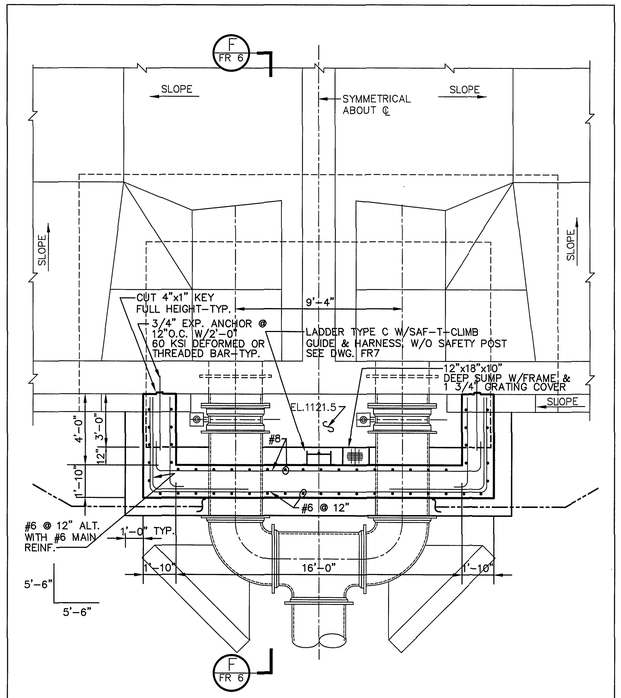

RESERVOIR EFFLUENT VALVE VAULT PLAN

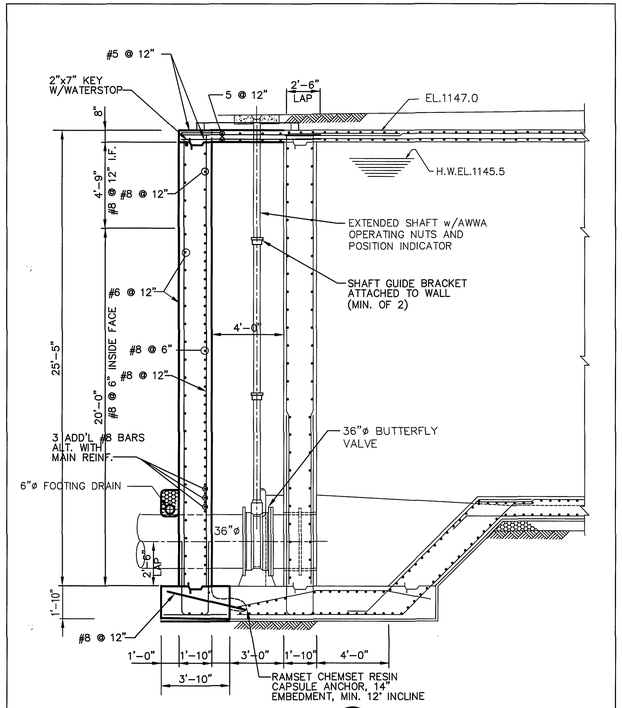

SECTION F/FR6A

DRAWING OF RECORD
DATE: SEP 30 1997

SHEET NO. FR6A (REFER TO SHEET NO. FR6)