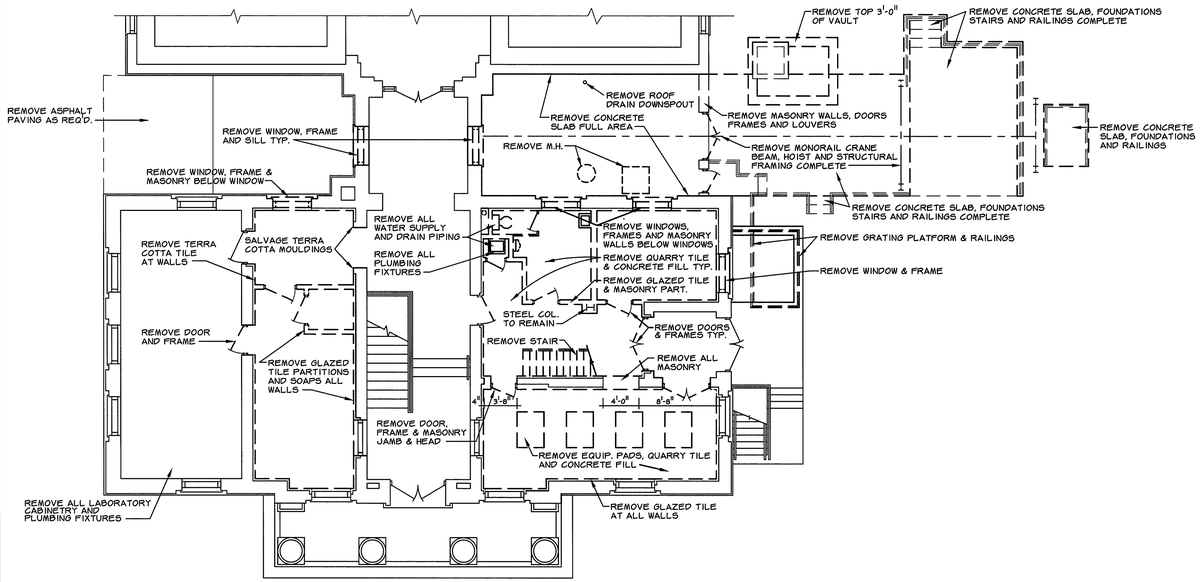

PLAN AT EL. 1157.5'

SCALE: 0 4'-0" 8'-0" 16'-0"

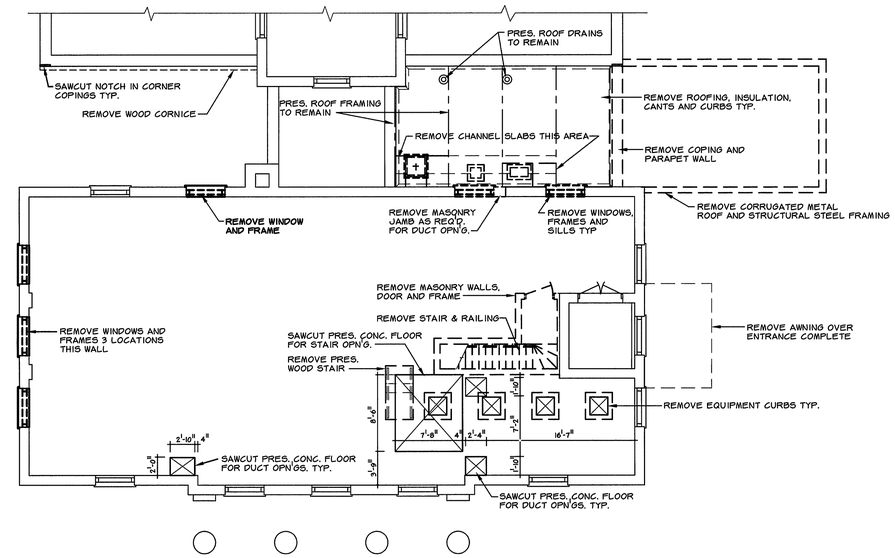

PLAN AT EL. 1169.5'

SCALE: 0 4'-0" 8'-0" 16'-0"

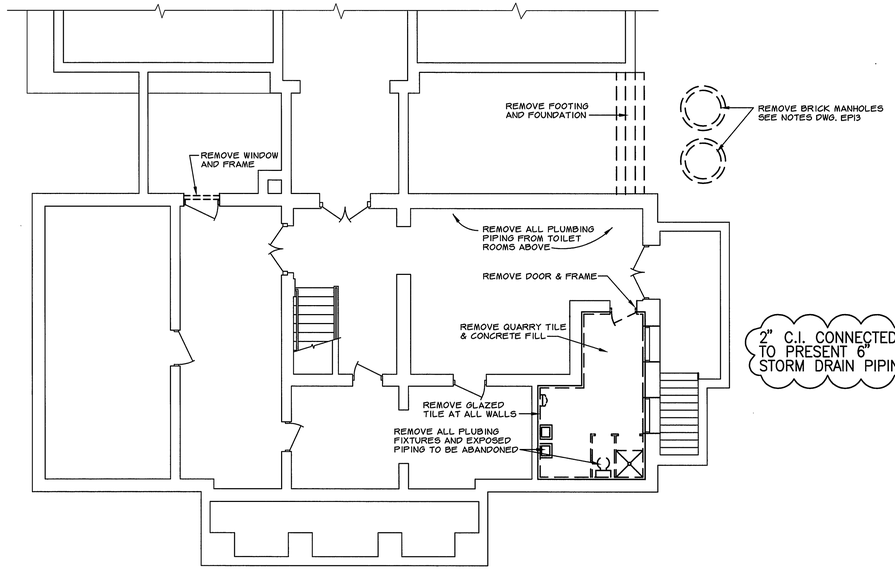

PLAN AT EL. 1146.5'

SCALE: 0 4'-0" 8'-0" 16'-0"

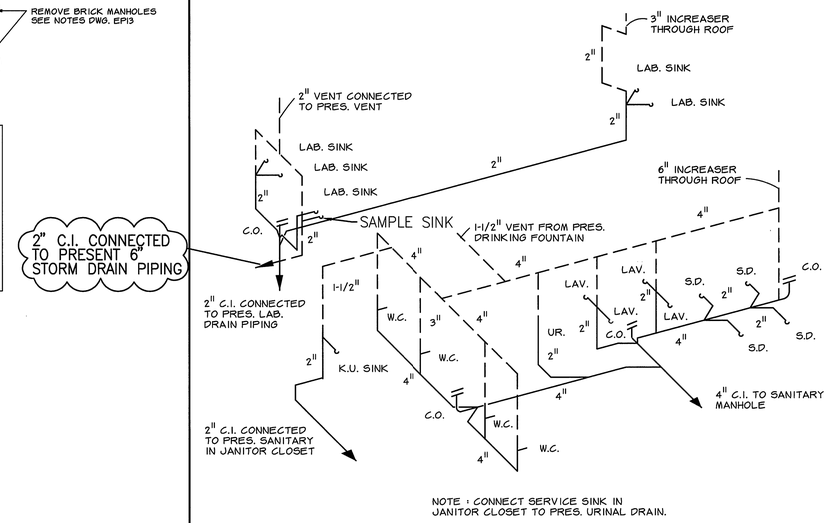

NOTE: CONNECT SERVICE SINK IN JANITOR CLOSET TO PRES. URINAL DRAIN.

SANITARY PIPING SCHEMATIC

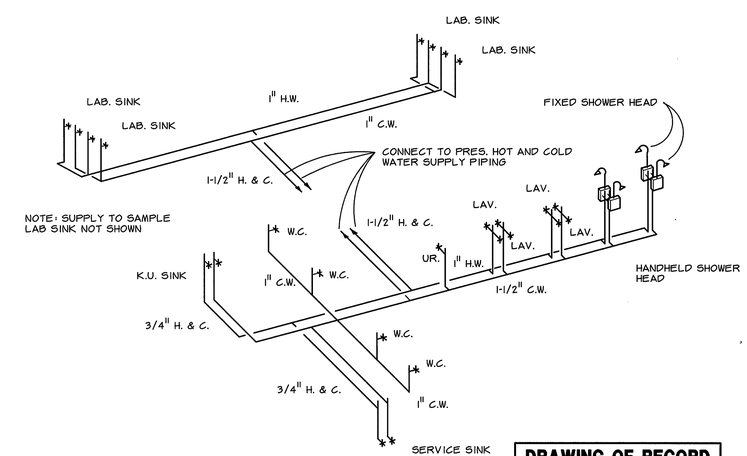

DRAWING OF RECORD
DATE: SEP 30 1997

POTABLE WATER SCHEMATIC

MATTERN & CRAIG CONSULTING ENGINEERS • SURVEYORS ROANOKE VIRGINIA	DESIGNED:		COMMONWEALTH OF VIRGINIA YA-TAI LIN NO. 022786 PROFESSIONAL ENGINEER
ALVORD, BURDICK & HOWSON ENGINEERS CHICAGO	DRAWN: CHECKED:		

REV.	DATE	DESCRIPTION	BY	APP.

CARVINS COVE FILTER PLANT IMPROVEMENTS – PHASE I

ROANOKE, VIRGINIA

ADMINISTRATION BUILDING

DEMOLITION PLANS AND SCHEMATICS

DATE: APRIL 1992

COMM. NO. 9130

SHEET A2

PLAN NO. 6199