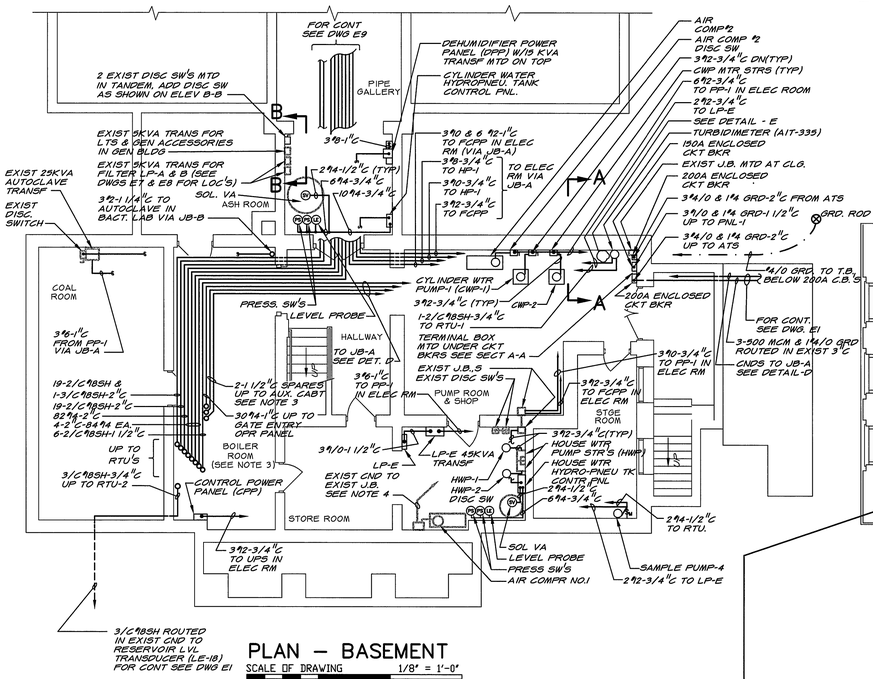

PLAN – BASEMENT

SCALE OF DRAWING 1/8" = 1'-0"

8' 6' 4' 2' 0 8' 16'

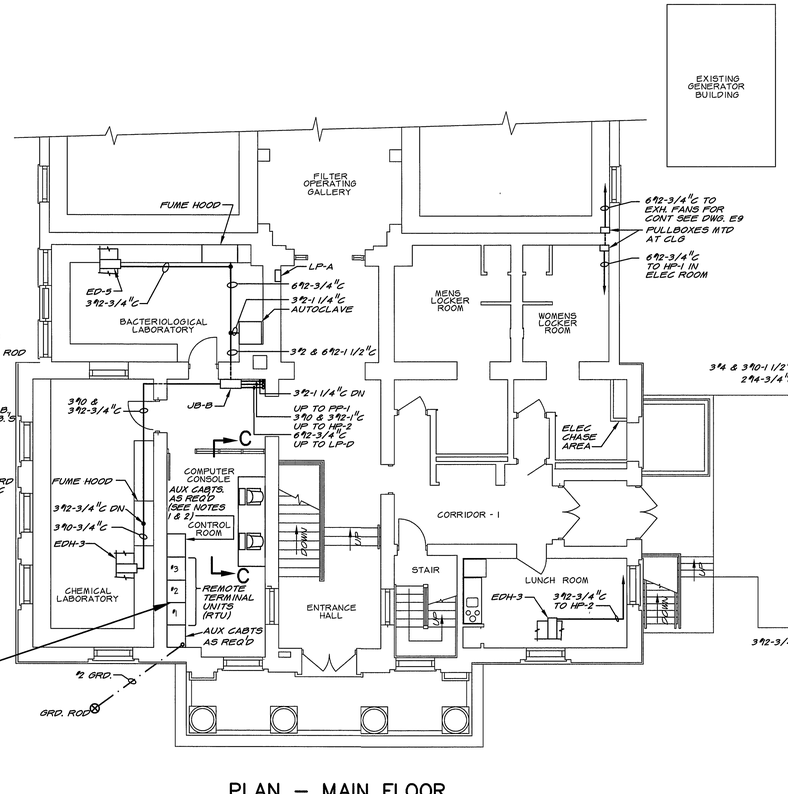

PLAN – MAIN FLOOR

SCALE OF DRAWING 1/8" = 1'-0"

8' 6' 4' 2' 0 8' 16'

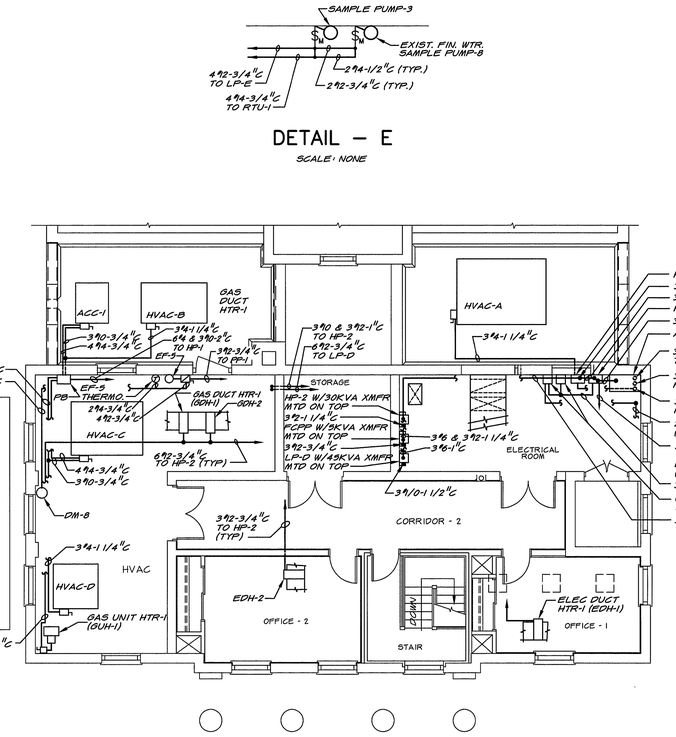

DETAIL – E

SCALE: NONE

PLAN – SECOND FLOOR

SCALE OF DRAWING 1/8" = 1'-0"

8' 6' 4' 2' 0 8' 16'

REFER TO SHEET NO.E7A FOR CHANGES IN THIS AREA

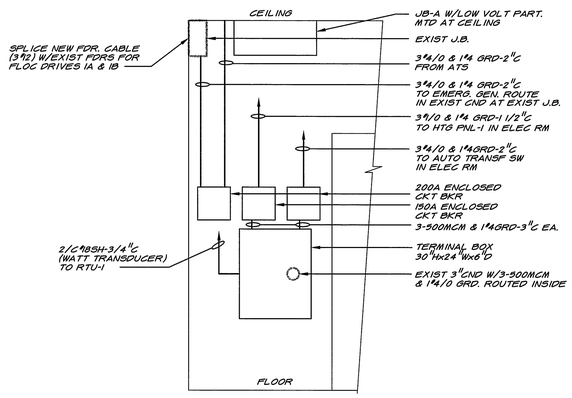

ELEVATION A–A

SCALE: NONE

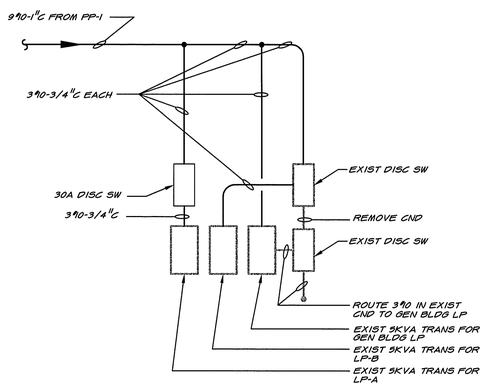

ELEVATION B–B

SCALE: NONE

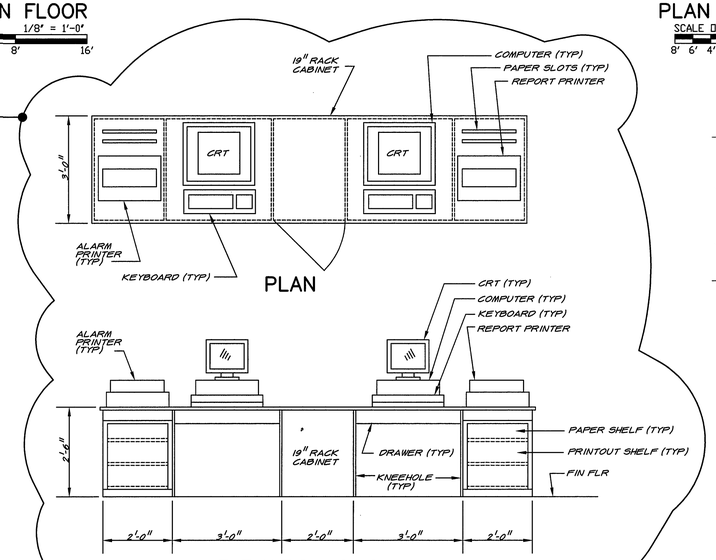

ELEVATION C–C

SCALE OF DRAWING 1/2" = 1'-0"

2' 1' 0 2' 4'

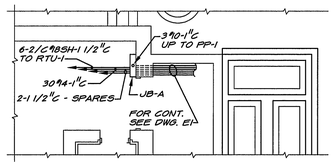

DETAIL – D

SCALE OF DRAWING 1/8" = 1'-0"

8' 6' 4' 2' 0 8' 16'

NOTES

1. STUB UP AND CAP 1 1/2" SPARE CNDS 6" ABOVE FIN FLR IN AUX. CABINET FOR FUTURE USE.
2. MOUNT GATE ENTRY OPR. PANEL ON FACE OF AUX. CABINET.
3. EXISTING BOILER AND VAC. CONDENSATE PUMPS IN BOILER ROOM NOT SHOWN. VERIFY LOCATION AND FIELD ROUTE POWER FEEDERS FROM LP-E.
4. ROUTE 3#0 (FROM PP-1) IN EXIST. CND TO EQUIPMENT.

DRAWING OF RECORD
DATE: SEP 30 1997

MATTERN & CRAIG CONSULTING ENGINEERS • SURVEYORS ROANOKE VIRGINIA	DESIGNED: RRA		COMMONWEALTH OF VIRGINIA YA-TAI LIN NO. 022786 PROFESSIONAL ENGINEER	REV.	DATE	DESCRIPTION	BY / APP.
	DRAWN: KGP						
ALVORD, BURDICK & HOWSON ENGINEERS CHICAGO	CHECKED: RRA						

CARVINS COVE FILTER PLANT IMPROVEMENTS – PHASE I
ROANOKE, VIRGINIA

ADMINISTRATION BUILDING
ELECTRICAL PLANS

DATE APRIL 1992
COMM. NO. 9130
SHEET E7

PLAN NO. 6199