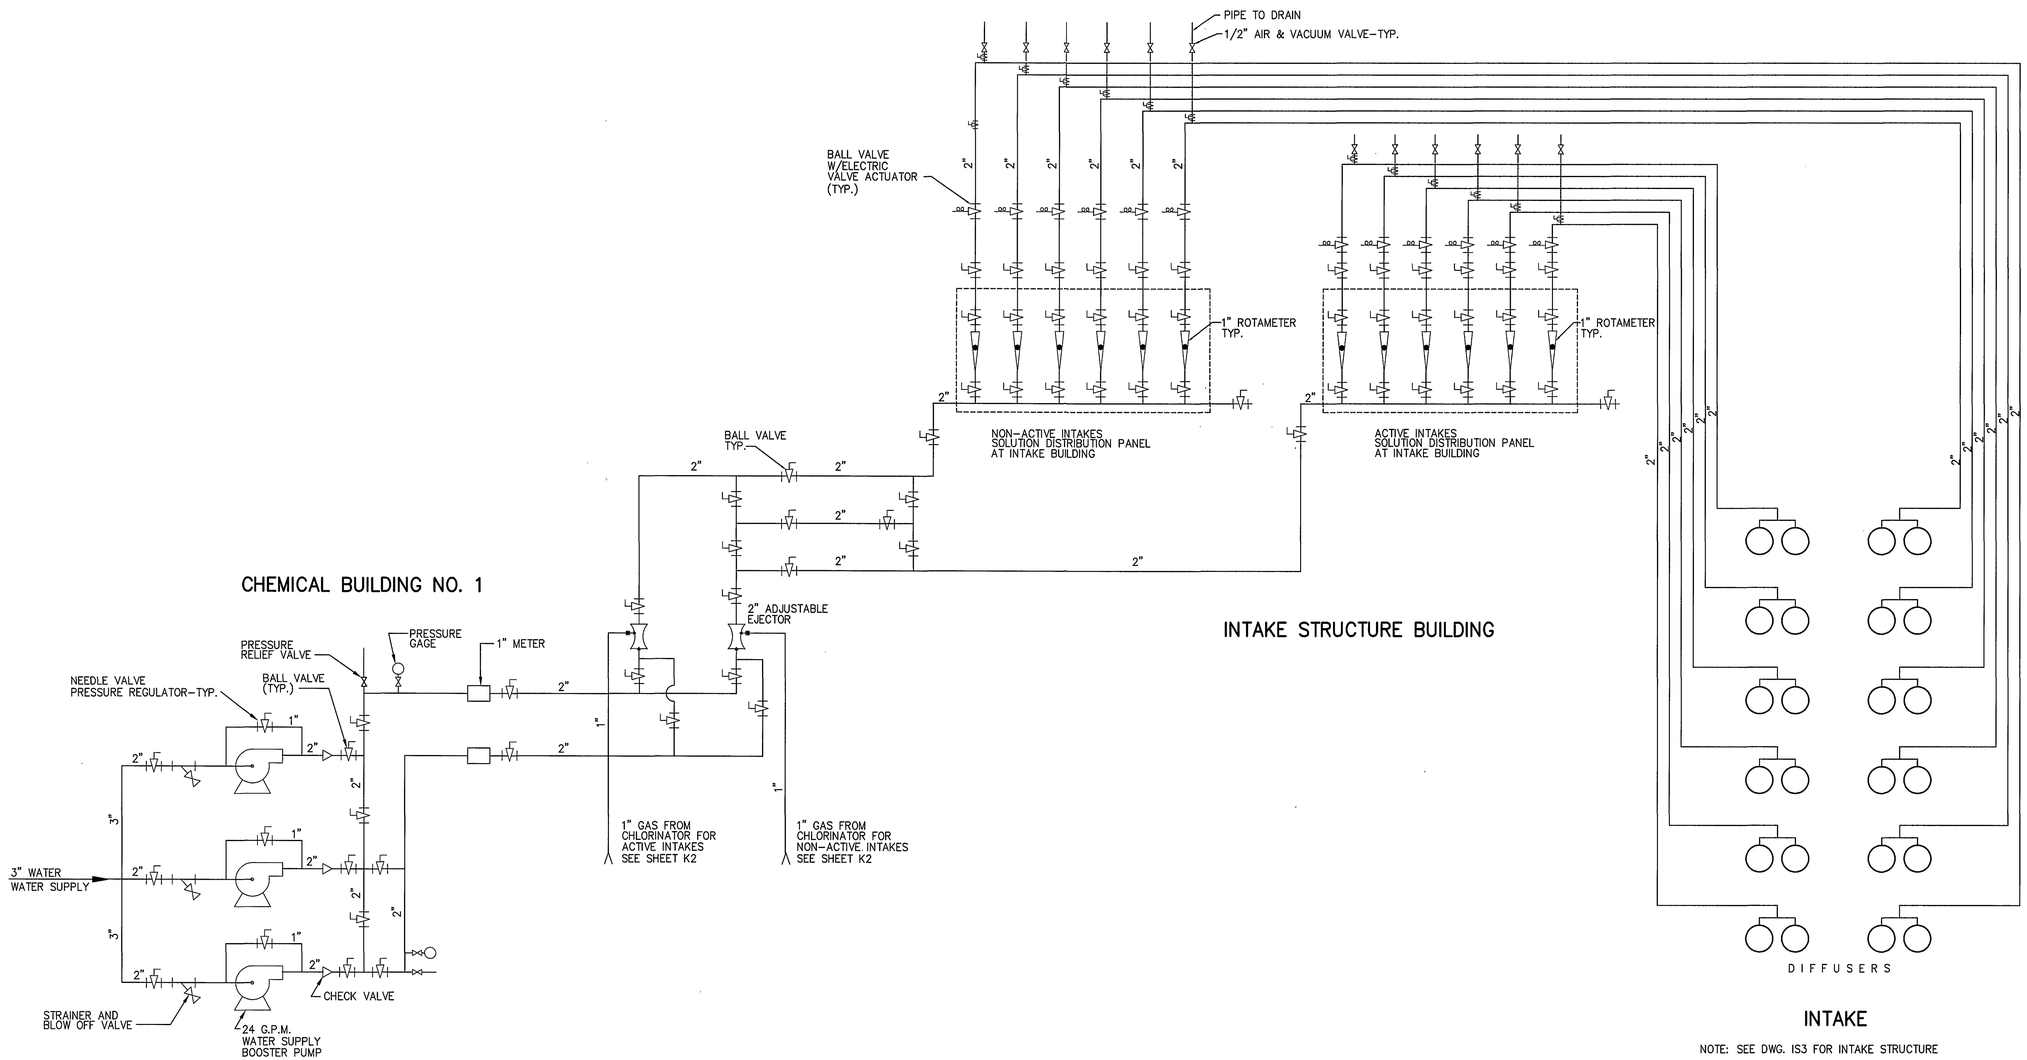

PRECHLORINATION SYSTEM

INTAKE

NOTE: SEE DWG. IS3 FOR INTAKE STRUCTURE

NOTE: SEE DWG. K1 FOR CHEMICAL BUILDING NO. 1

DRAWING OF RECORD
DATE: SEP 30 1997

MATTERN & CRAIG CONSULTING ENGINEERS • SURVEYORS ROANOKE VIRGINIA	DESIGNED: K.H.C.		COMMONWEALTH OF VIRGINIA YA-TAI LIN NO. 022786 PROFESSIONAL ENGINEER	REV.	DATE	DESCRIPTION	BY	APP.
	DRAWN: R.T.			NEW	5/12/93	SCHEMATIC FOR PRECHLORINATION SYSTEM	KHC	
ALVORD, BURDICK & HOWSON ENGINEERS CHICAGO	CHECKED: Y.T.L.							

CARVINS COVE FILTER PLANT IMPROVEMENTS – PHASE I
ROANOKE, VIRGINIA

PRECHLORINATION SYSTEM – SCHEMATIC

DATE DEC 1992
COMM. NO. 9130
SHEET K8