


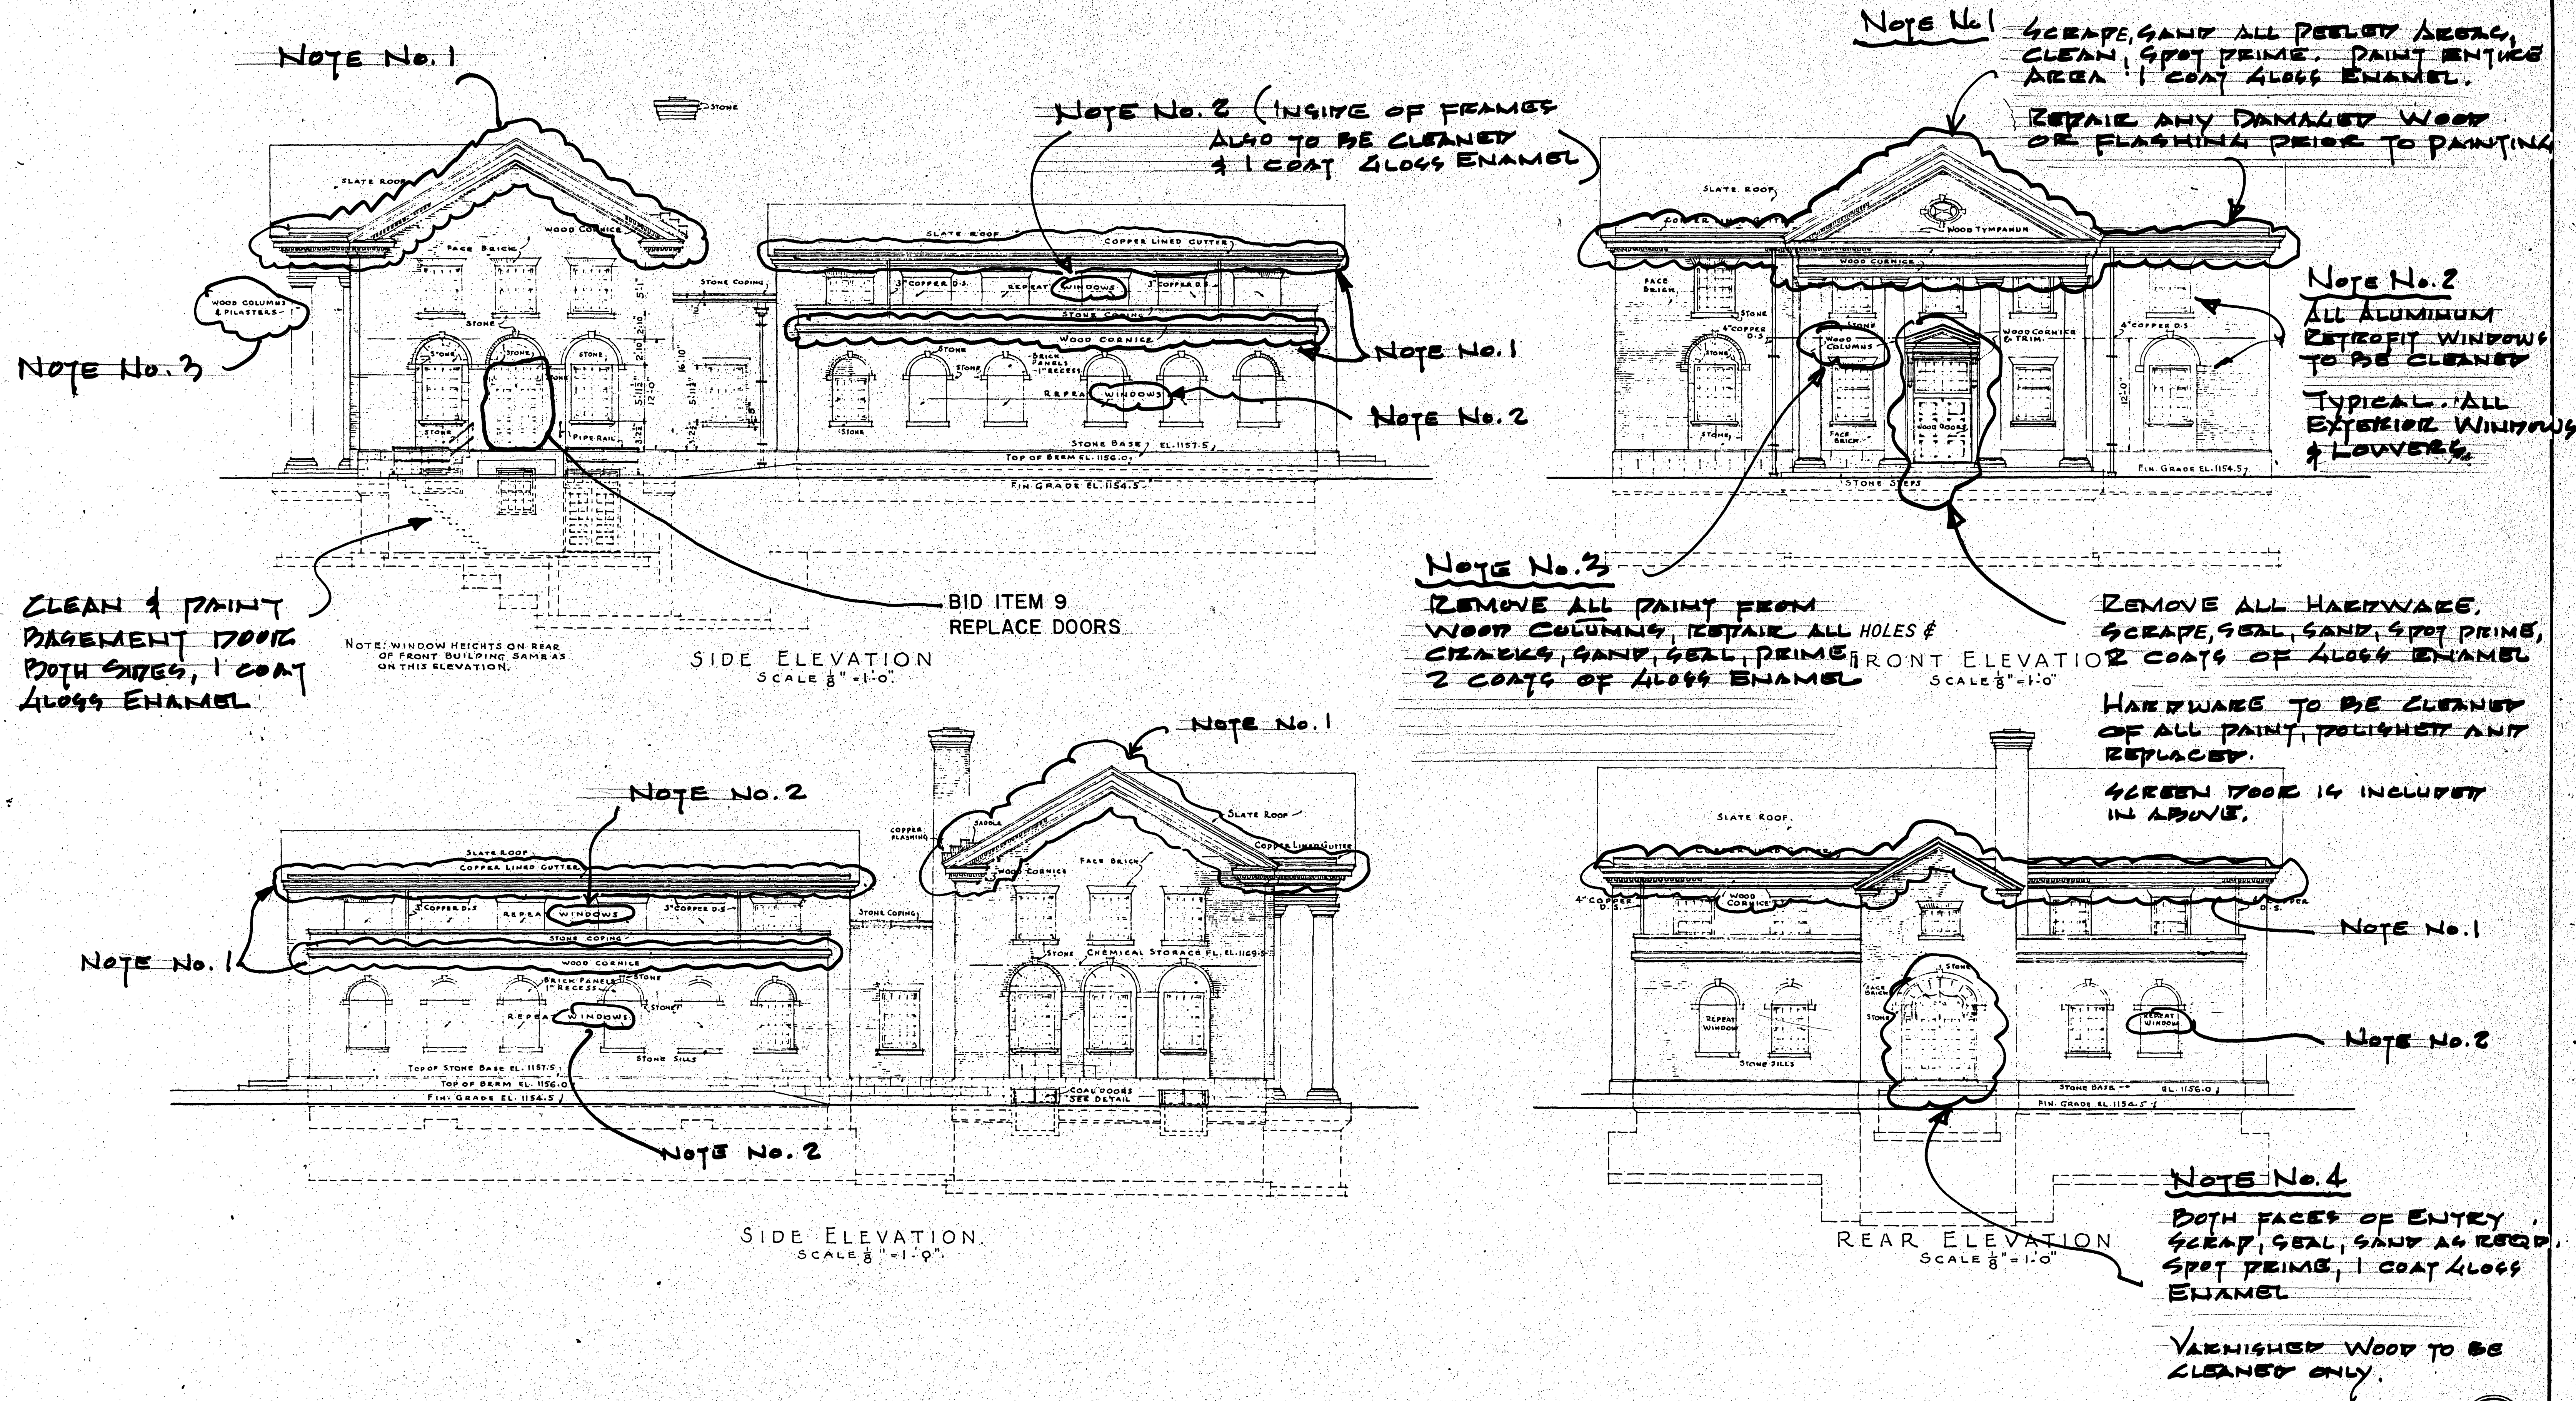

CONTRACT BID ITEMS 6 AND 7, AND 9

MATTEN & CRAIG CONSULTING ENGINEERS • SURVEYORS ROANOKE VIRGINIA	DESIGNED: RFP DRAWN: TAM CHECKED: SWH		REV	DATE	DESCRIPTION	BY	APP.	CARVINS COVE FILTER PLANT IMPROVEMENTS - PHASE I ROANOKE, VIRGINIA	DATE
									SEPT. 1994
ALVORD, BURDICK & HOWSON ENGINEERS CHICAGO								PAINTING	COMM. NO. 1138C0
									SHEET C08