
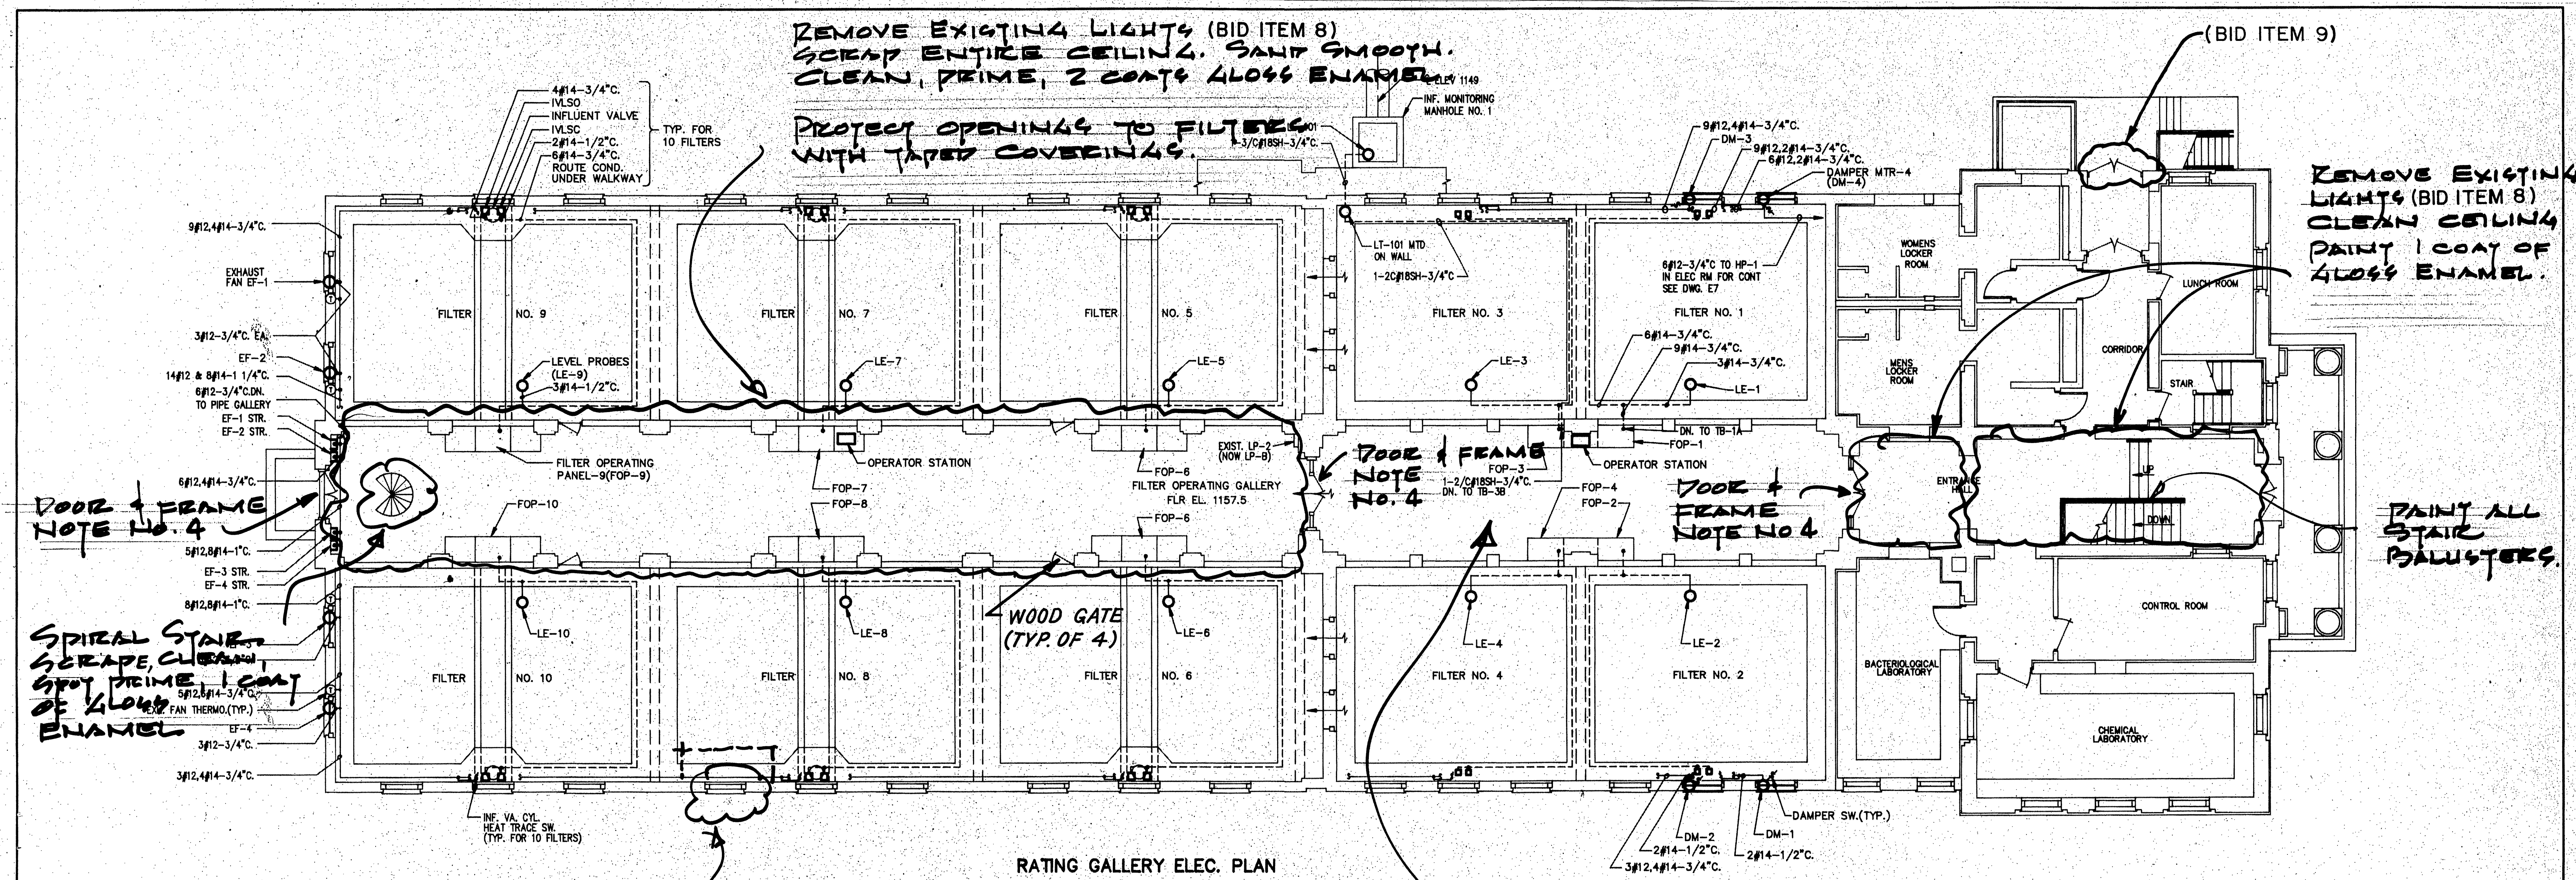


 

**CONTRACT BID ITEMS 6 AND 7
(UNLESS OTHERWISE NOTED)**

MATTERN & CRAIG CONSULTING ENGINEERS • SURVEYORS ROANOKE VIRGINIA	DESIGNED:			REV.	DATE	DESCRIPTION	BY	APP.	CARVINS COVE FILTER PLANT IMPROVEMENTS – PHASE I ROANOKE, VIRGINIA	DATE
	DRAWN:									
ALVORD, BURDICK & HOWSON ENGINEERS CHICAGO	CHECKED:									