
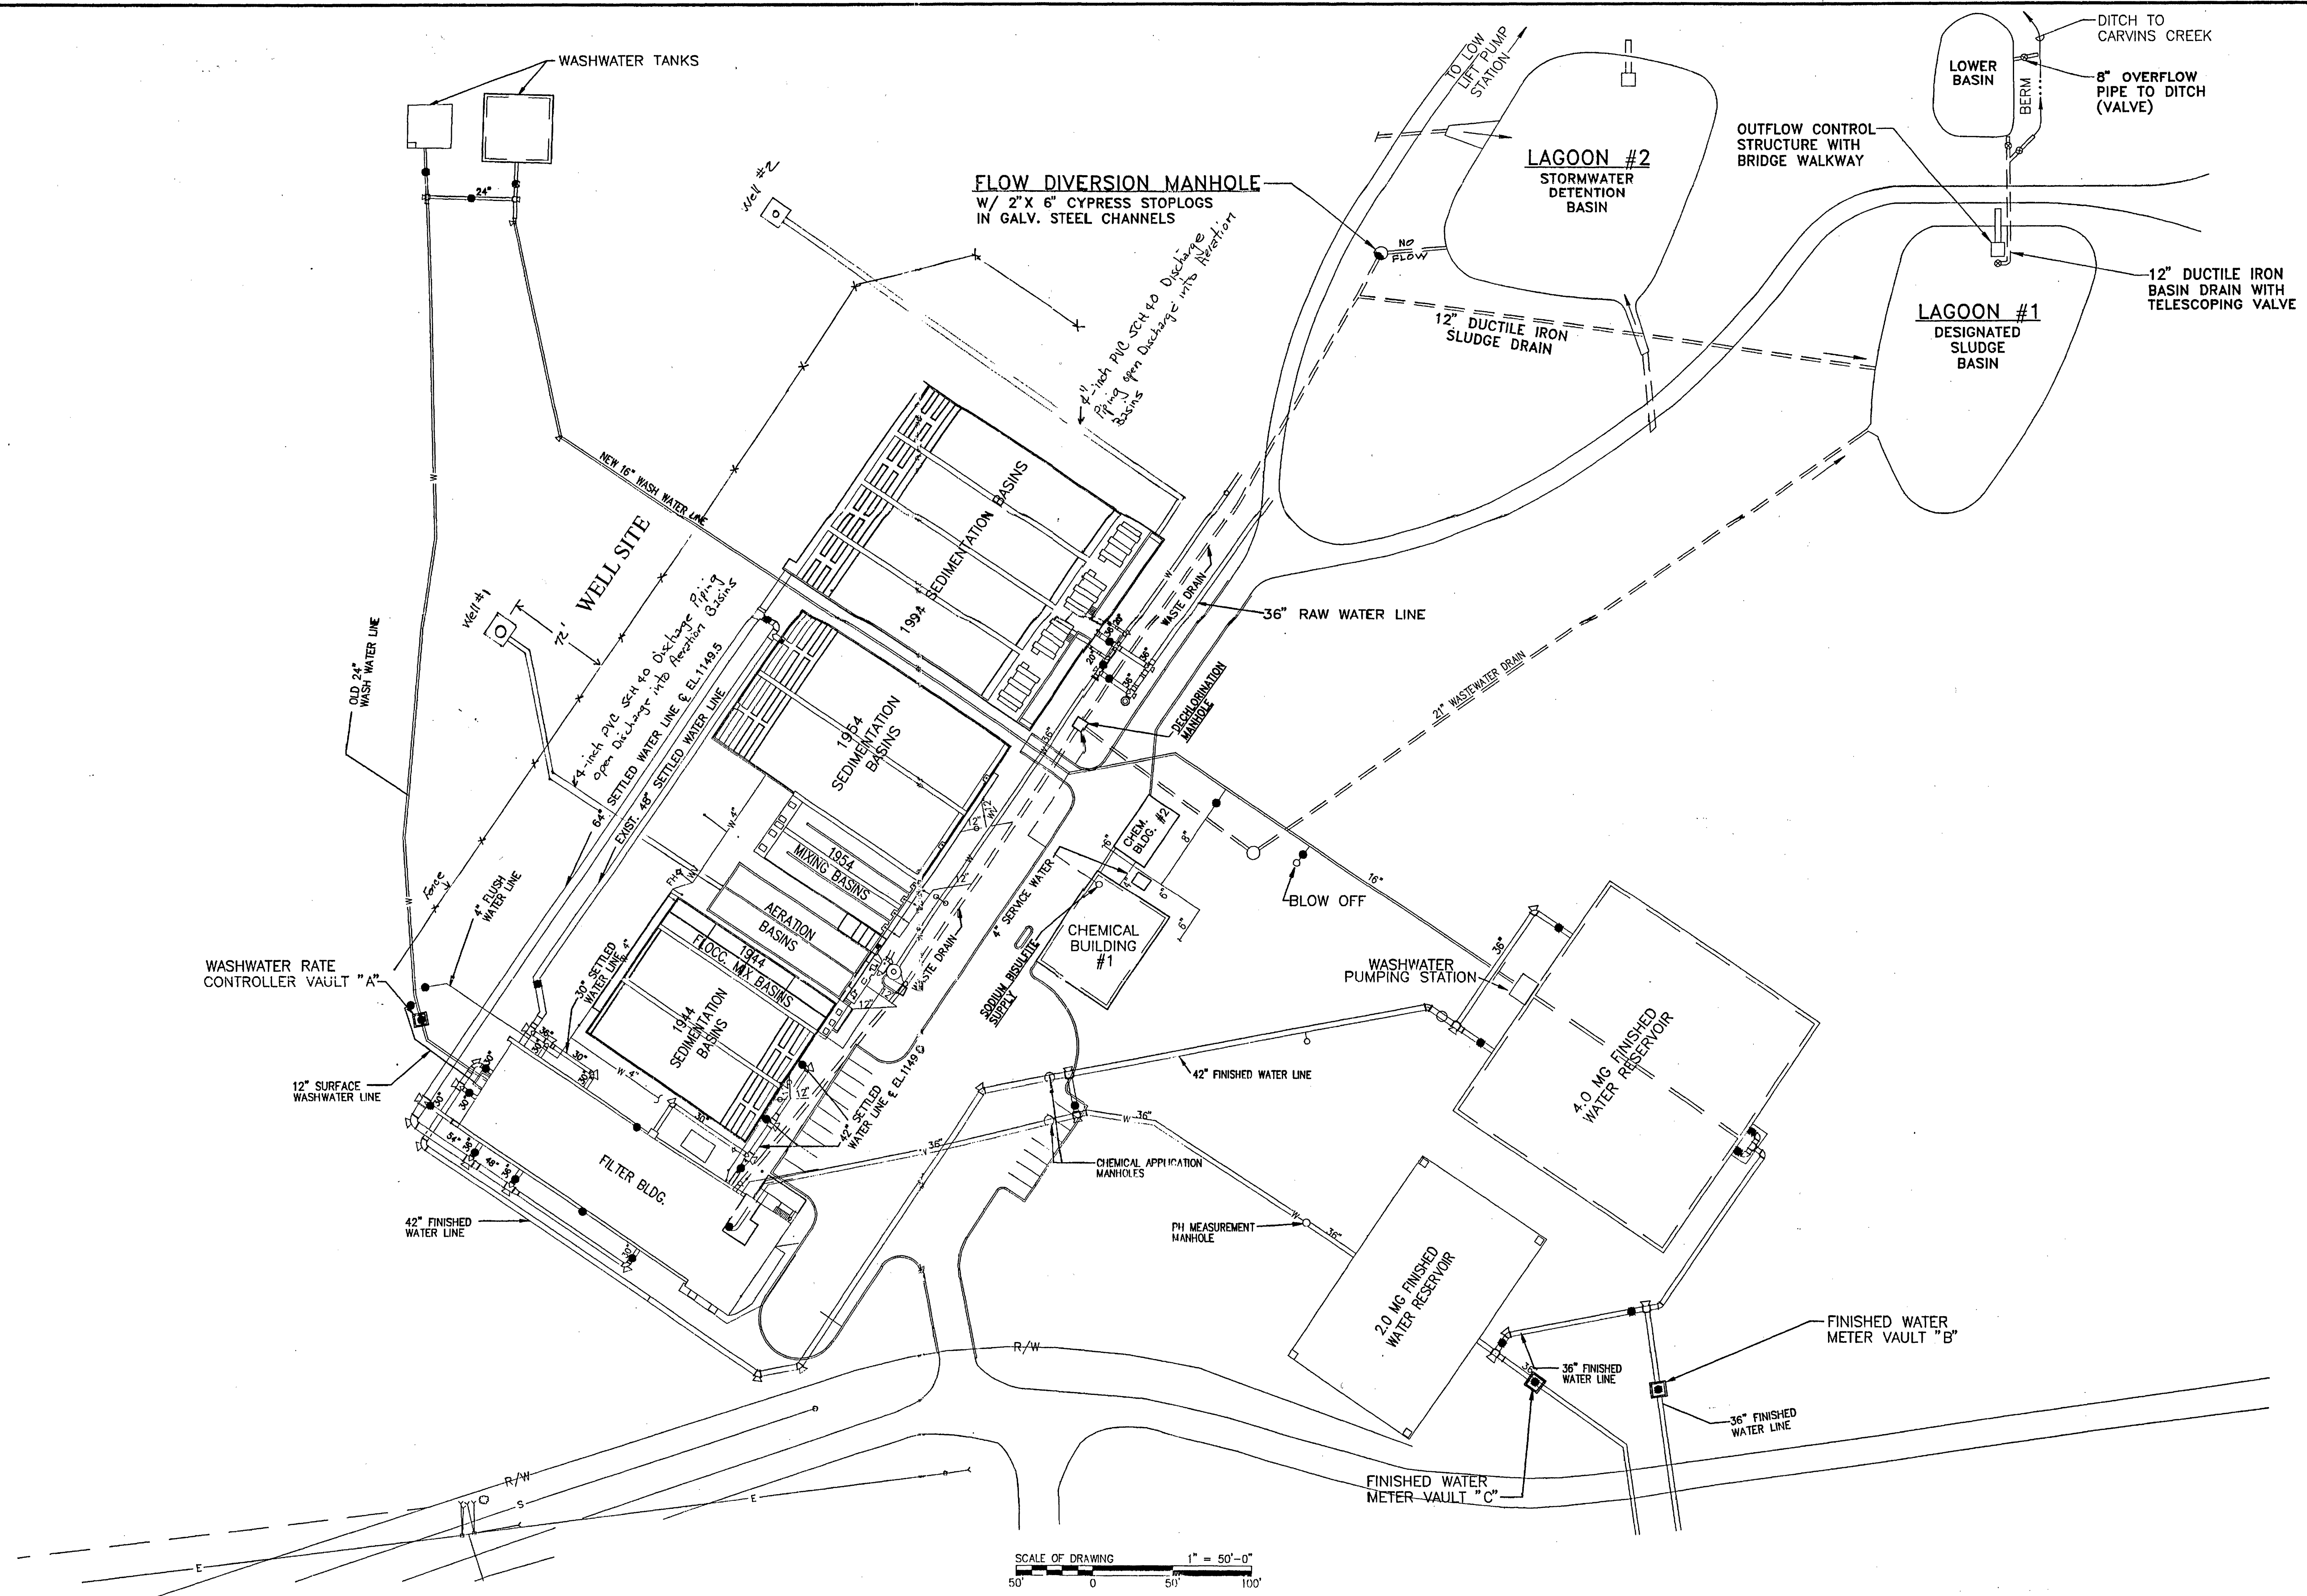


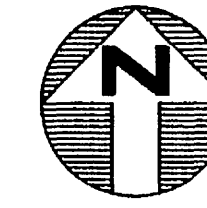

SCALE OF DRAWING 1" = 50'-0"

MATTERN & CRAIG CONSULTING ENGINEERS • SURVEYORS ROANOKE VIRGINIA	DESIGNED:			REV.	DATE	DESCRIPTION	BY	APP.	CARVINS COVE FILTER PLANT ROANOKE, VIRGINIA	DATE APRIL 1992
	DRAWN:									COMM NO 9130
	CHECKED:									SHEET
ALVORD, BURDICK & HOWSON ENGINEERS CHICAGO									WELL SITE-CCFP PW9/99	