
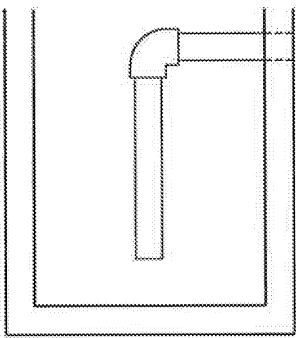


NOTES:
1. PIPE WAS BEDDED IN SAND.

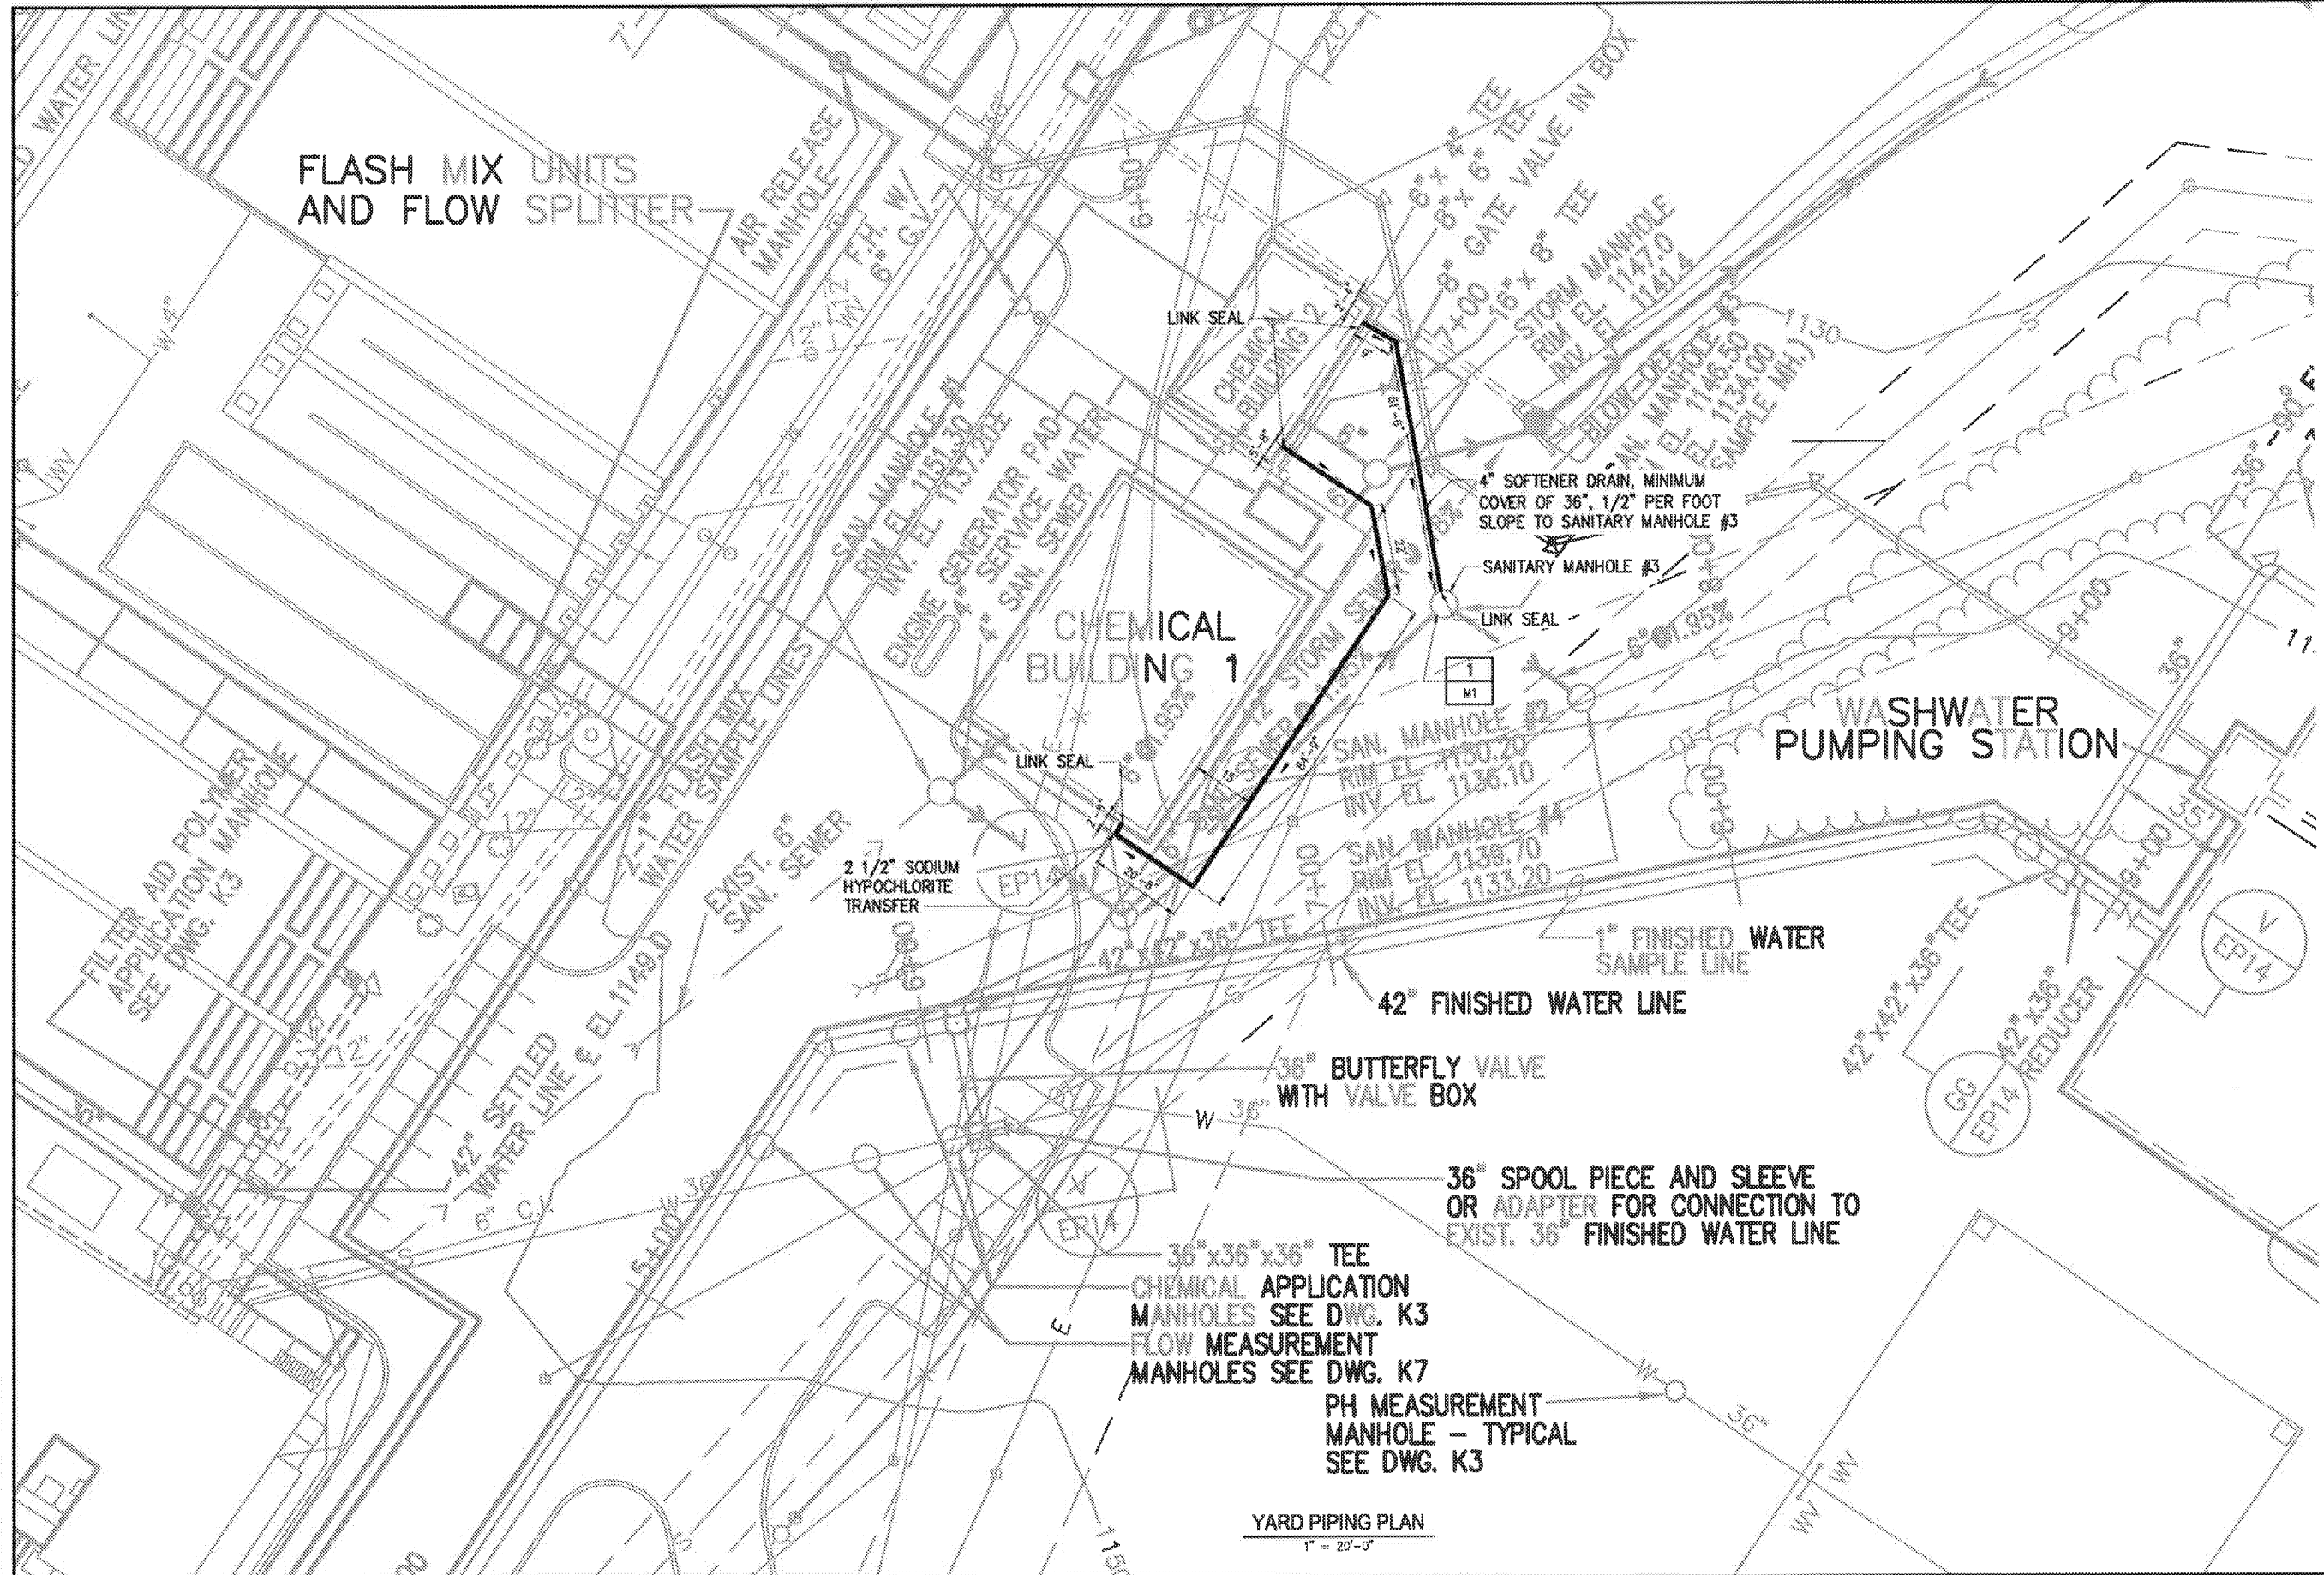

SANITARY MANHOLE 3

1
M1

YARD PIPING PLAN
1" = 20'-0"

1" = 20'-0"

--	--	