NOTES:

1. INSTALLATION OF MAGNETIC FLOW METERS SHALL CONFORM TO MANUFACTURER'S RECOMMENDED MINIMUM RUN OF STRAIGHT PIPE UPSTREAM AND DOWNSTREAM. UNLESS OTHERWISE SPECIFIED, PROVIDE 5 PIPE DIAMETERS UPSTREAM AND 3 PIPE DIAMETERS DOWNSTREAM.

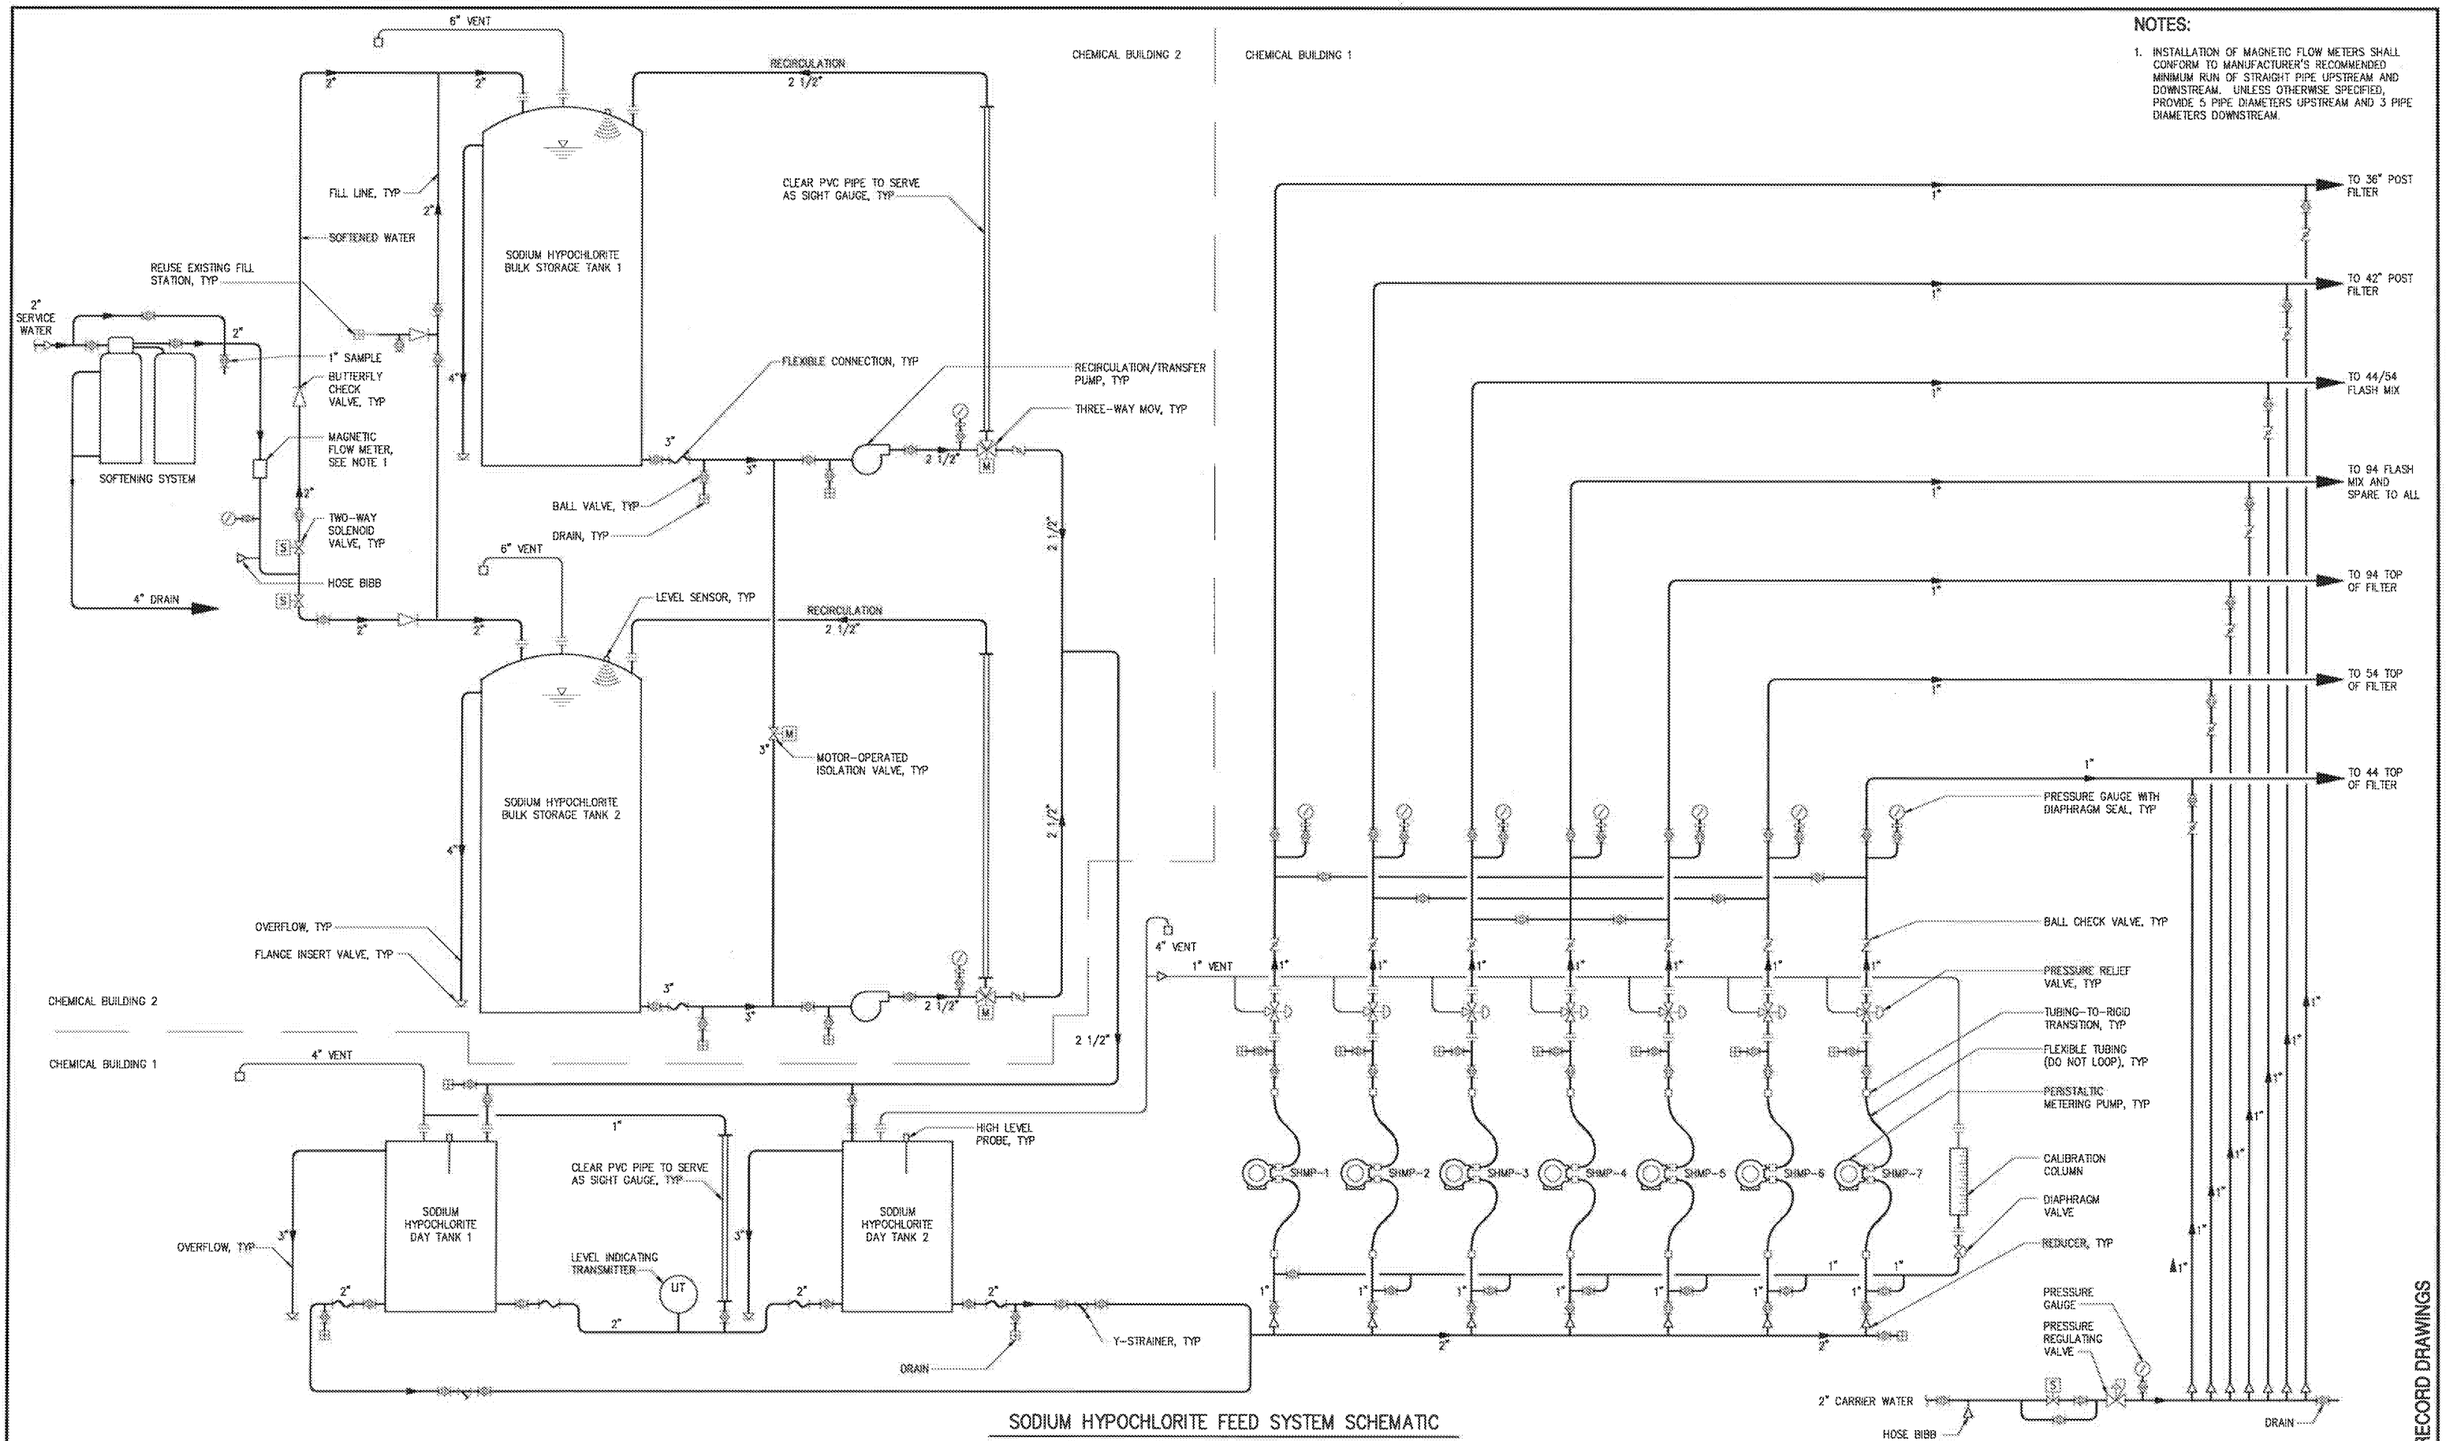

SODIUM HYPOCHLORITE FEED SYSTEM SCHEMATIC

RECORD DRAWINGS

NO.	ISSUED FOR	DATE	BY
2	RECORD DRAWINGS	04/2015	ALS
1	FINAL DESIGN	09/2014	ALS

DESIGNED ABL
DRAWN KJO
CHECKED
PROJ.ENGR. ALS
APPROVED

COMMONWEALTH OF VIRGINIA ALAN L. STONE No. 24446 PROFESSIONAL ENGINEER

RECORD DRAWING

THIS DRAWING HAS BEEN MODIFIED TO REFLECT FIELD CHANGES REPORTED BY THE CONTRACTOR OR ANOTHER PARTY, BUT NOT VERIFIED BY THE CERTIFYING ENGINEER

THIS DOCUMENT ORIGINALLY ISSUED FOR CONSTRUCTION AND SEALED BY ALAN L. STONE, LIC NUMBER 24446

HAZEN AND SAWYER
Environmental Engineers & Scientists
4011 WestChase Boulevard, Suite 500
Raleigh, North Carolina 27607
License No. : C-0381

WESTERN VIRGINIA WATER AUTHORITY
ROANOKE, VIRGINIA

CARVINS COVE WATER TREATMENT FACILITY
DISINFECTION IMPROVEMENTS

SODIUM HYPOCHLORITE FEED SYSTEM SCHEMATIC

THE SCALE BAR SHOWN BELOW MEASURES ONE INCH LONG ON THE ORIGINAL DRAWING.

DATE OCTOBER 2014
H&S JOB NUMBER 31197-000
CONTRACT NUMBER 1
DRAWING NUMBER M100