


Load-

Carvins Cove
Valve Chamber
North Elevation
Not To Scale.

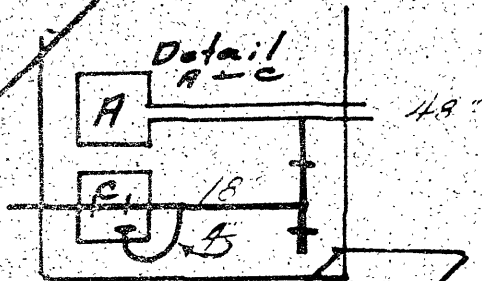

1176.7
1175.3
1170
1160
1150
1140
1130
1120
1118
1117
1115
1110

SP. 11-K6.4

18

18" Shore Cuts