


LIST OF FITTINGS			
NO.	NOMENCLATURE	MATERIAL	SIZE
1	NIPPLE	STAINLESS STEEL	1 1/2"
2	90° ELBOW	ST'L ST.	1 1/2"
3	NIPPLE	ST'L ST.	1 1/2"
5	UNION	ST'L ST.	1 1/2"
6	TEE	ST'L ST.	1 1/2"
7	NIPPLE	ST'L ST.	1 1/2"
8	BUSHING	ST'L ST.	1 1/2" TO 1 1/4"
9	NIPPLE	HARD RUBBER	1 1/4" X 2"
10	GATE VALVE	ST'L ST.	1 1/4"
10B	FLOOR STAND FOR VALVE		
11	90° ELBOW	HARD RUBBER	1 1/4"
12	NIPPLE	HARD RUBBER	1 1/4" X 3"
12B	FLOOR STAND FOR NIPPLE SAME AS FOR VALVE		
13	TEE	HARD RUBBER	1 1/4"
14	PRYEX EDUCTORS	RUBBER	1 1/2"
15	2 HOSE CLAMPS		
16	WATER HOSE AND 2 HOSE CLAMPS	RUBBER	1 1/2"
17	NIPPLE	HARD RUBBER	1 1/4" X 3"
18	WATER HOSE AND 2 HOSE CLAMPS	RUBBER	3/4"
19	NIPPLE	RED BRASS	1/2"
20	PRESSURE REDUCING VALVE	RED BRASS	1/2"
21	NIPPLE	RED BRASS	1/2"
22	VALVE, GLOBE	RED BRASS	1/2"
23	TEE & PLUG	RED BRASS	1/2"
24	NIPPLE	RED BRASS	1/2"
25	90° ELBOW	RED BRASS	1/2"
26	PIPE	RED BRASS	1/2"
27	PLUG COCK	HARD RUBBER	1 1/4"
28	NIPPLE	HARD RUBBER	1 1/4"
28B	PIPE SUPPORT TO WALL		
29	NIPPLE	HARD RUBBER	1 1/4" X 3"
30	WATER HOSE AND 2 HOSE CLAMPS	RUBBER	1 1/2"
38	STREET ELL	RED BRASS	2"
57	NIPPLE	HARD RUBBER	1 1/4" X 2"
58	NIPPLES	HARD RUBBER	1 1/4" X 2"

NEW FITTINGS			
59	NIPPLE	HARD RUBBER	1" X 3"
60	BUSHING	HARD RUBBER	1 1/4" X 1"
61	COUPLING	HARD RUBBER	1 1/4"
62	PIPE	HARD RUBBER	1 1/4" X 1'-7"
63	WATER HOSE AND 2 HOSE CLAMPS	RUBBER	3/4"
64	WATER HOSE AND 2 HOSE CLAMPS	RUBBER	1"
65	NIPPLE	HARD RUBBER	3/4" X 3"
66	BUSHING	HARD RUBBER	1 1/4" X 3/4"
67	COUPLING	HARD RUBBER	1 1/4"
68	NIPPLE	HARD RUBBER	1 1/4" X 7 1/2"
69	PRESSURE GUAGE		
70	WATER HOSE AND 2 HOSE CLAMPS	RUBBER	1"

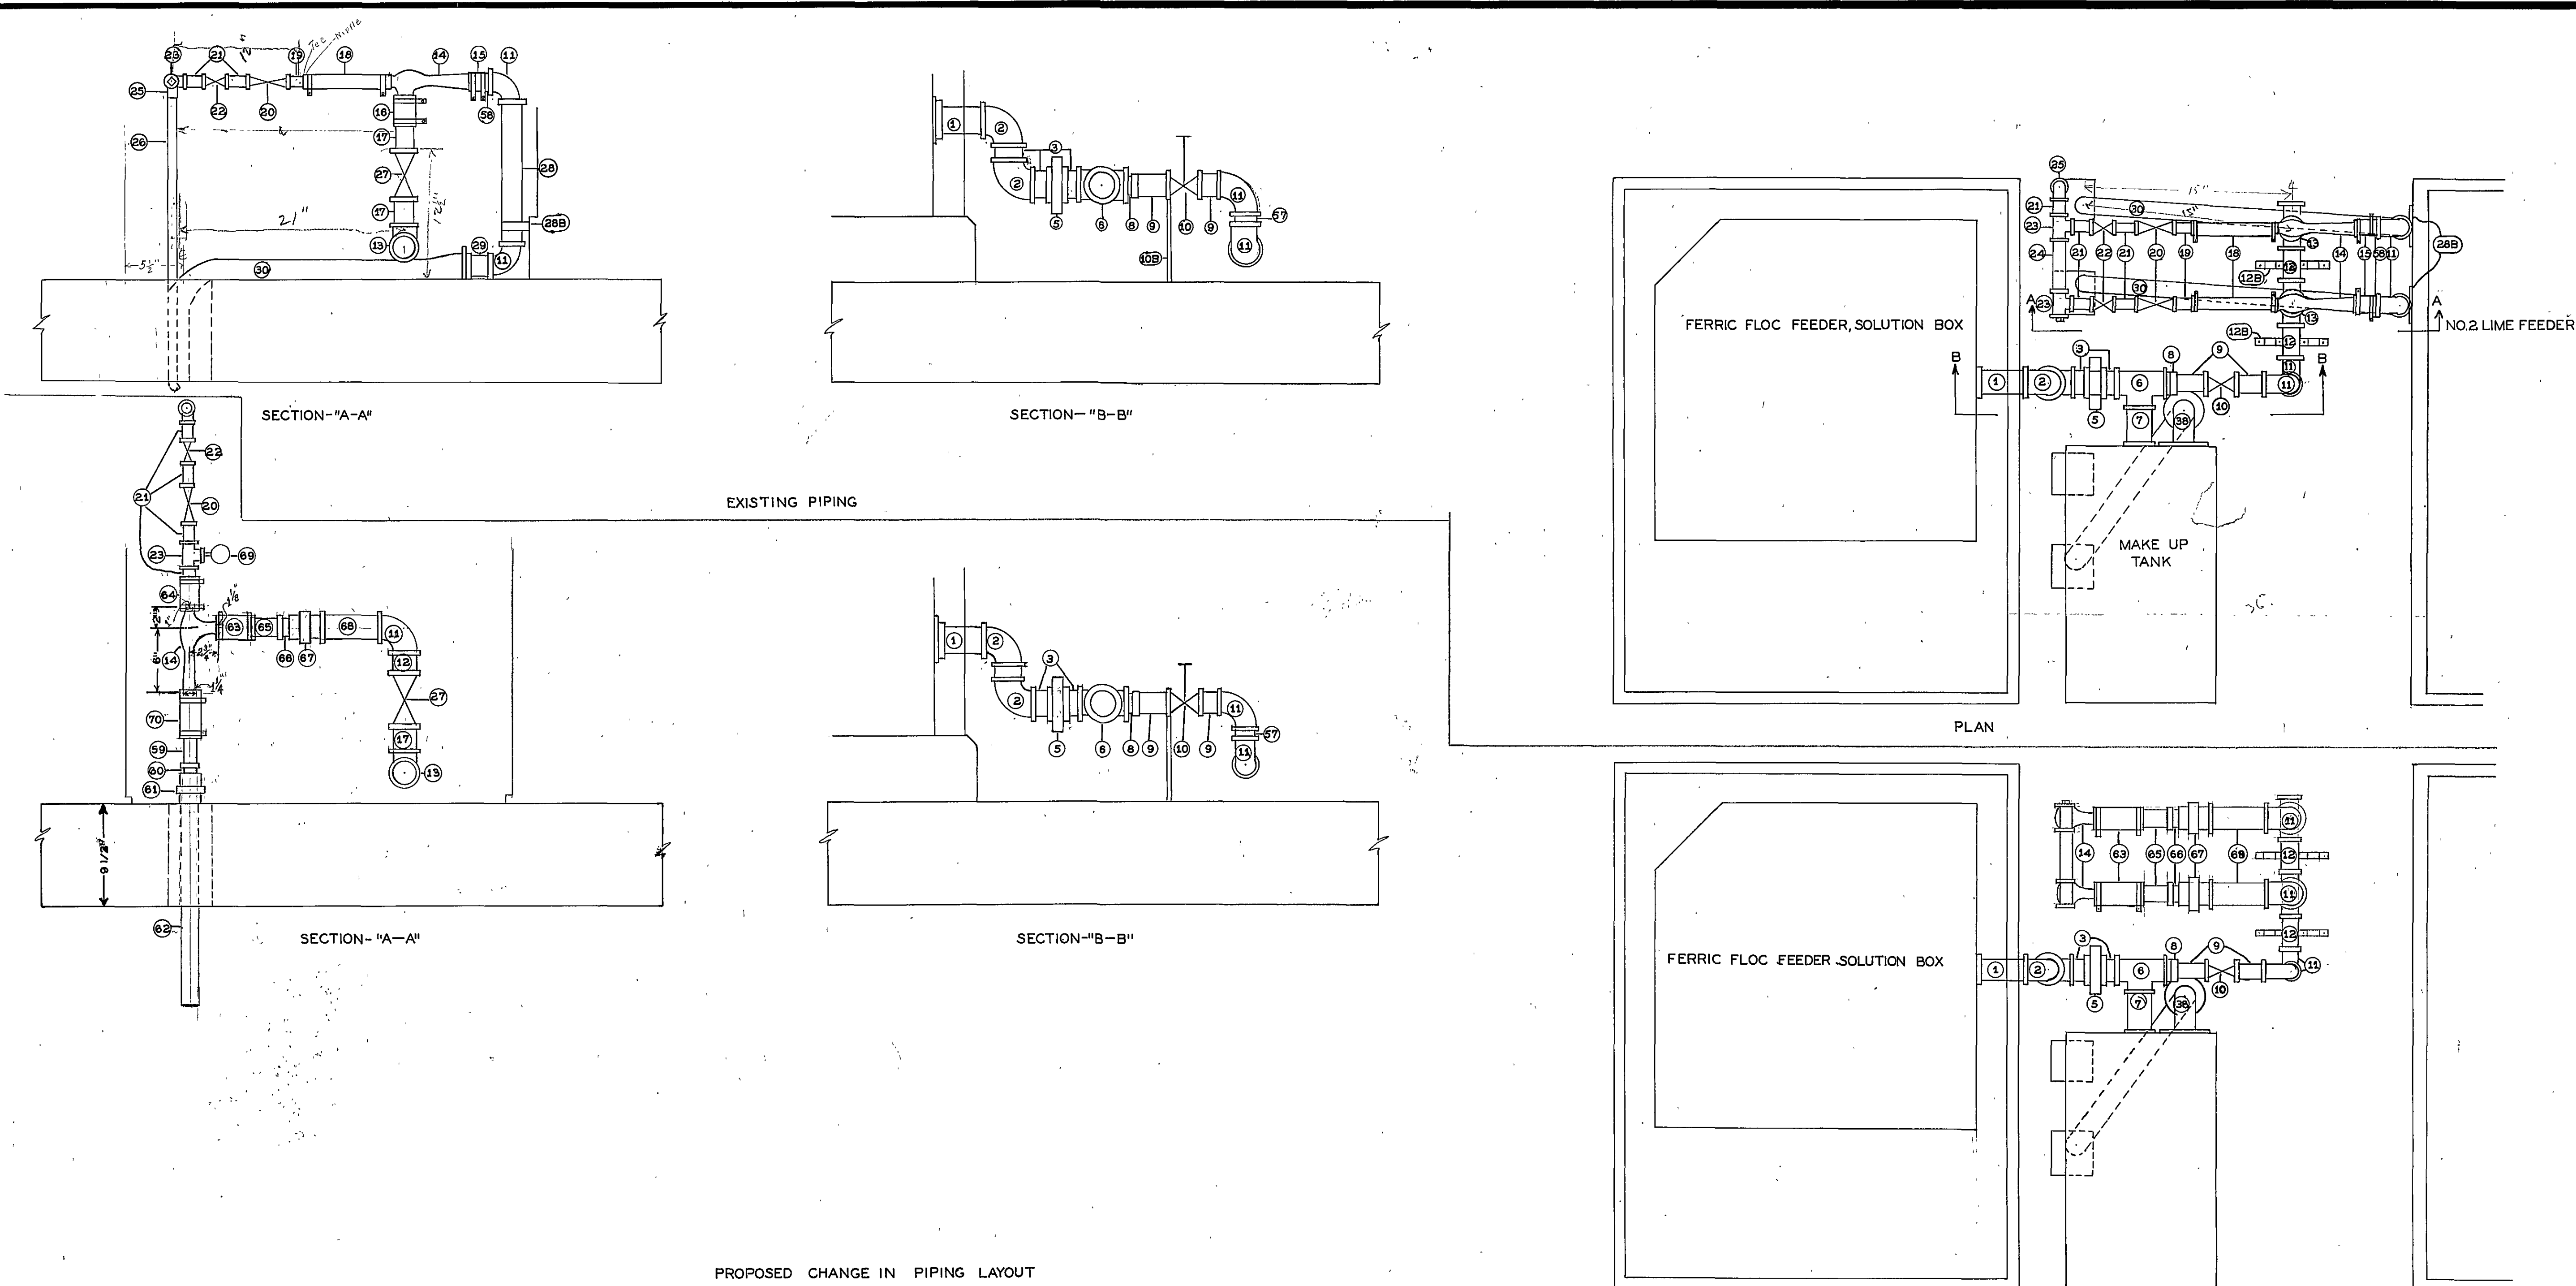

WATER DEPARTMENT
CITY OF ROANOKE, VA.
CARVIN COVE WATER SUPPLY
REVISION
OF CHEMICAL FEEDERS
SCALE- 1 1/2" = 1'-0"

DRAWN BY E.L.A.
JUNE, 28, 1950

F-3 D-4
289