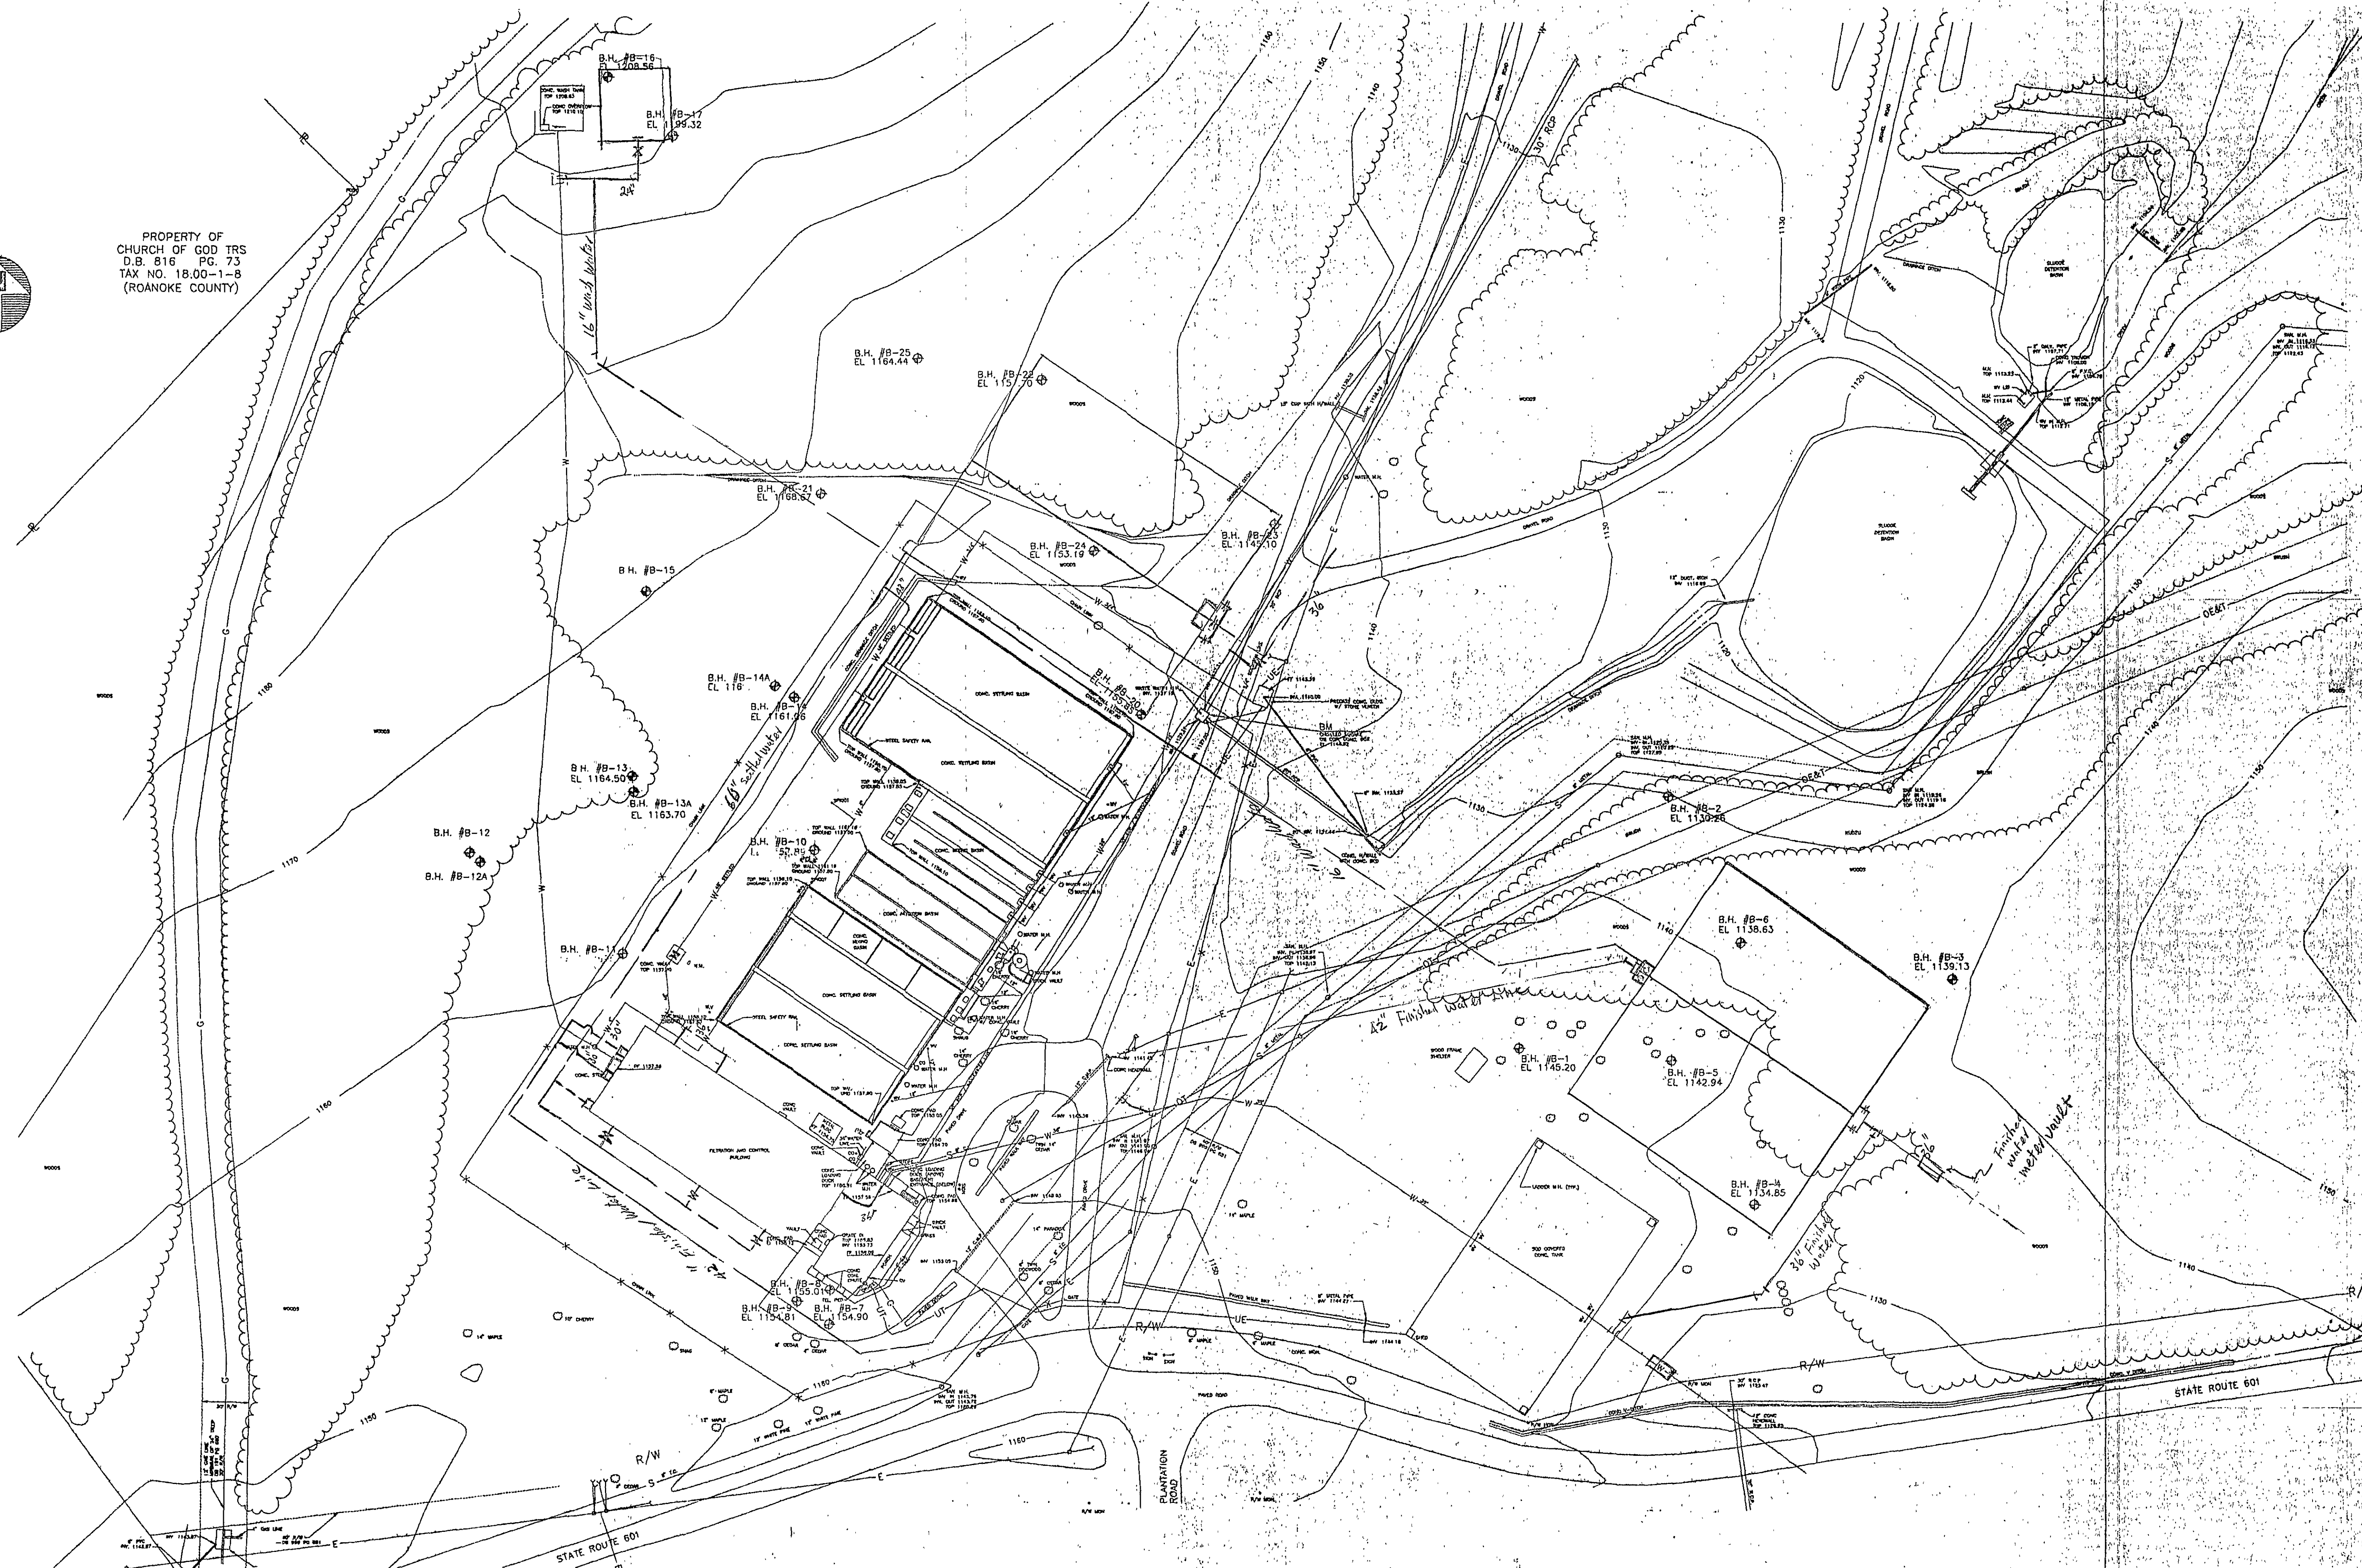
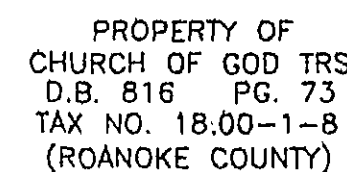


Mattern & Craig
CONSULTING ENGINEERS - SURVEYORS

ALVORD BURDICK & HOWSON

[illegible]

PLAN NO.