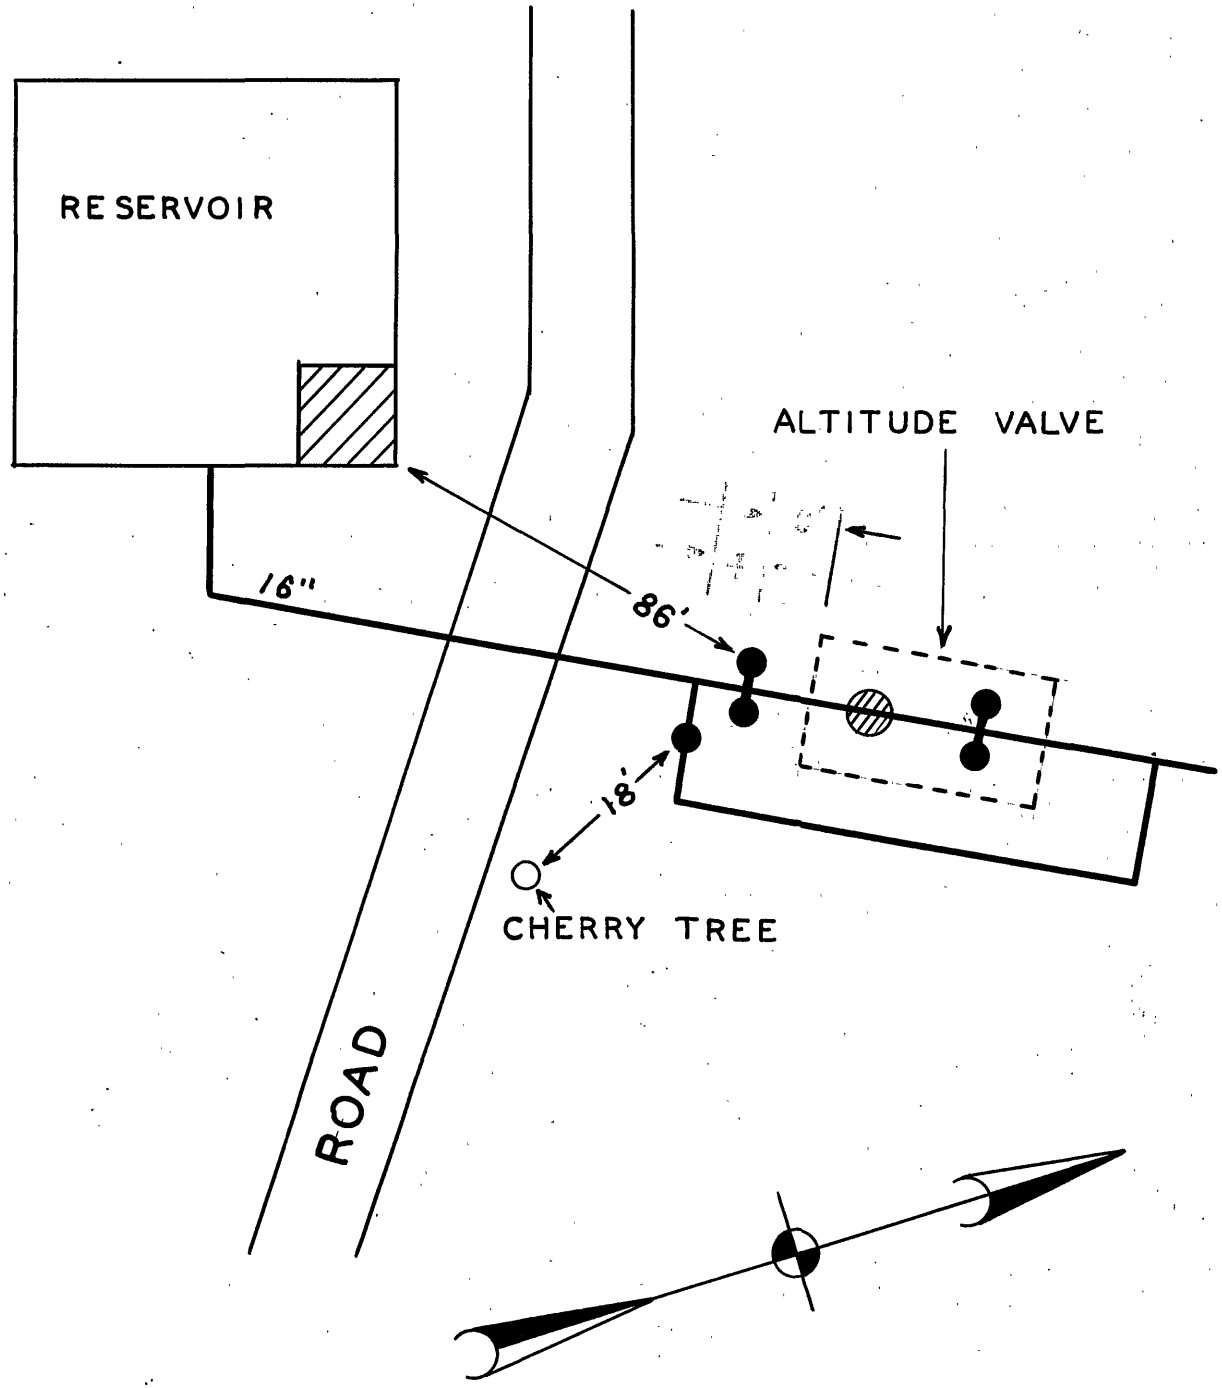

DATE	NO.	SIZE	MAKE	OPEN	TURNS
1946	1	8"	BYPASS		
1946	2	16"	M&H	L	100
1946	3	ALTITUDE VALVE			
1946	4	16"			

CITY OF ROANOKE — WATER DEPT.

VALVE DIAGRAM

CITY FARM RESERVOIR S.W.

SEC. MAP 138

DATE PAGE NO.

"IMPERIAL" TRACING CLOTH
K & E CO., N. Y.