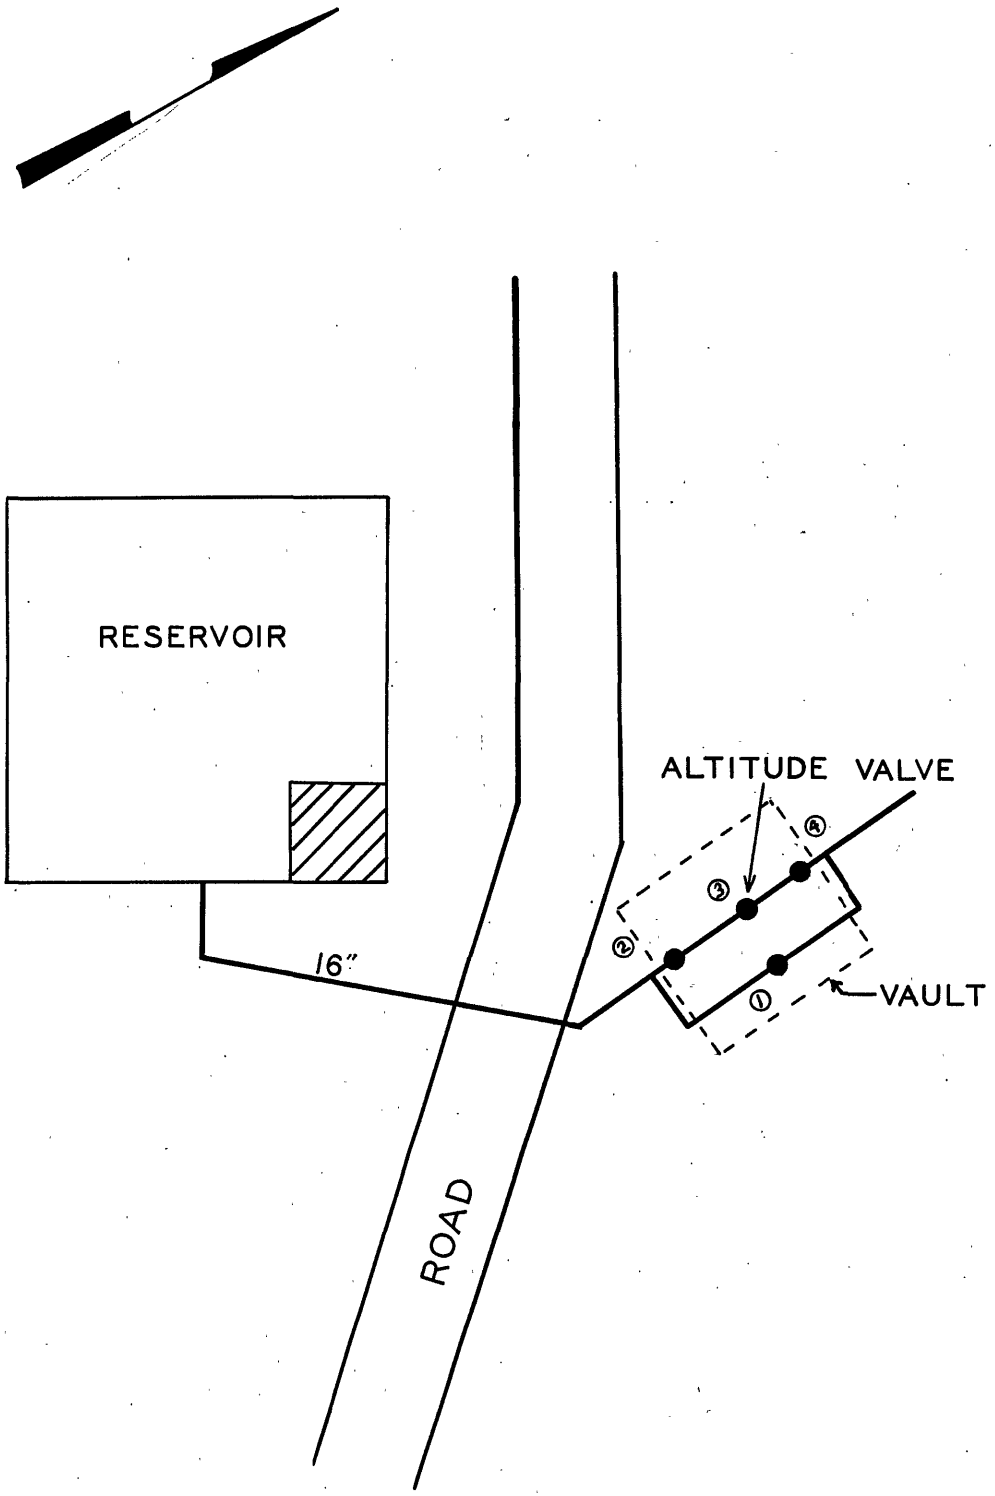

DATE	NO.	SIZE	MAKE	OPEN	TURNS
1946	1	8"	MUELLER	L	
1946	2	12"	MUELLER	R	
1946	3	ALTITUDE VALVE			
1946	4	12"	MUELLER	R	

CITY OF ROANOKE—WATER DEPT.

VALVE DIAGRAM

CITY FARM RESERVOIR S.W.

SEC. MAP 138

DATE PAGE NO.