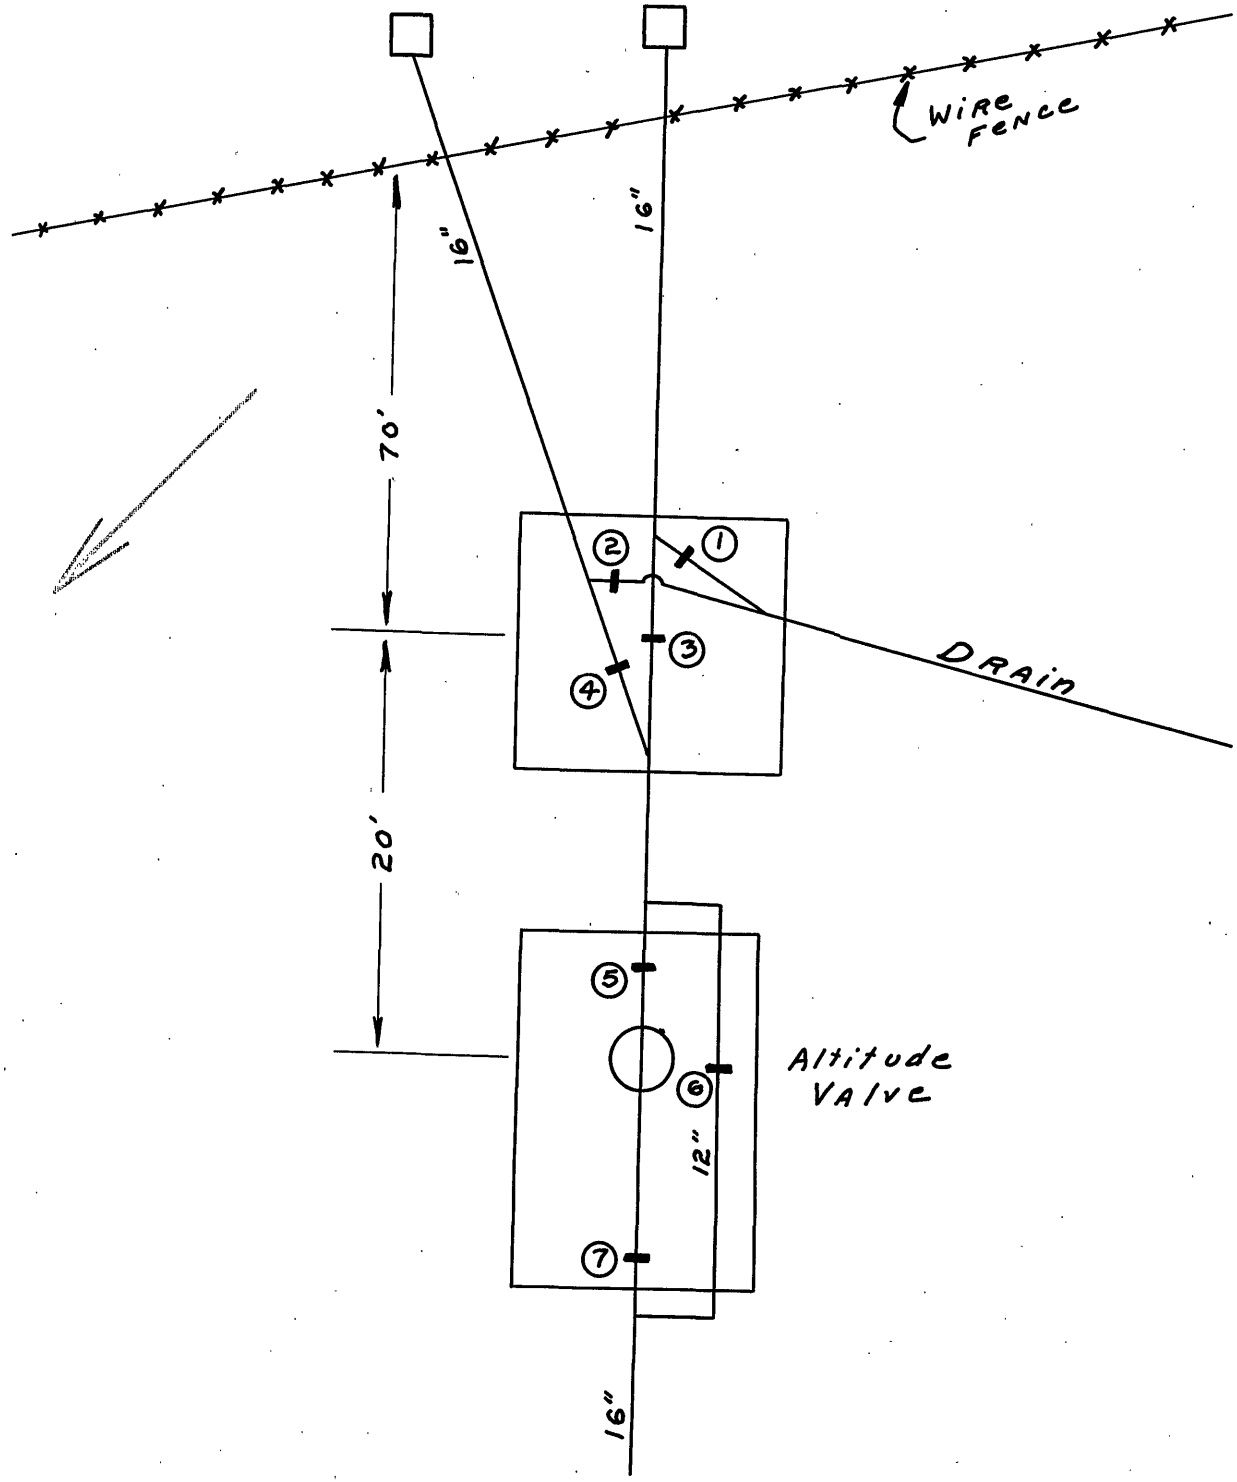

DATE	NO.	SIZE	MAKE	OPEN	TURNS
	1	6"			
	2	6"			
	3	16"			
	4	16"			
	5	16"			
	6	12"			
	7	16"			

CITY OF ROANOKE — WATER DEPT.

VALVE DIAGRAM

CRYSTAL SPRING

RESERVOIR S. E.

SEC. MAP 406

DATE PAGE NO.

"IMPERIAL" TRACING CLOTH
K & E CO., N. Y.