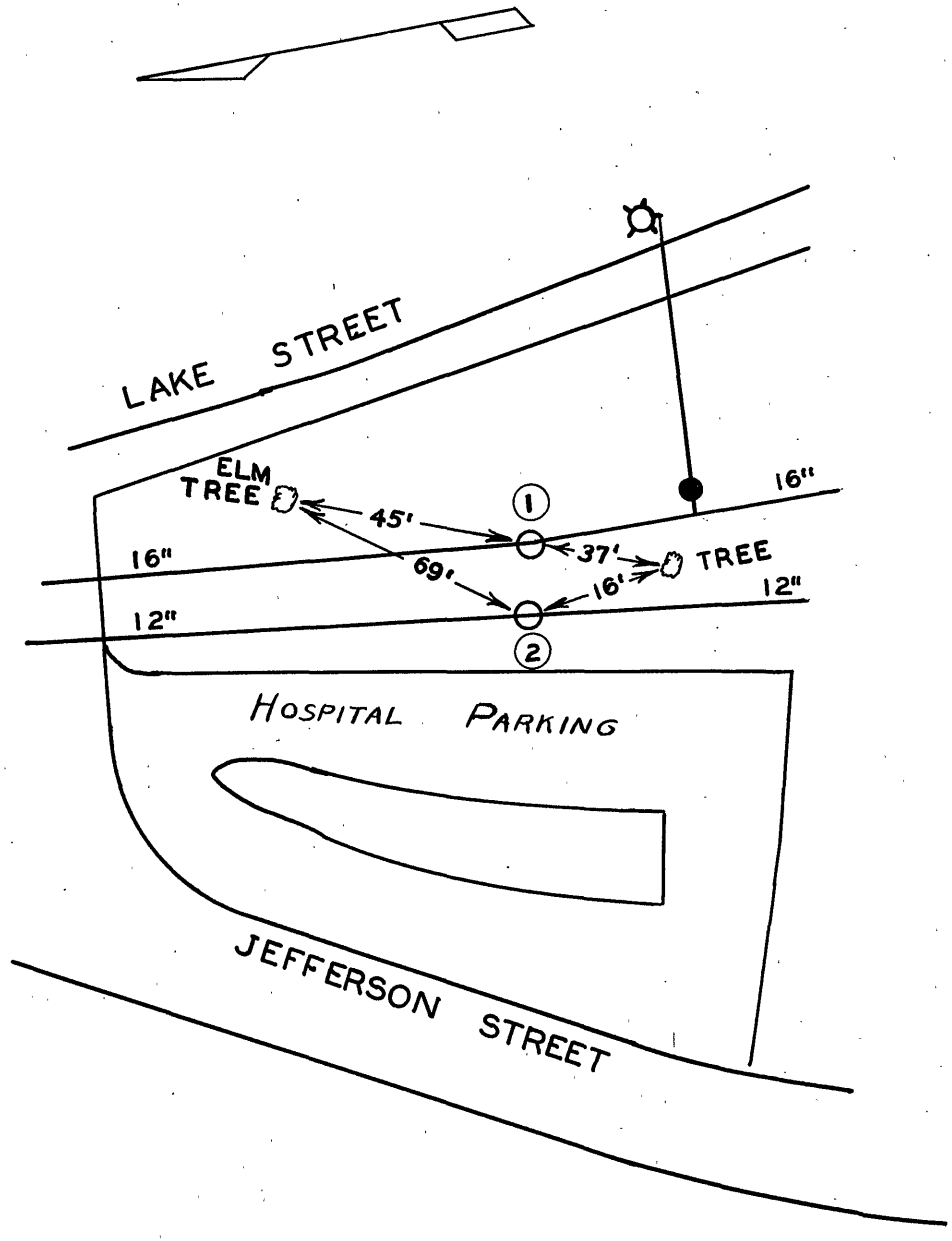

DATE	NO.	SIZE	MAKE	OPEN	TURNS
	1	1"	PITOT STA.		
	2	1"	PITOT STA.		

CITY OF ROANOKE—WATER DEPT.

VALVE DIAGRAM

CRYSTAL SPRING GROUNDS

NORTH OF BASIN S. W.

SEC. MAP 406

DATE PAGE NO.