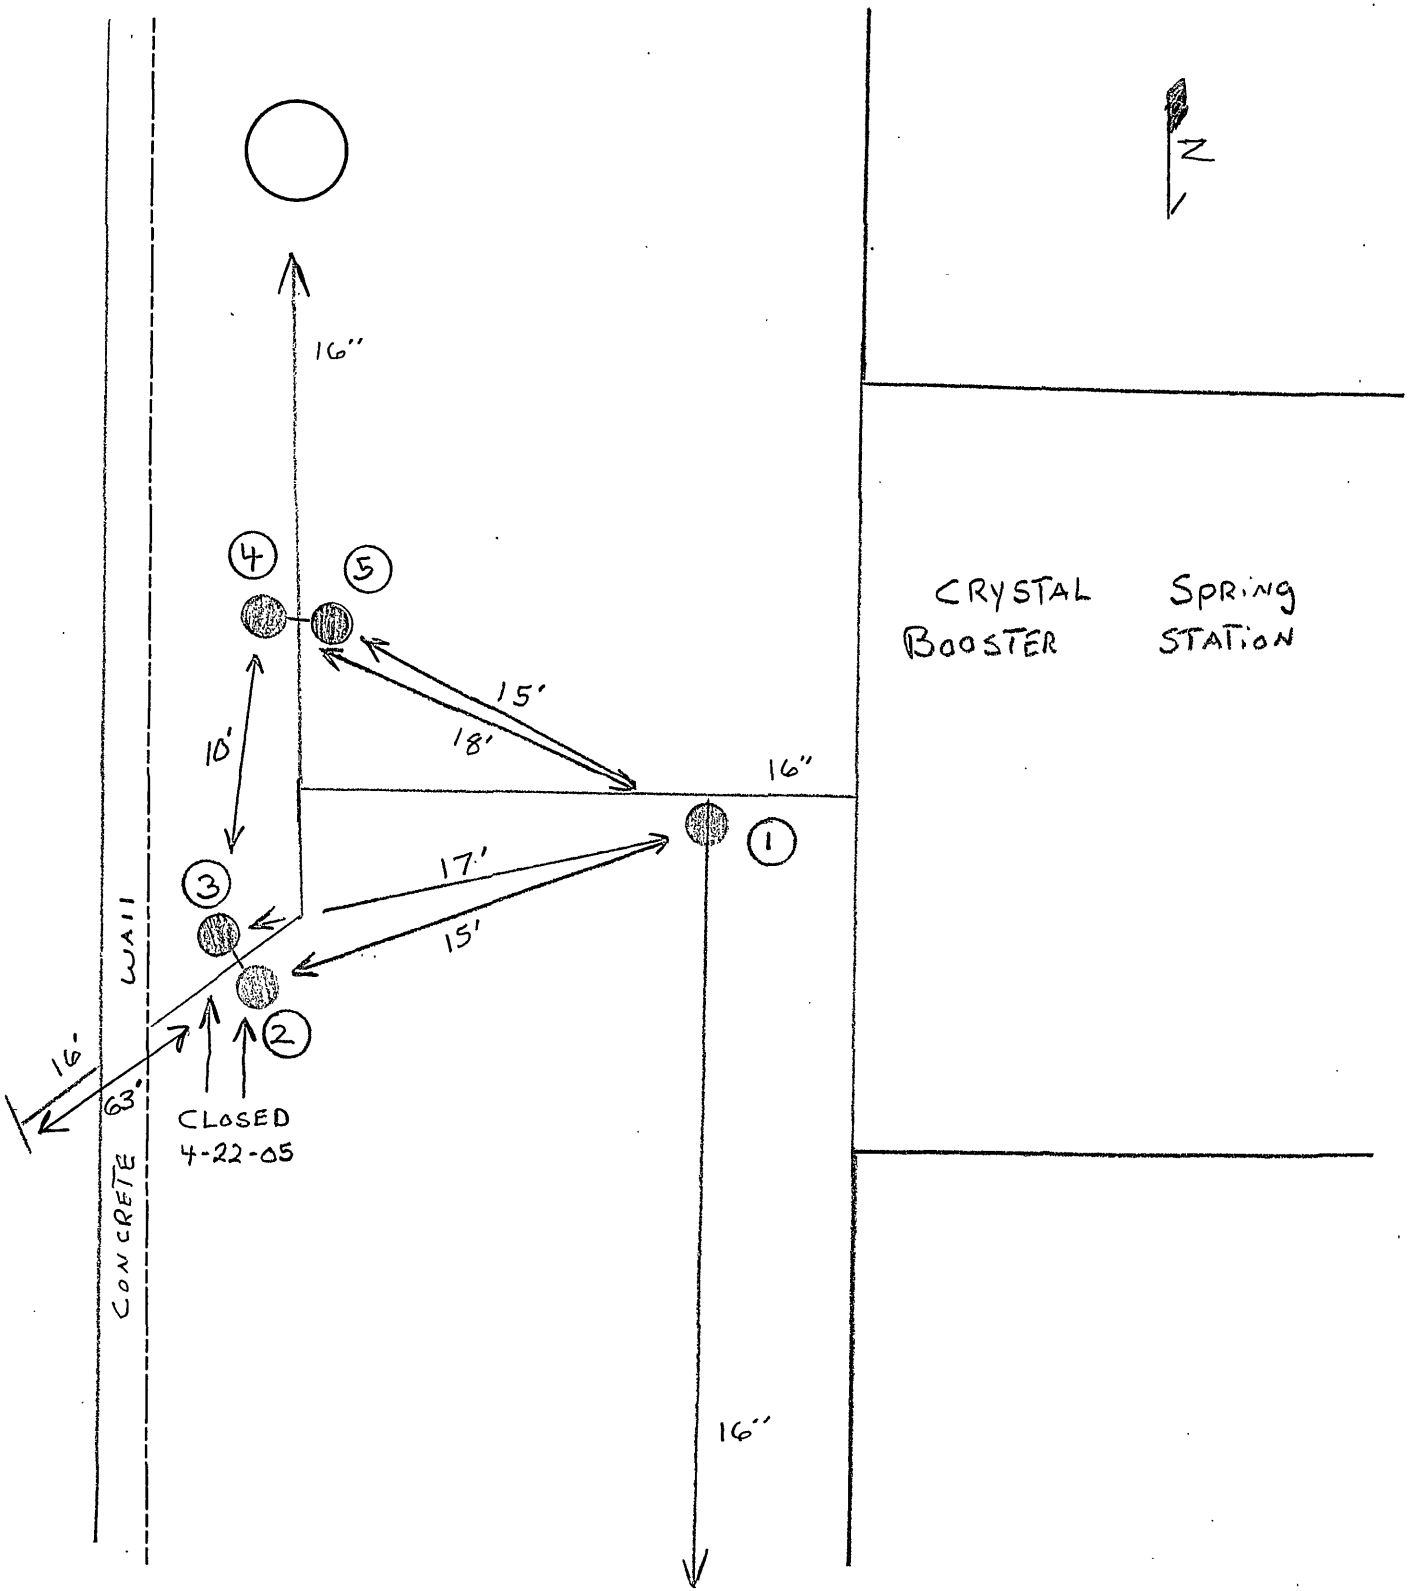

DATE	NO.	SIZE	MAKE	OPEN	TURNS
4/05	1	16"	AMERICAN	L	51
	2		BY PASS	R	
	3	16"	CLOSED	R	105
	4		BY PASS	R	
	5	16"	CLOSED	R	105

WESTERN VIRGINIA WATER AUTHORITY

VALVE DIAGRAM

JEFFERSON STREET BEHIND
CRYSTAL SPRING BOOSTER
STATION - CITY

SECT. MAP 406

DATE 4-22-05