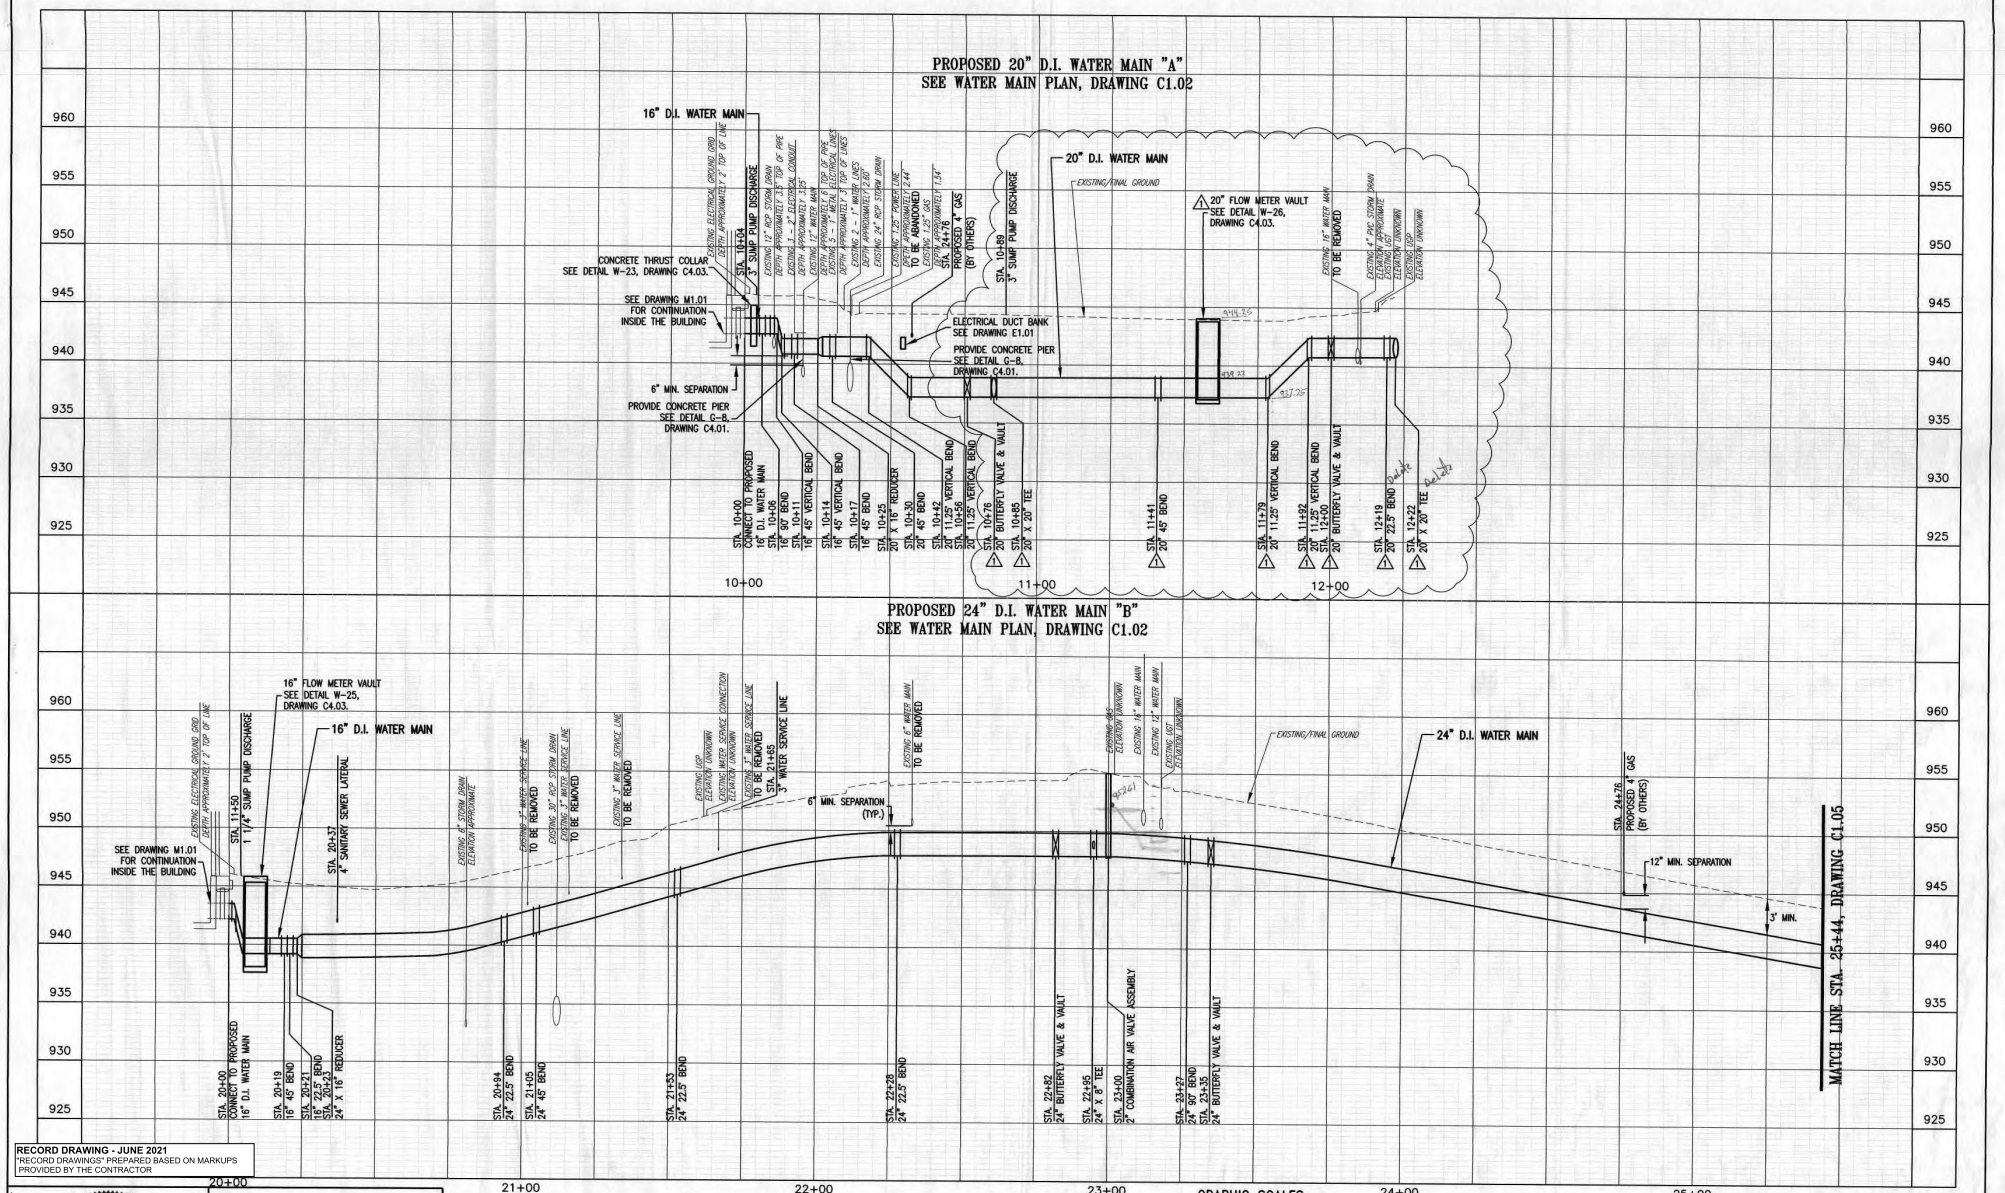

RECORD DRAWING - JUNE 2021
"RECORD DRAWINGS" PREPARED BASED ON MARKUPS PROVIDED BY THE CONTRACTOR

COMMONWEALTH OF VIRGINIA
PAULA J. MOORE
Lic. No. 036821
1/24/2020
PROFESSIONAL ENGINEER

Whitman, Requardt & Associates, LLP
1700 Kraft Dr, Suite 1200, Blacksburg, VA 24060

NOTES:
1. ALL WATER MAIN JOINTS AND FITTINGS SHALL BE RESTRAINED.

GRAPHIC SCALES
(IN FEET) HORIZ: 1 inch = 20 feet
(IN FEET) VERT: 1 inch = 5 feet

WESTERN VIRGINIA WATER AUTHORITY
601 South Jefferson Street, Suite 300
Roanoke, Virginia 24011

DES: PJM	SCALE: AS SHOWN
DRAWN: JES	HORIZ: 1" = 20'
CHECK: GWF	VERT: 1" = 5'
DATE: 1/24/20	

CRYSTAL SPRING
PUMP STATION RELOCATION

WATER MAIN PROFILE

REV	DATE	DESCRIPTION
1	3/10/20	ADDENDUM #1

DRAWING	SHEET
C1.04	7