



ELEVATION OF CR-183 CORNICE SCALE: 1 1/2" = 1'-0"

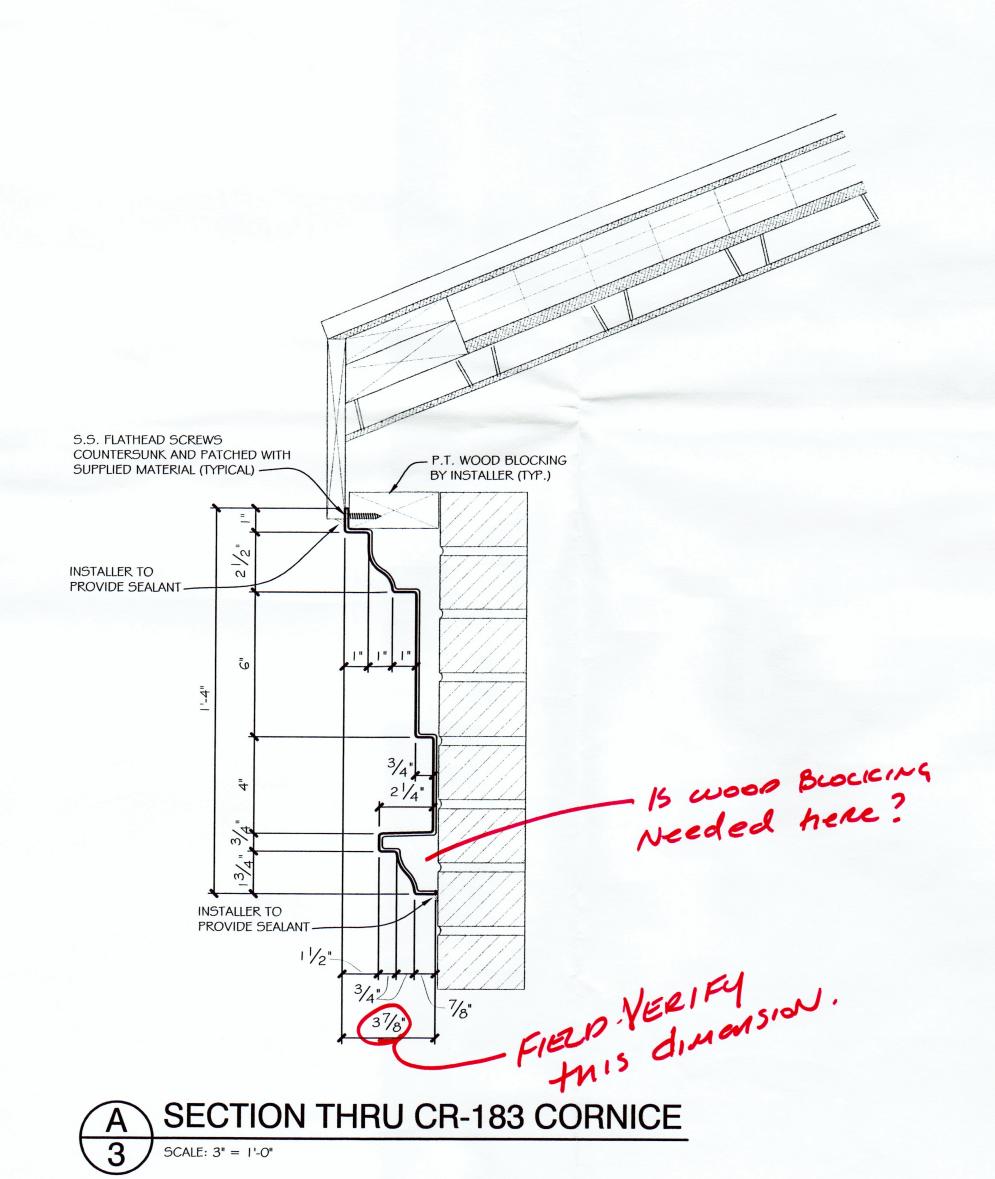


2'-5 1/4"

OUTSIDE CORNER FROM BELOW

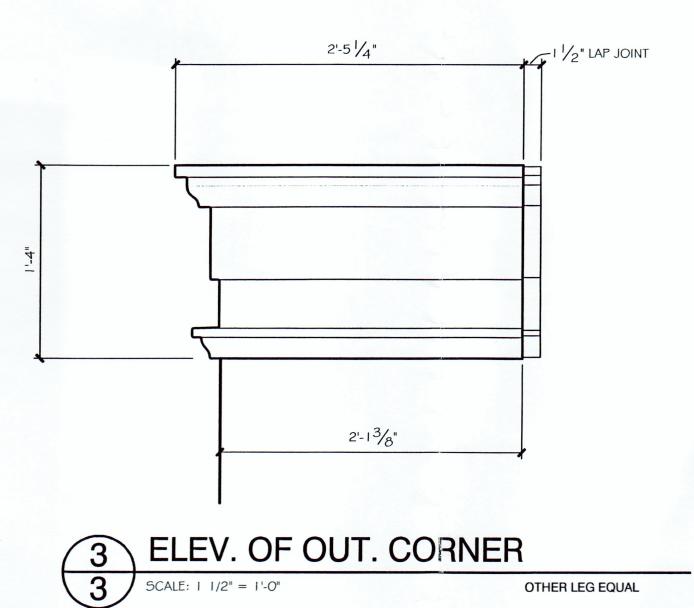

OTHER LEG EQUAL

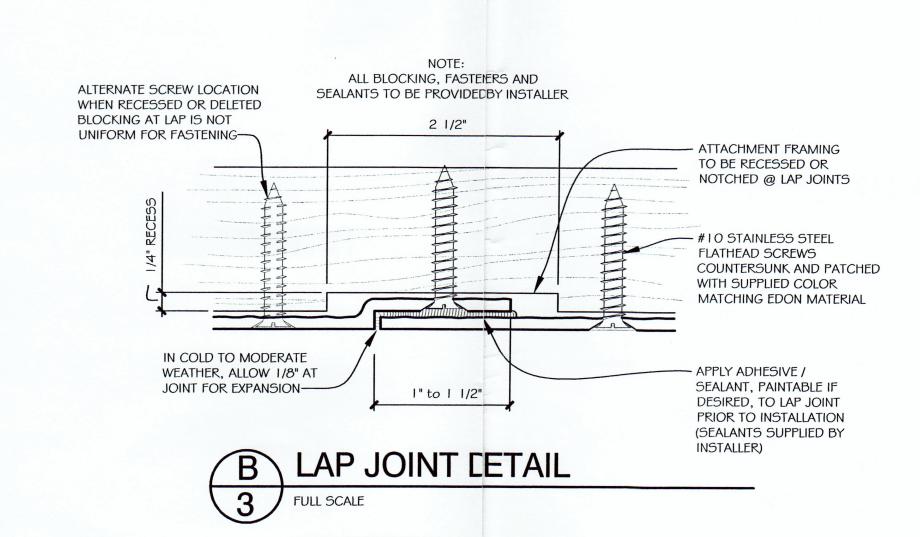

INSTRUCTION FOR INSTALLATION)F EDON FIBERGLASS CORNICE

- 1. Provide and install wood or galinized frame blocking (@ 16"-24" O.C.) per EDON shop drawings. Notch orset back blocking by 3/16" where lap joint occurs.
- 2. Typically, a cornice section will ave a lap joint to the right side. Begin an elevation with the left corner of the building ad march to the right.
- 3. Prepare section for installation y sanding lap joint and countersinking holes where blocking occurs. Countersink shuld allow a #8 flathead screw to sit just below the gel-coat surface.
- 4. Lay a bead of caulk on lap joint o be covered by section to be installed.
- 5. In cold weather, allow 1/8" at just for expansion.
- 6. Attach cornice to blocking usin, #8 x 1 1/2" galvanized or stainless steel screws in countersinks @ 16"-24" O.C.
- 7. Finish seams with paintable caul. (Paint after curing with matching color)
- 8. Patch screw holes with material supplied by EDON.
- IF PAINTING OF THE CORNICE IS ESIRED, FOLLOW THE BELOW STEPS
- 1. Wipe down all cornice sections with wax and grease remover.
- 2. Lightly sand the cornices to bepainted.
- 3. Wipe down cornices again with vax and grease remover.
- 4. Prime cornices if desired/but not necessary. Prime areas that have any body work done on them.
- 5. Paint cornice with at least an oil base paint. EDON recommends that a urethane base paint be used for best results.

EDON does not recommend water based paints.

