

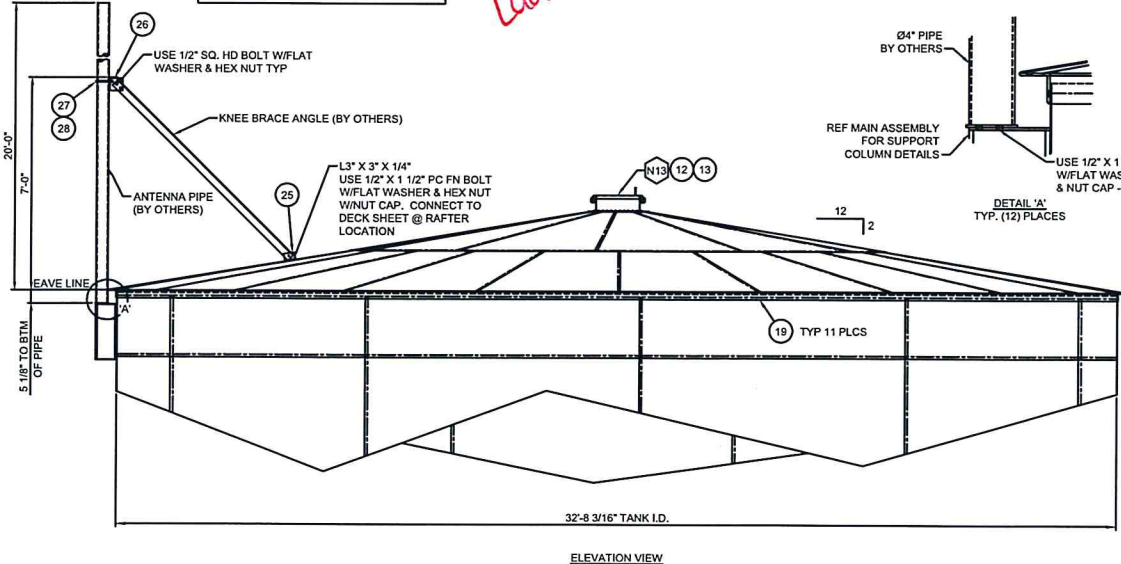
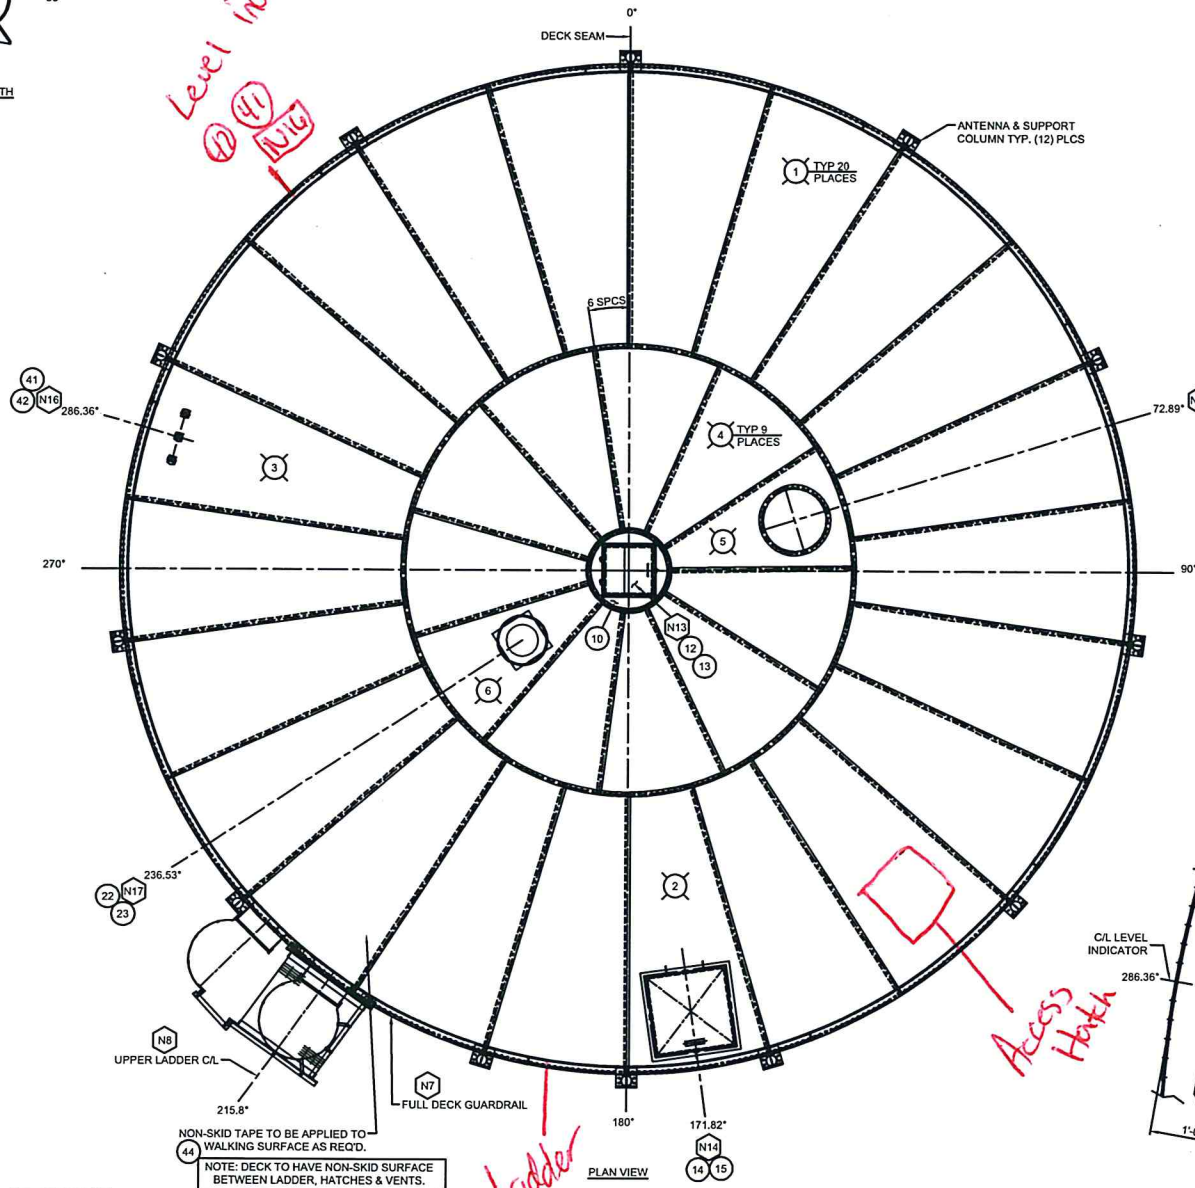
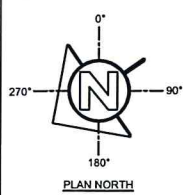
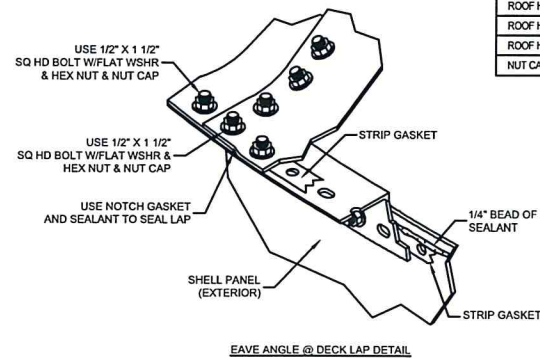
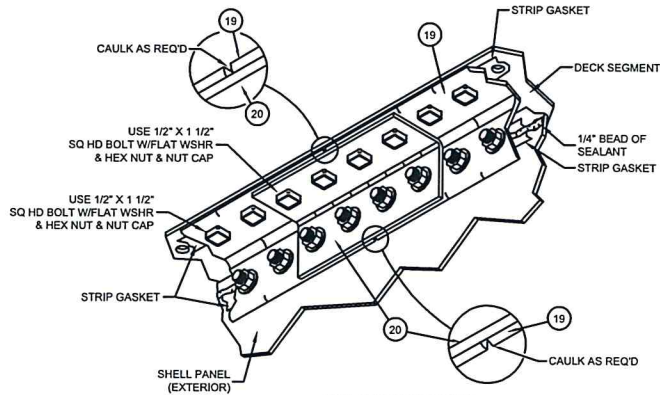
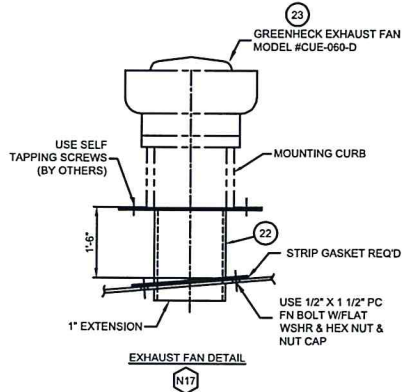
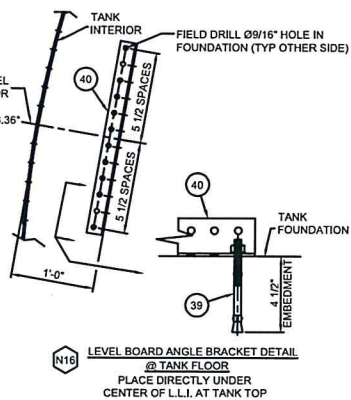
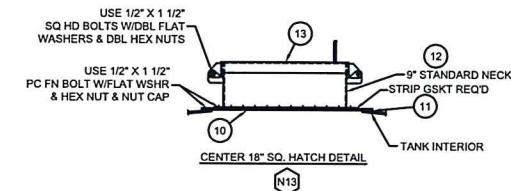


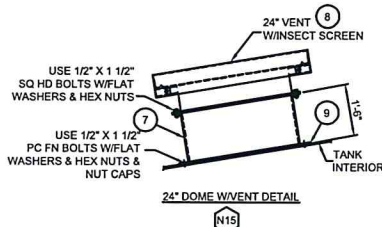

ACCESSORY ORIENTATION CHART						
CUSTOMER ITEM	ITEM	SERVICE	SIZE	REF DEGREE	RADIUS	ELEVATION FROM TOP OF CONCRETE TO CENTER OF ACCESSORY UNLESS NOTED OTHERWISE
N7	-	FULL PERIMETER GUARDRAIL	STD	215.8"	-	DECK
N8	-	EXTERIOR CAGED LADDER ASSEMBLY	STD	215.8"	SHELL	-
N13	12/13	CENTER SQ. HATCH	18"	CTR	CENTER	DECK
N14	14/15	SQ. DECK HATCH	30"	171.82"	14'-4 7/8"	DECK
N15	7/8	DECK VENT	24"	72.89"	5'-8"	DECK
N16	41/42	LEVEL INDICATOR W/ GUAGE BOARD	STD	286.36"	15'-4 1/16"	DECK
N17	22/23	SQ FLANGE W/EXHAUST FAN #CUE-060-D	10 1/2"	236.53"	4'-2"	DECK

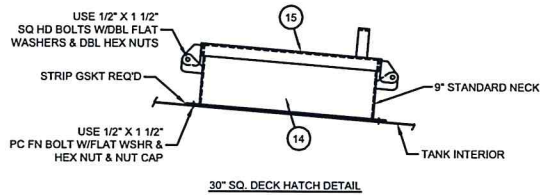

DECK: 12GA		
LOCATION	DESCRIPTION	QTY
CENTER DOME BOLTS	1/2" X 1 1/2" PC FN BOLT	33
CENTER DOME LAP BOLTS	1/2" X 1 1/2" PC FN BOLT	11
CENTER DOME WASHERS	1/2" FLAT WASHER	44
CENTER DOME NUTS	1/2" HX NUT	44
INNER SEGMENT RADIAL SEAM BOLTS	1/2" X 1 1/4" PC FN BOLT	341
INNER TO OUTER SEGMENT BOLTS	1/2" X 1 1/4" PC FN BOLT	231
INNER TO OUTER SEGMENT LAP BOLTS	1/2" X 1 1/2" PC FN BOLT	33
INNER SEGMENT WASHERS	1/2" FLAT WASHER	605
INNER SEGMENT NUTS	1/2" HX NUT	605
INNER SEGMENT GASKET	STRIP GASKET 1 3/4" WIDE EPDM (FEET)	135
OUTER SEGMENT RADIAL SEAM BOLTS	1/2" X 1 1/4" PC FN BOLT	1034
OUTER TO EAVE ANGLE	1/2" X 1 1/2" SQ HD BOLT	462
OUTER TO EAVE ANGLE LAP	1/2" X 1 1/2" SQ HD BOLT	22
OUTER TO EAVE ANGLE SPICE	1/2" X 1 1/2" SQ HD BOLT	44
OUTER TO EAVE ANGLE WASHERS	1/2" FLAT WASHER	1562
OUTER TO EAVE ANGLE NUTS	1/2" HX NUT	1562
TOTAL OUTER & EAVE GASKET	STRIP GASKET 1 3/4" WIDE EPDM (FEET)	411
DECK LAP GASKET	HEAVY NOTCH GASKET EPDM	66
ROOF HATCH TO DECK BOLTS	1/2" X 1 1/2" PC FN BOLT	56
NOZZLE & VENT TO DECK BOLTS	1/2" X 1 1/2" PC FN BOLT	125
ACCESSORY TO DECK WASHERS	1/2" FLAT WASHER	125
ACCESSORY TO DECK NUTS	1/2" HX NUT	125
ACCESSORY TO DECK GASKET	STRIP GASKET 1 3/4" WIDE EPDM (FEET)	14
EDGE SEALANT	SEALANT (TUBES)	15
ROOF HATCH HINGE BOLTS	1/2" X 1 1/2" SQ HD BOLT	2
ROOF HATCH HINGE WASHERS	1/2" FLAT WASHER	4
ROOF HATCH HINGE NUTS	1/2" HX NUT	4
NUT CAP SEALANT	SEALANT (TUBES)	52

NUT COVERS ON ALL EXTERIOR NUTS

FILL NUT COVERS HALF FULL OF SEALANT BEFORE INSTALLING

NOTE: EDGE SEAL AT ALL BOLTED CONNECTIONS.

NOTE: SEE FLAT LAYOUT FOR SIDEWALL DETAILS



Kevin W Sheddric, PE
2016.01.11 13:24:29 -06'00'

TOTAL WT: 5.042	PARENT: ---
TOLERANCES UNLESS OTHERWISE NOTED	
ANGULAR DEVIATION	PERMISSIBLE DEVIATION NOMINAL LENGTH IN INCHES
X = ±1.0° / X.X = ±0.5°	0 - 4" 4" ±.48" 48" ±.130" 130" ±.240" 240" ±.400"
LINEAR TOLERANCE	1/32" 1/16" 5/32" 1/8" 3/16"
HOLE TO HOLE TOLERANCE	1/32" 1/32" 1/32" 1/16" 1/16"

THE INFORMATION ON THIS DOCUMENT IS CONFIDENTIAL PROPERTY OF TANK CONNECTION AND ITS AFFILIATES. ANY OTHER USE, RETENTION, OR REPRODUCTION, WITHOUT THE WRITTEN CONSENT OF TANK CONNECTION, IS STRICTLY PROHIBITED.



REV	REVISION DESCRIPTION	DATE	DRAWN BY	CHECKED BY
0	RELEASED FOR FABRICATION	11/03/2015	DWM	CAS

CERTIFIED: APPROVED FOR CONSTRUCTION			
032'-8 3/16" DECK LAYOUT 2:12 SLOPE		PROJ #	05286
		JOB #	001
		DWG #	DECK5286001