


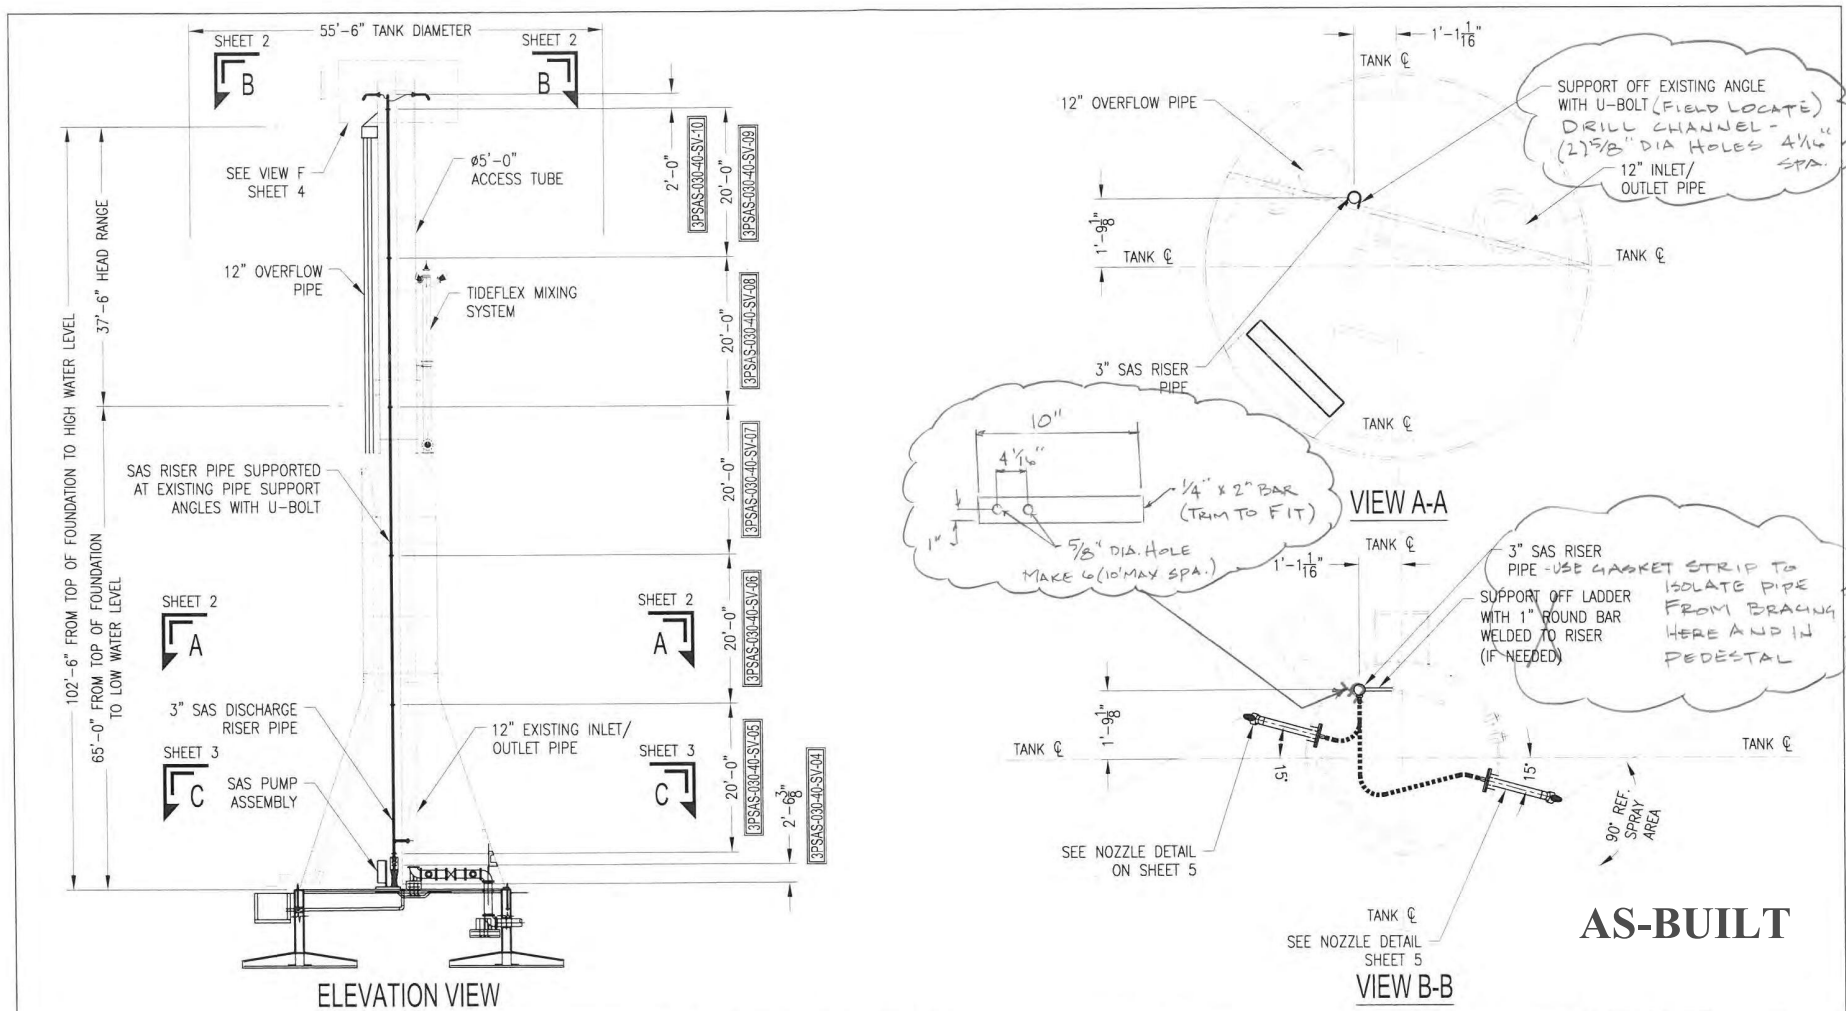

REV	BY	DATE	ECO#	CHKD	DESCRIPTION
A	KEC	5-8-20			ADDED OMNI METER, HALF COUPLING, & BASE BEND
-	KEC	4-22-20			ISSUE FOR APPROVAL

THE DESIGN INFORMATION WITHIN THESE DOCUMENTS IS THE INTELLECTUAL PROPERTY OF RED VALVE COMPANY/TIDEFLEX TECHNOLOGIES. THESE DOCUMENTS SHALL NOT BE USED TO CONSTRUCT DUPLICATE SYSTEMS; USE OF THESE DOCUMENTS AND/OR CONSTRUCTION OF DUPLICATE SYSTEMS SHALL VIOLATE THE COPYRIGHT AND PATENT PROTECTION LAWS ASSOCIATED WITH THIS PATENTED PRODUCT. THESE DOCUMENTS SHALL REMAIN THE PROPERTY OF RED VALVE COMPANY/TIDEFLEX TECHNOLOGIES AND ARE DISTRIBUTED FOR THE SOLE PURPOSE OF COORDINATING THE INSTALLATION OF THE SYSTEM(S) PROVIDED BY RED VALVE COMPANY / TIDEFLEX TECHNOLOGIES.

S.O.#:	QUOTE #. 89326
DWG. NOTES:	

Tideflex Technologies
 TIDEFLEX TECHNOLOGIES
 SPRAY AERATION SYSTEM

750 Holiday Drive, Suite 400
 Pittsburgh, PA 15220 USA
 Phone: 412-278-0044
 Fax: 412-278-3410
 Website: WWW.TIDEFLEX.COM
 Email: INFO@TIDEFLEX.COM

A Division of Red Valve Company, Inc.

0.5MG ELEVATED TANK
 WESTERN VIRGINIA WATER AUTHORITY, VA
 SAS - GENERAL ARRANGEMENT - ELEVATION VIEW, VIEW A-A & B-B

CONSULTANT: LUMSDEN ASSOCIATES, P.C.
 APPLICATION: SPRAY AERATION SYSTEM (SAS)

CAD SCALE: FULL PLOT SCALE: N.T.S. DWG. NO. **SAS19-89326** SHEET 2 OF 5

DWG. BY: KEC DATE: 4-22-20

CTE-8884 FRANKLIN CO, VA

4/20/20-19-20