


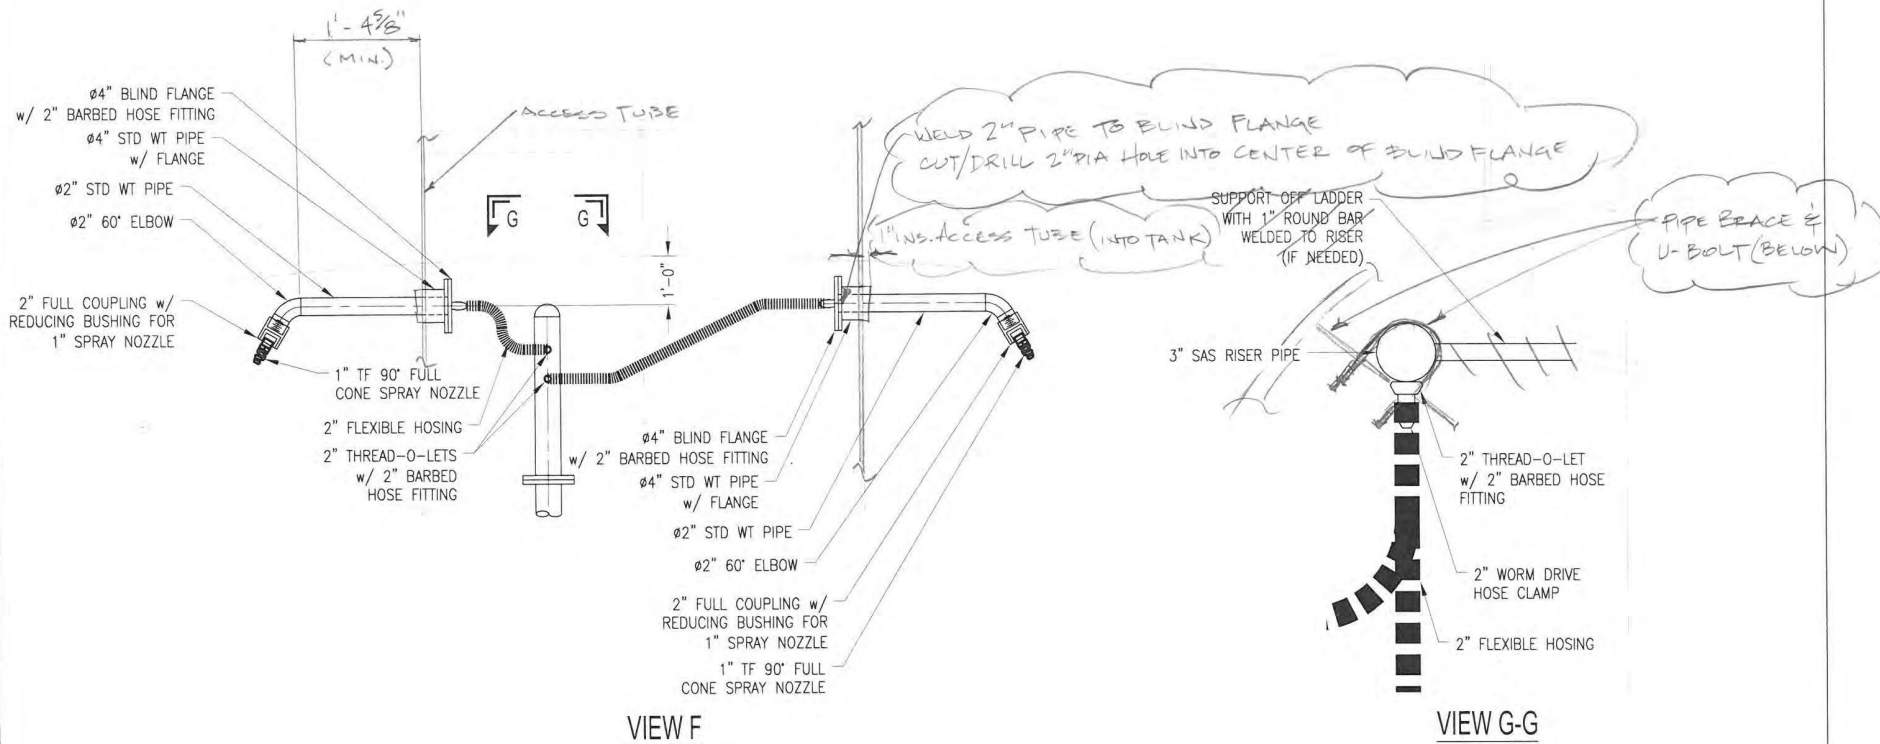

A	KEC	5-8-20			ADDED OMNI METER, HALF COUPLING, & BASE BEND
-	KEC	4-22-20			ISSUE FOR APPROVAL
REV	BY	DATE	ECO#	CHKD	DESCRIPTION

THE DESIGN INFORMATION WITHIN THESE DOCUMENTS IS THE INTELLECTUAL PROPERTY OF RED VALVE COMPANY/TIDEFLEX TECHNOLOGIES. THESE DOCUMENTS SHALL NOT BE USED TO CONSTRUCT DUPLICATE SYSTEMS; USE OF THESE DOCUMENTS AND/OR CONSTRUCTION OF DUPLICATE SYSTEMS SHALL VIOLATE THE COPYRIGHT AND PATENT PROTECTION LAWS ASSOCIATED WITH THIS PATENTED PRODUCT. THESE DOCUMENTS SHALL REMAIN THE PROPERTY OF RED VALVE COMPANY/TIDEFLEX TECHNOLOGIES AND ARE DISTRIBUTED FOR THE SOLE PURPOSE OF COORDINATING THE INSTALLATION OF THE SYSTEM(S) PROVIDED BY RED VALVE COMPANY / TIDEFLEX TECHNOLOGIES.

S.O.#:

QUOTE #: 89326

DWG. NOTES:

Tideflex
Technologies

TIDEFLEX TECHNOLOGIES
SPRAY AERATION SYSTEM

750 Holiday Drive, Suite 400
Pittsburgh, PA 15220 USA
Phone: 412-278-0044
Fax: 412-278-5410
WEBSITE: WWW.TIDEFLEX.COM
EMAIL: INFO@TIDEFLEX.COM

0.5MG ELEVATED TANK
WESTERN VIRGINIA WATER AUTHORITY, VA
SAS - GENERAL ARRANGEMENT - VIEWS F & G-G

CONSULTANT: LUMSDEN ASSOCIATES, P.C.

APPLICATION: SPRAY AERATION SYSTEM (SAS)

CAD SCALE: FULL PLOT SCALE: N.T.S.

DWG. BY: KEC DATE: 4-22-20

DWG. NO. **SAS19-89326**

SHEET
4 OF 5

CTI E-BB4 FRANKLIN Co, VA

16A E-19-20