


**WIRTZ SERVICES, LLC
WIRTZ CENTRAL SEWER SYSTEM
FRANKLIN COUNTY, VIRGINIA**

DRAWN BY:	JJD,WTW
DESIGNED BY:	JJD,DME
CHECKED BY:	DES
DATE:	16 JAN 2009
JOB NUMBER:	05353A

No. 1
No. 2
No. 3
No. 4
No. 5

SHEET NO.:
C1.2

PLAN & PROFILE SHEET INDEX

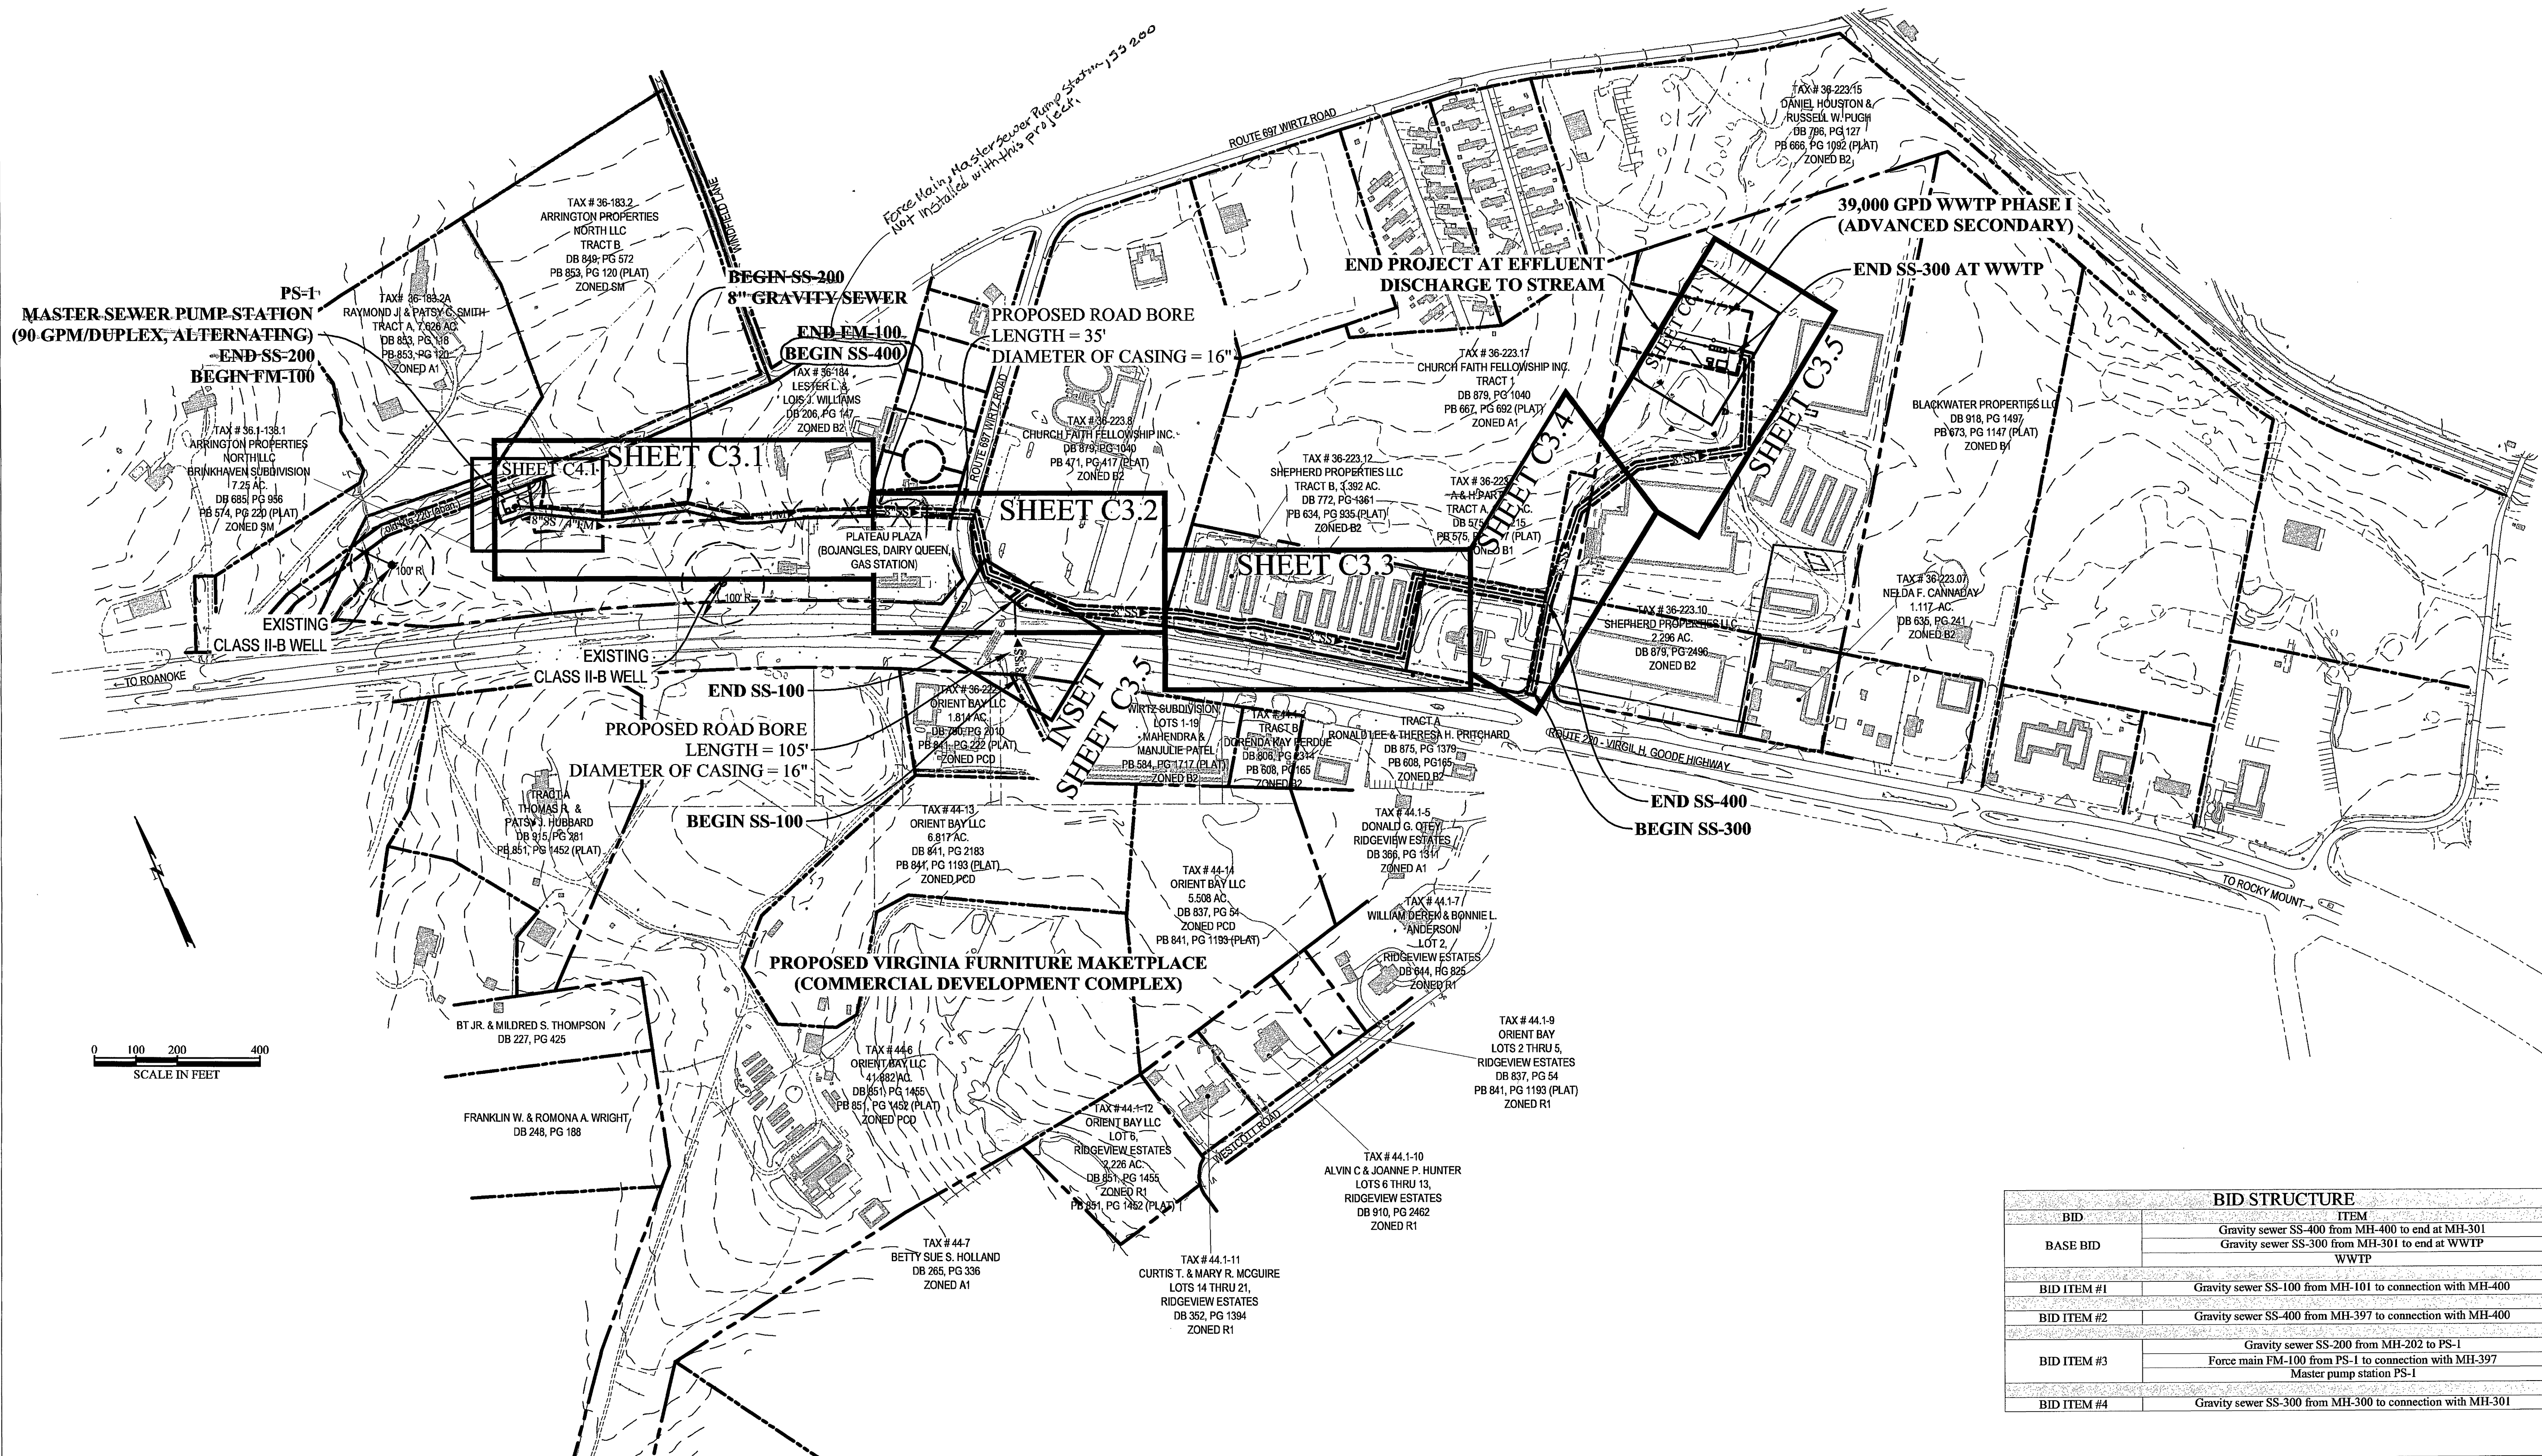

BID STRUCTURE	
BID	ITEM
BASE BID	Gravity sewer SS-400 from MH-400 to end at MH-301
	Gravity sewer SS-300 from MH-301 to end at WWTP
	WWTP
BID ITEM #1	Gravity sewer SS-100 from MH-101 to connection with MH-400
BID ITEM #2	Gravity sewer SS-400 from MH-397 to connection with MH-400
BID ITEM #3	Gravity sewer SS-200 from MH-202 to PS-1
	Force main FM-100 from PS-1 to connection with MH-397
	Master pump station PS-1
BID ITEM #4	Gravity sewer SS-300 from MH-300 to connection with MH-301