
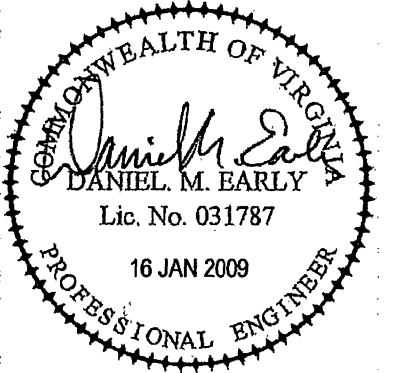
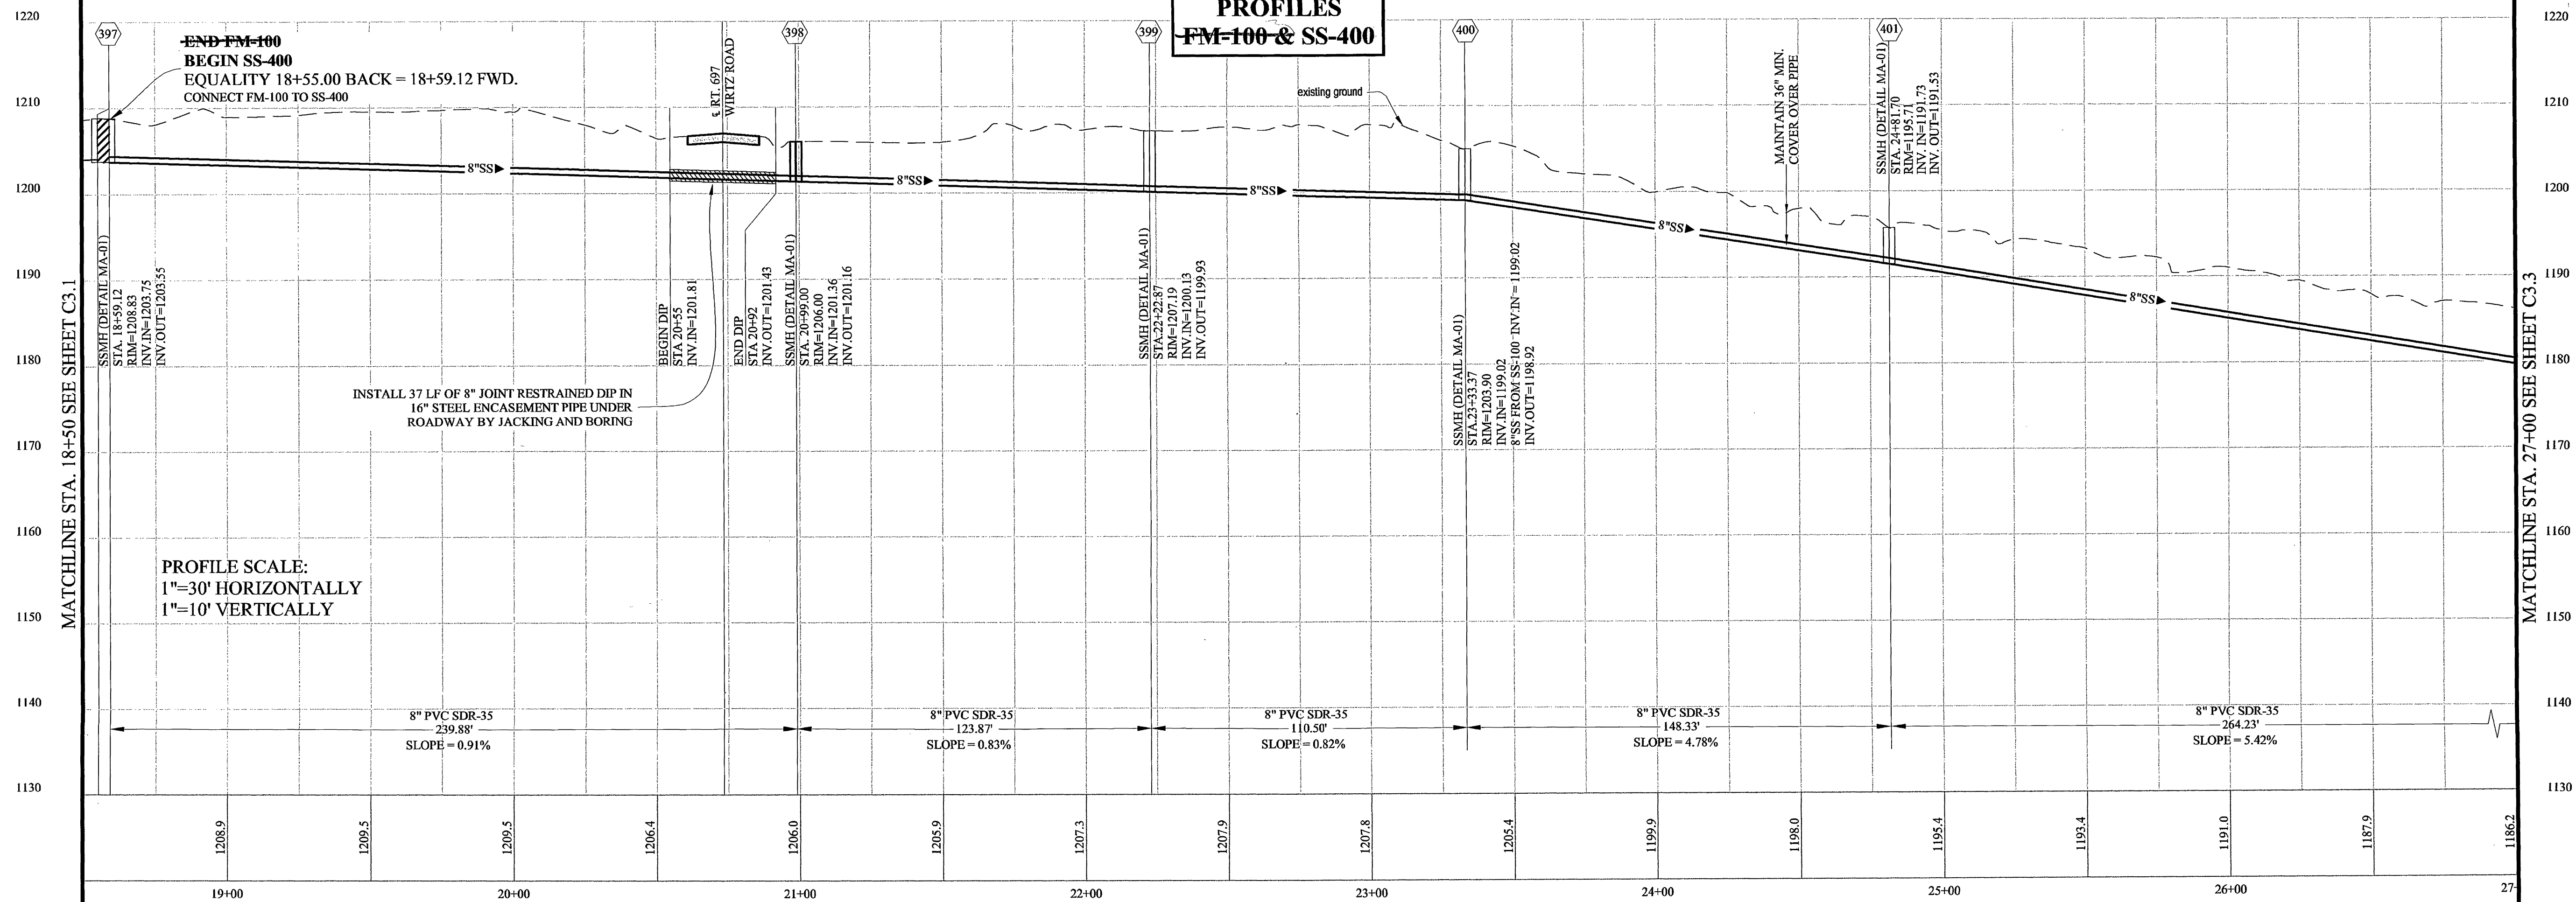


NOTE
SEE NOTES ON SHEET C3.1 REGARDING
THE DECOMMISSIONING OF THE
PLATEAU PLAZA SEWER SYSTEM AND
THE CONNECTION TO THE NEW SYSTEM.
PROJECT STARTS WITH SSMH 397

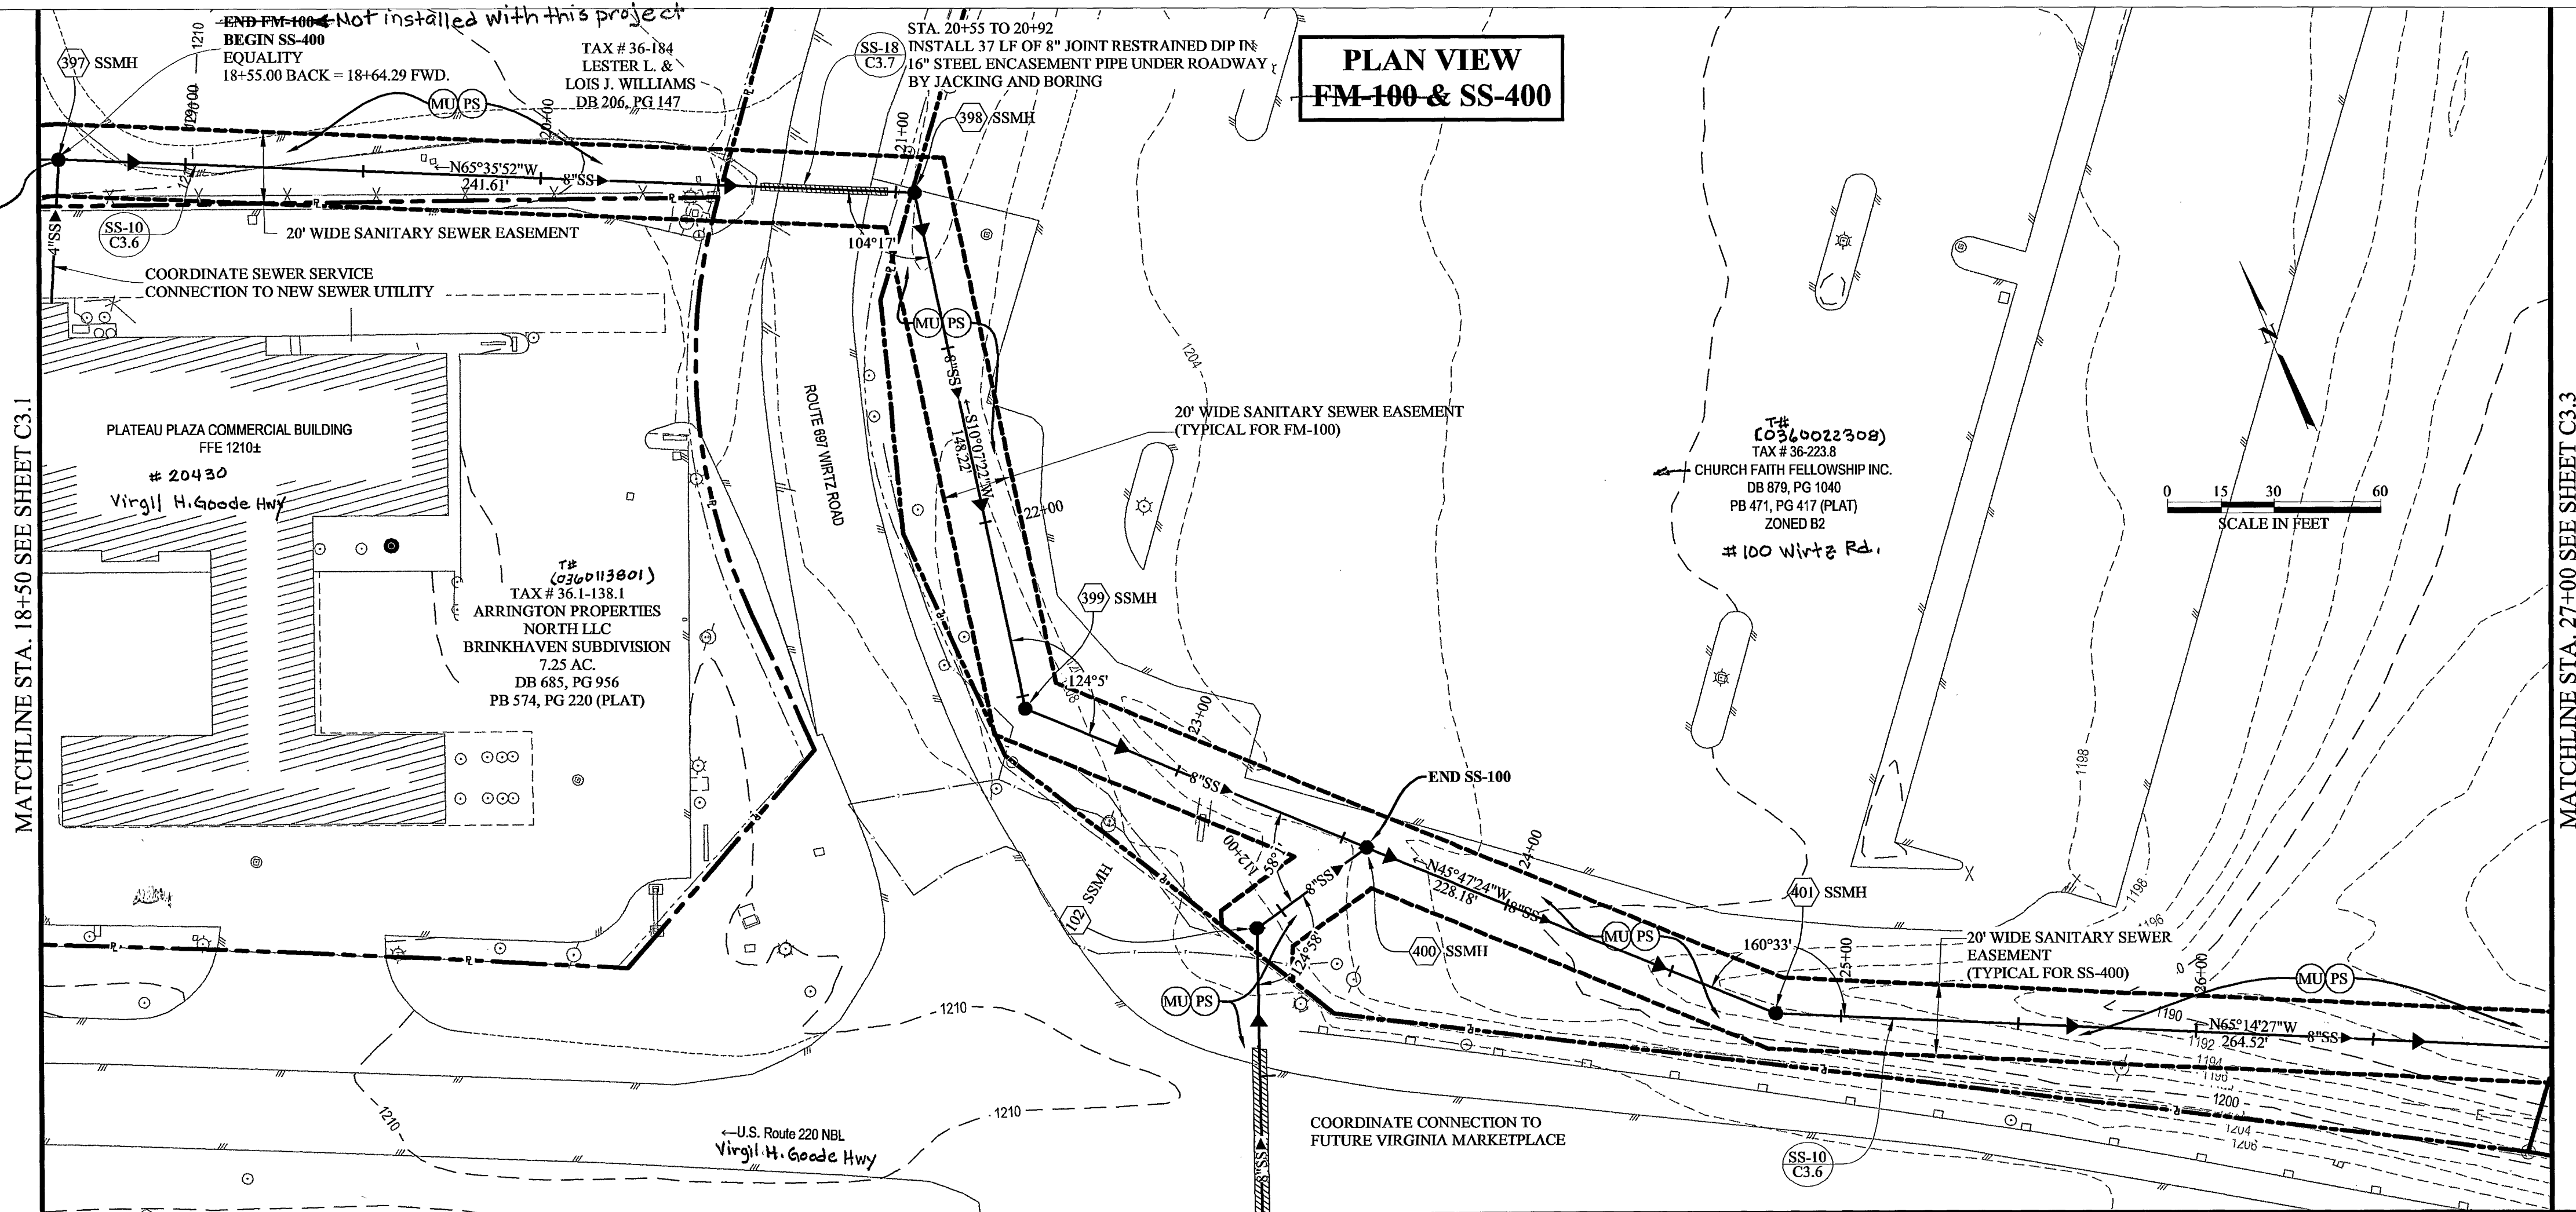

**ACS
DESIGN**

ENGINEERING • SURVEYING
LANDSCAPE ARCHITECTURE
CONSTRUCTION MANAGEMENT

2203 PETERS CREEK ROAD
ROANOKE, VIRGINIA 24017
P 540.562.2345 F 562.2344
INFO@ACSDSIGNLLC.COM
WWW.ACSDSIGNLLC.COM

**WIRTZ SERVICES, LLC
WIRTZ CENTRAL SEWER SYSTEM
FRANKLIN COUNTY, VIRGINIA**

© ACS DESIGN, LLC. - Material included herein
is covered by copyright. Use of this work in whole
or in part is strictly forbidden without the
expressed written consent of ACS DESIGN, LLC.

DRAWN BY: CEK, WTW
DESIGNED BY: DME
CHECKED BY: DES
DATE: 18 JAN 2009
JOB NUMBER: 05353A

REVISIONS:
No. 1
No. 2
No. 3
No. 4
No. 5

SHEET NO.:
C3.2

**FORCE MAIN FM-100 &
GRAVITY SEWER SS-400
PLAN & PROFILE**