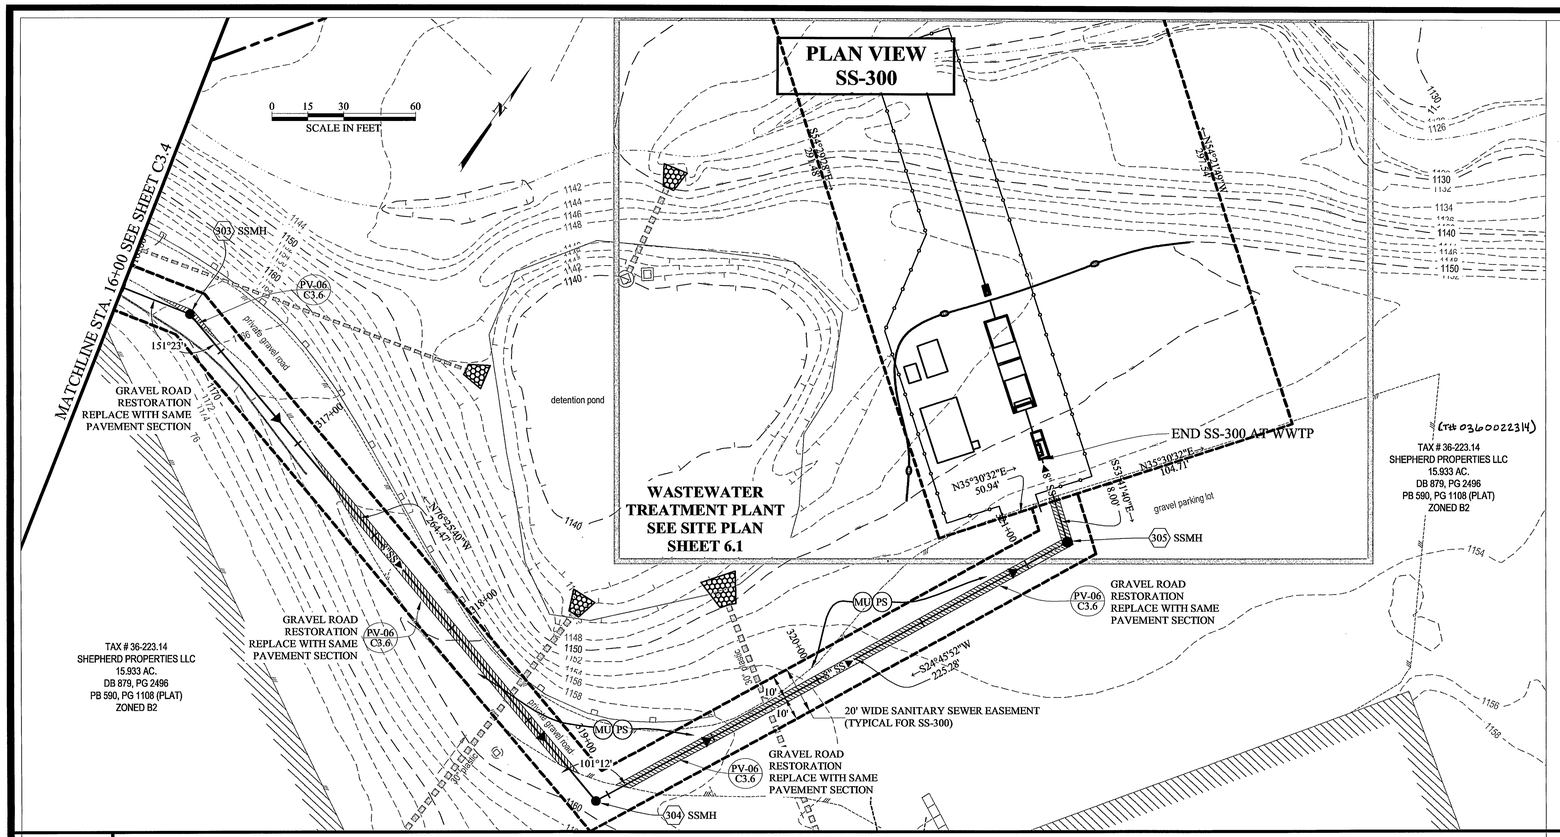

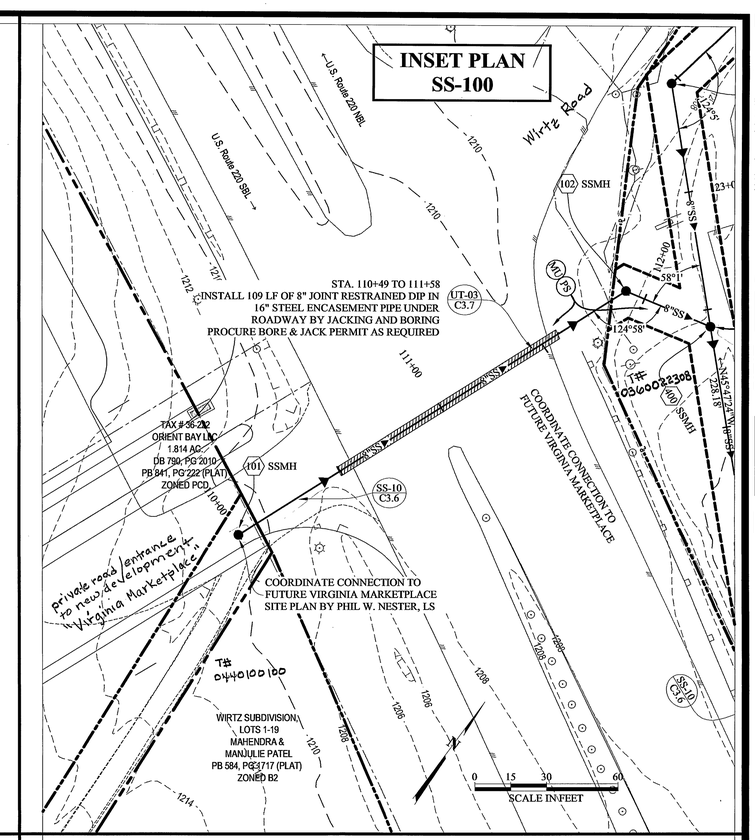

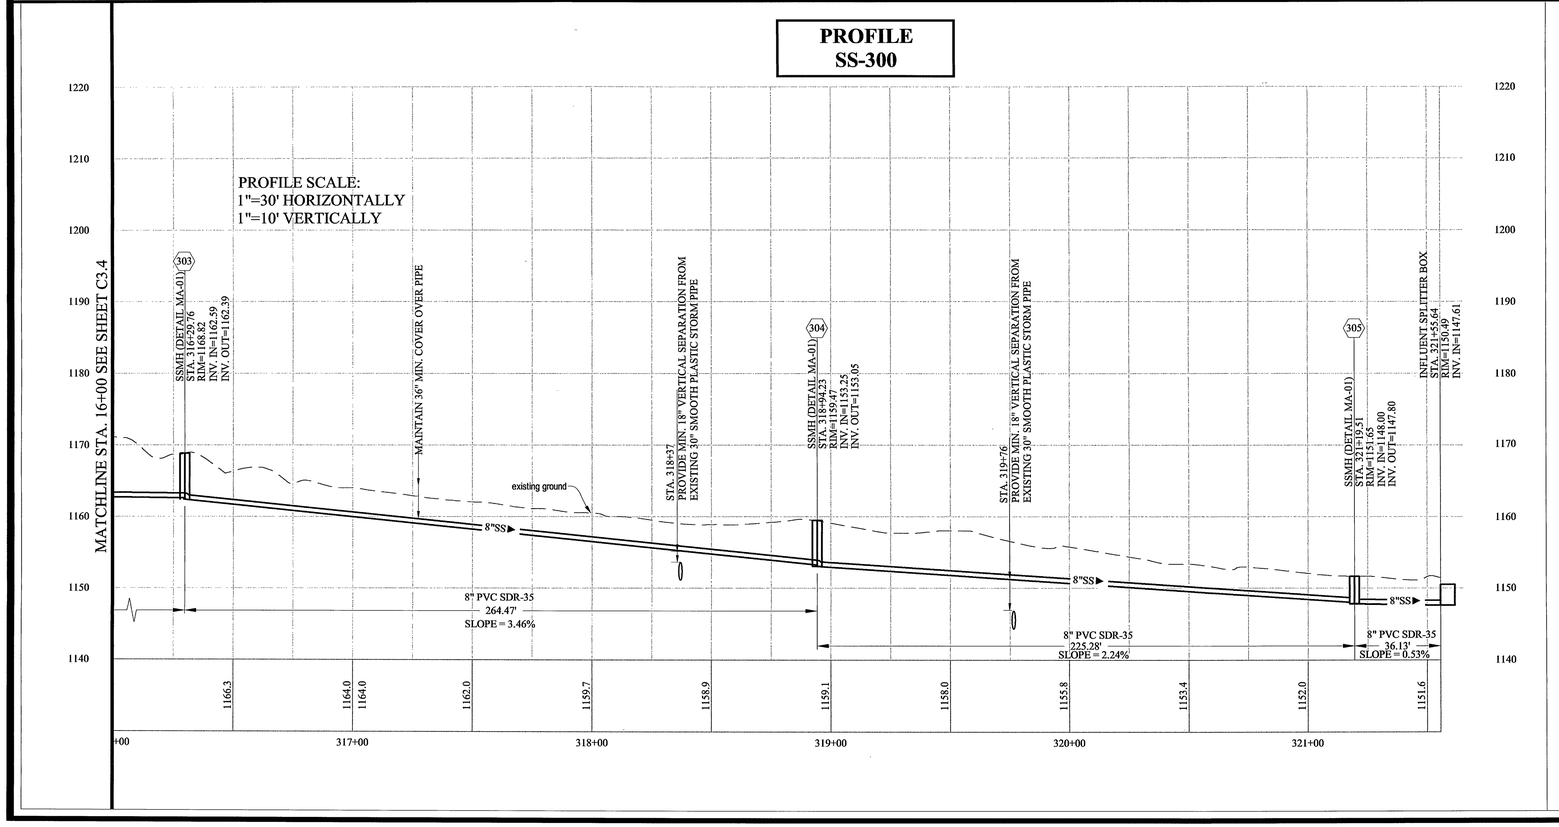

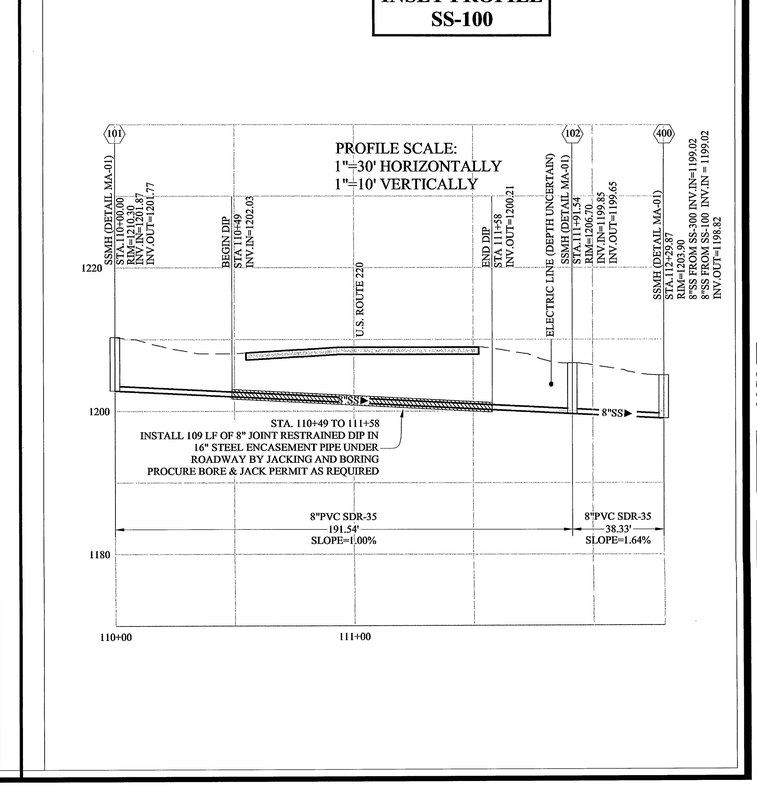

COMMONWEALTH OF VIRGINIA
DANIEL M. EARLY
Lic. No. 031787
16 JAN 2009
PROFESSIONAL ENGINEER

ACS DESIGN
ENGINEERING · SURVEYING
LANDSCAPE ARCHITECTURE
CONSTRUCTION MANAGEMENT

2203 PETERS CREEK ROAD
ROANOKE, VIRGINIA 24017
P 540.562.2345 F 562.2344
INFO@ACSDESIGNLLC.COM
WWW.ACSDESIGNLLC.COM

WIRTZ SERVICES, LLC
WIRTZ CENTRAL SEWER SYSTEM
FRANKLIN COUNTY, VIRGINIA

© ACS DESIGN, LLC - Material included herein is covered by copyright. Use of this work in whole or in part is strictly forbidden without the expressed written consent of ACS DESIGN, LLC.

DRAWN BY:	CEK,WTW
DESIGNED BY:	DME
CHECKED BY:	DES
DATE:	16 JAN 2009
JOB NUMBER:	05353A

REVISIONS:

No. 1
No. 2
No. 3
No. 4
No. 5

SHEET NO.:
C3.5

GRAVITY SEWERS
SS-300 & SS-100
PLAN & PROFILE

153A Virginia Marketplace Sewer System.dwg/Wirtzcs revisions for 01/06/09/05353A C3-PLAN.dwg, C3-2, 1/13/2009 12:42:33 PM, eew