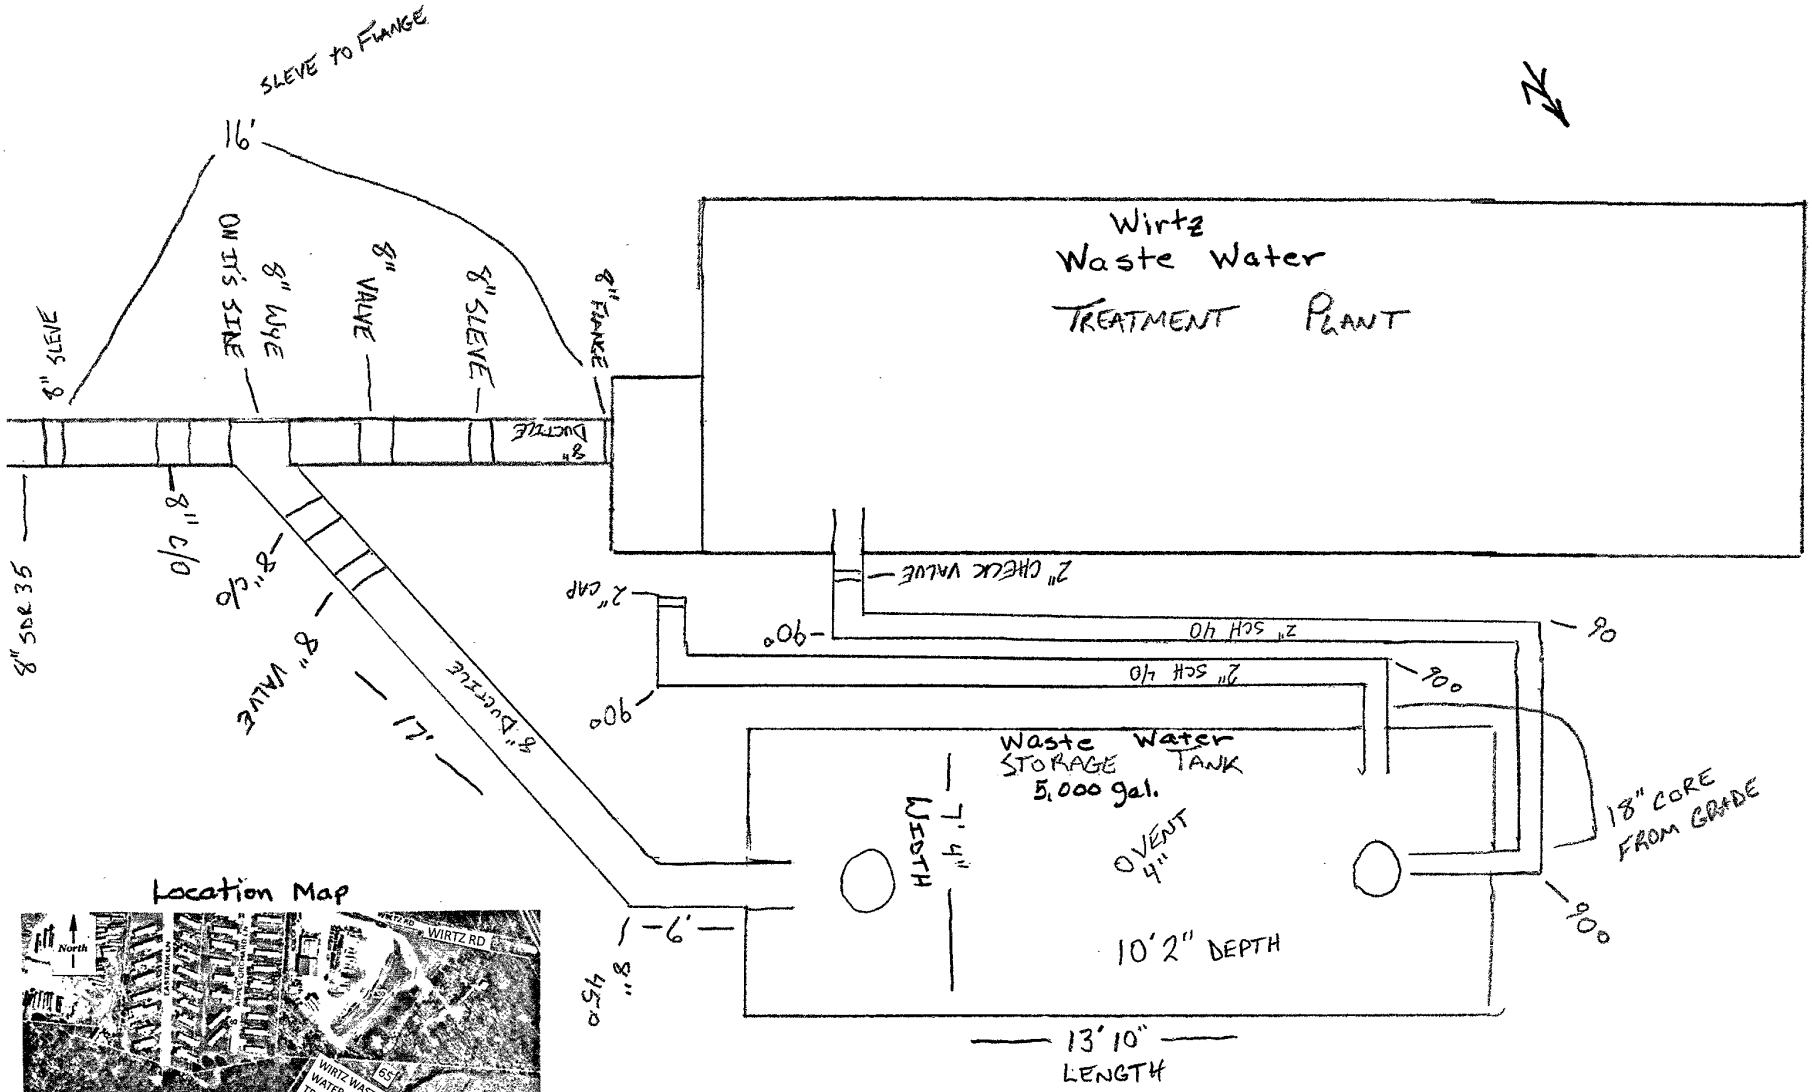

Location Map

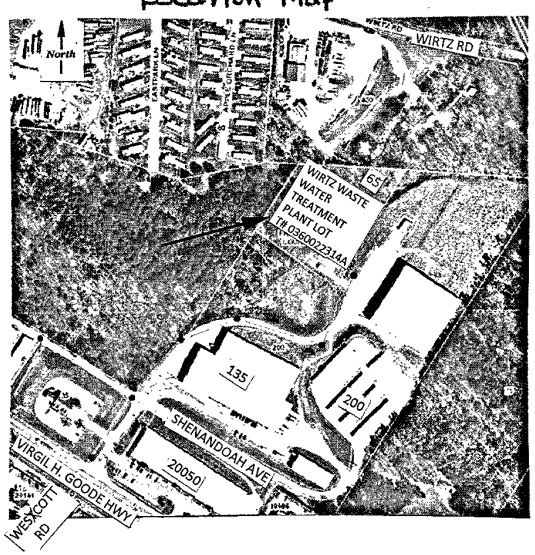

WIRTZ TANK 5,000 GAL
65 Shenandoah Ave.
Franklin County
INSTALL DATE: JUNE 22ND 2018

W.V.W.A. Field Operations Installed
CIP2 - TAFT BEASLEY