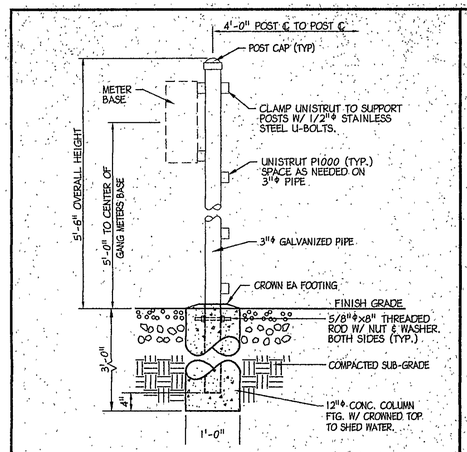

3 / S-3 ELECTRICAL & TELCO BACKBOARD
N.T.S.

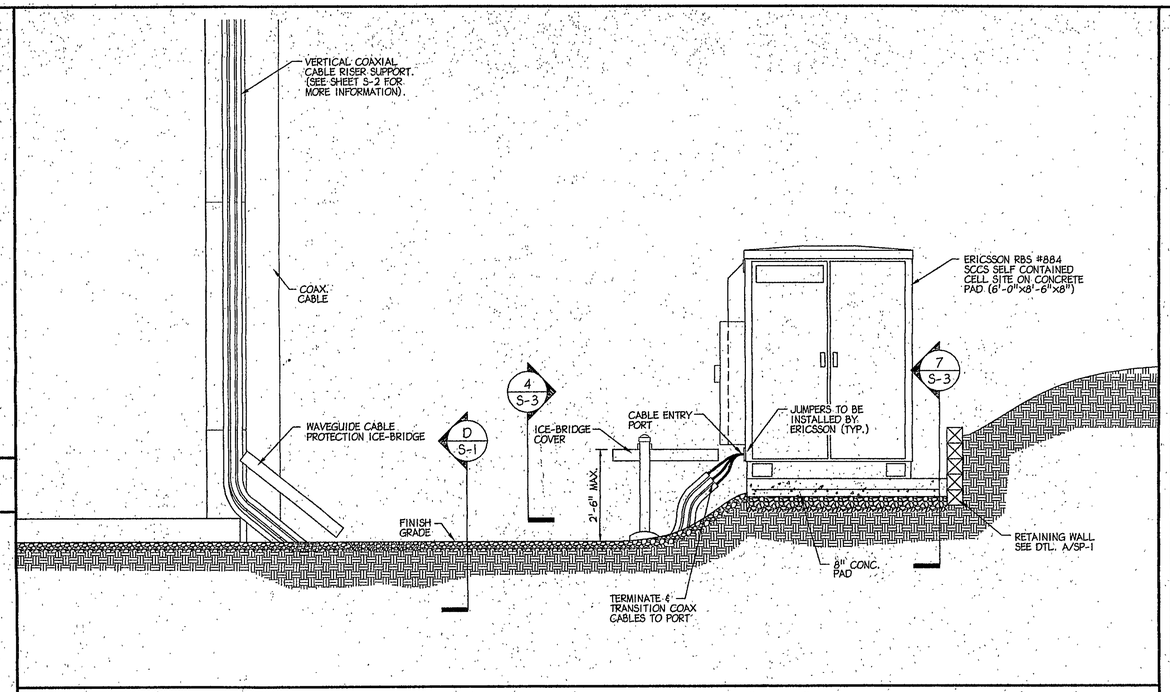

1 / S-3 COAXIAL CABLE ROUTING
N.T.S.

GENERAL NOTE:
INFORMATION SHOWN ON THIS SHEET IS FOR CONSTRUCTION & FABRICATION OF COMPONENTS AND NOT A VISUAL REPRESENTATION OF SITE CONDITIONS.

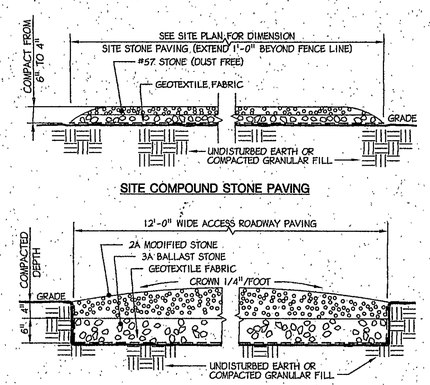

5 / S-3 STONE PAVING DETAILS
N.T.S.

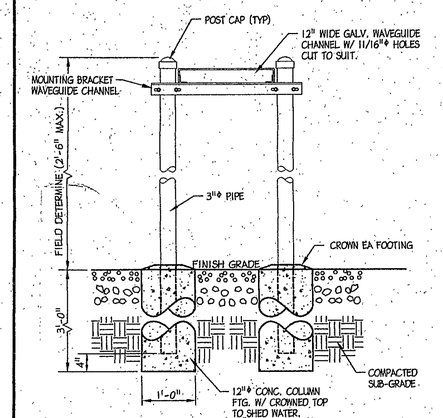

4 / S-3 ICE BRIDGE PROTECTION COVER
N.T.S.

POWER TELCO BACKBOARD SHALL BE LOCATED SO THAT THE READING OF THE METER SHALL GOVERN THE LOCATION FOR PLACEMENT ON THE SITE. ALLOW A MIN. OF 3'-0" CLEAR BETWEEN ANY ELEC./ TELCO EQUIPMENT BOXES AND ANY EXISTING OBSTRUCTION OR STRUCTURES.

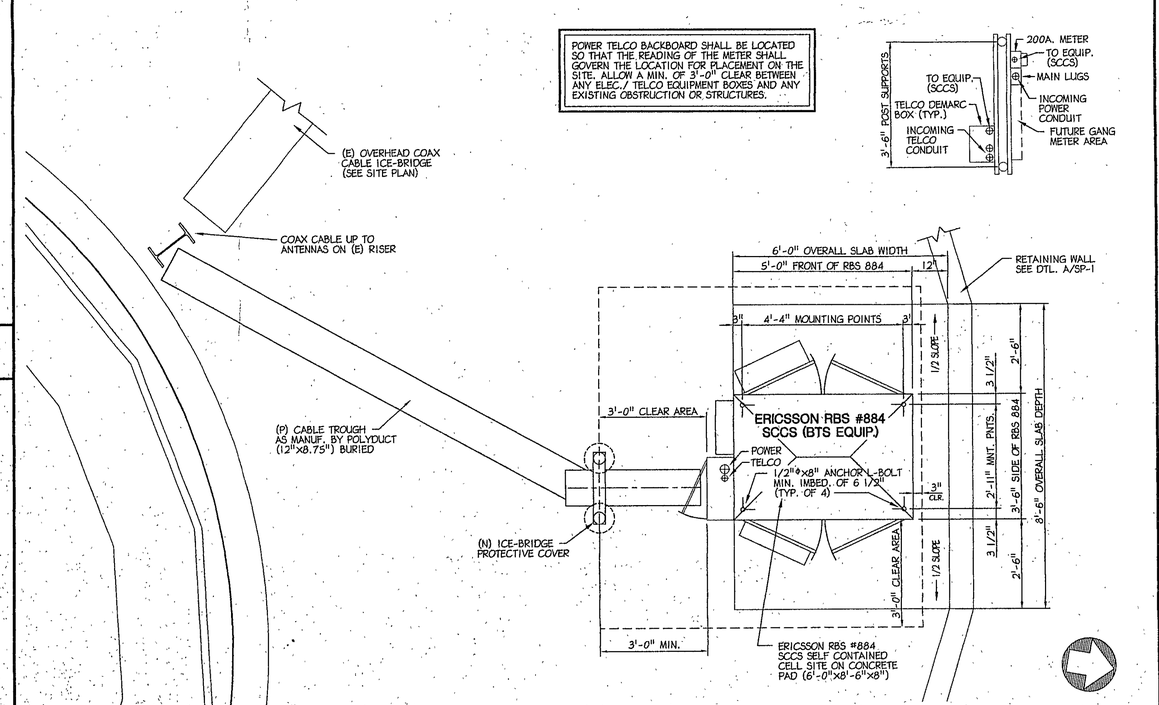

2 / S-3 EQUIPMENT LAYOUT ON CONC. SLAB
1/4" = 1'- 0"

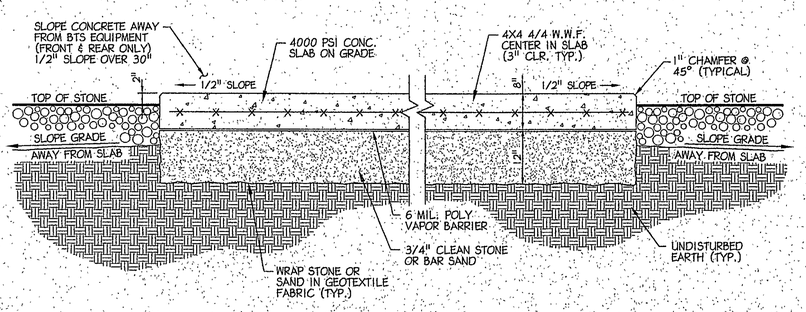

7 / S-3 CONCRETE SLAB DETAIL
N.T.S.

Betzwood Associates PC
ARCHITECTS & ENGINEERS
Robin J. Kohn AIA — Regis W. Kubit PE
301 Gay Street
Phoenixville PA 19460
Tel (610) 917-8831 Fax 917-8836

SEAL BLOCK

I CERTIFY THAT THESE DOCUMENTS WERE PREPARED OR APPROVED BY ME, AND THAT I AM A DULY LICENSED ARCHITECT UNDER THE LAWS OF THE STATE OF VIRGINIA.

COMMONWEALTH OF VIRGINIA — ROBIN J. KOHN — No. 010566 — ARCHITECT

ROBIN J. KOHN AIA – VA. #010566 12.31.98

TRITON PCS
Incorporated

9211 Aboretum Parkway, Suite 200
Richmond, Virginia 23236-3469
Tel. (804) 323-9500 FAX (804) 323-1560

APPROVALS

Triton PCS _____
LANDLORD _____
LEASING _____
R.F. _____
ZONING _____
CONSTRUCTION _____

PROJECT NO.	DRAWN BY	CHECK BY
TR-005	EMH	RJK

SUBMITTALS

NO.	DATE	ISSUE
0	06-05-97	TTV DATE
1	06-25-97	ISSUED FOR REVIEW (ZONING)
2	07-17-98	ISSUED FOR REVIEW (CONST.)
3	07-24-98	ISSUED FOR CONSTRUCTION
4	08-04-98	REISSUED FOR CONSTRUCTION
5	09-18-98	REVISED ANTENNA HEIGHT
6	10-08-98	FINAL CONSTRUCTION REVISIONS
7	10-23-98	OWNER REVISIONS
8	12-10-98	REVISED CHANGES
9	3-16-99	AS BUILT DESCRIPTION

GRAPHIC SCALE
0 1 2

PROJECT
HIGHWAY 220
RO-1-429-A
ROANOKE CITY PUBLIC WORKS
1423 SUMMIT LANE
ROANOKE, VA 24011
AS - BUILT COPY

SHEET TITLE
CONSTRUCTION DETAILS & SECTIONS

SHEET NUMBER
S-3

HIGHWAY 220 429-A
HIGHWAY 220 429-A
HIGHWAY 220 429-A
HIGHWAY 220 429-A