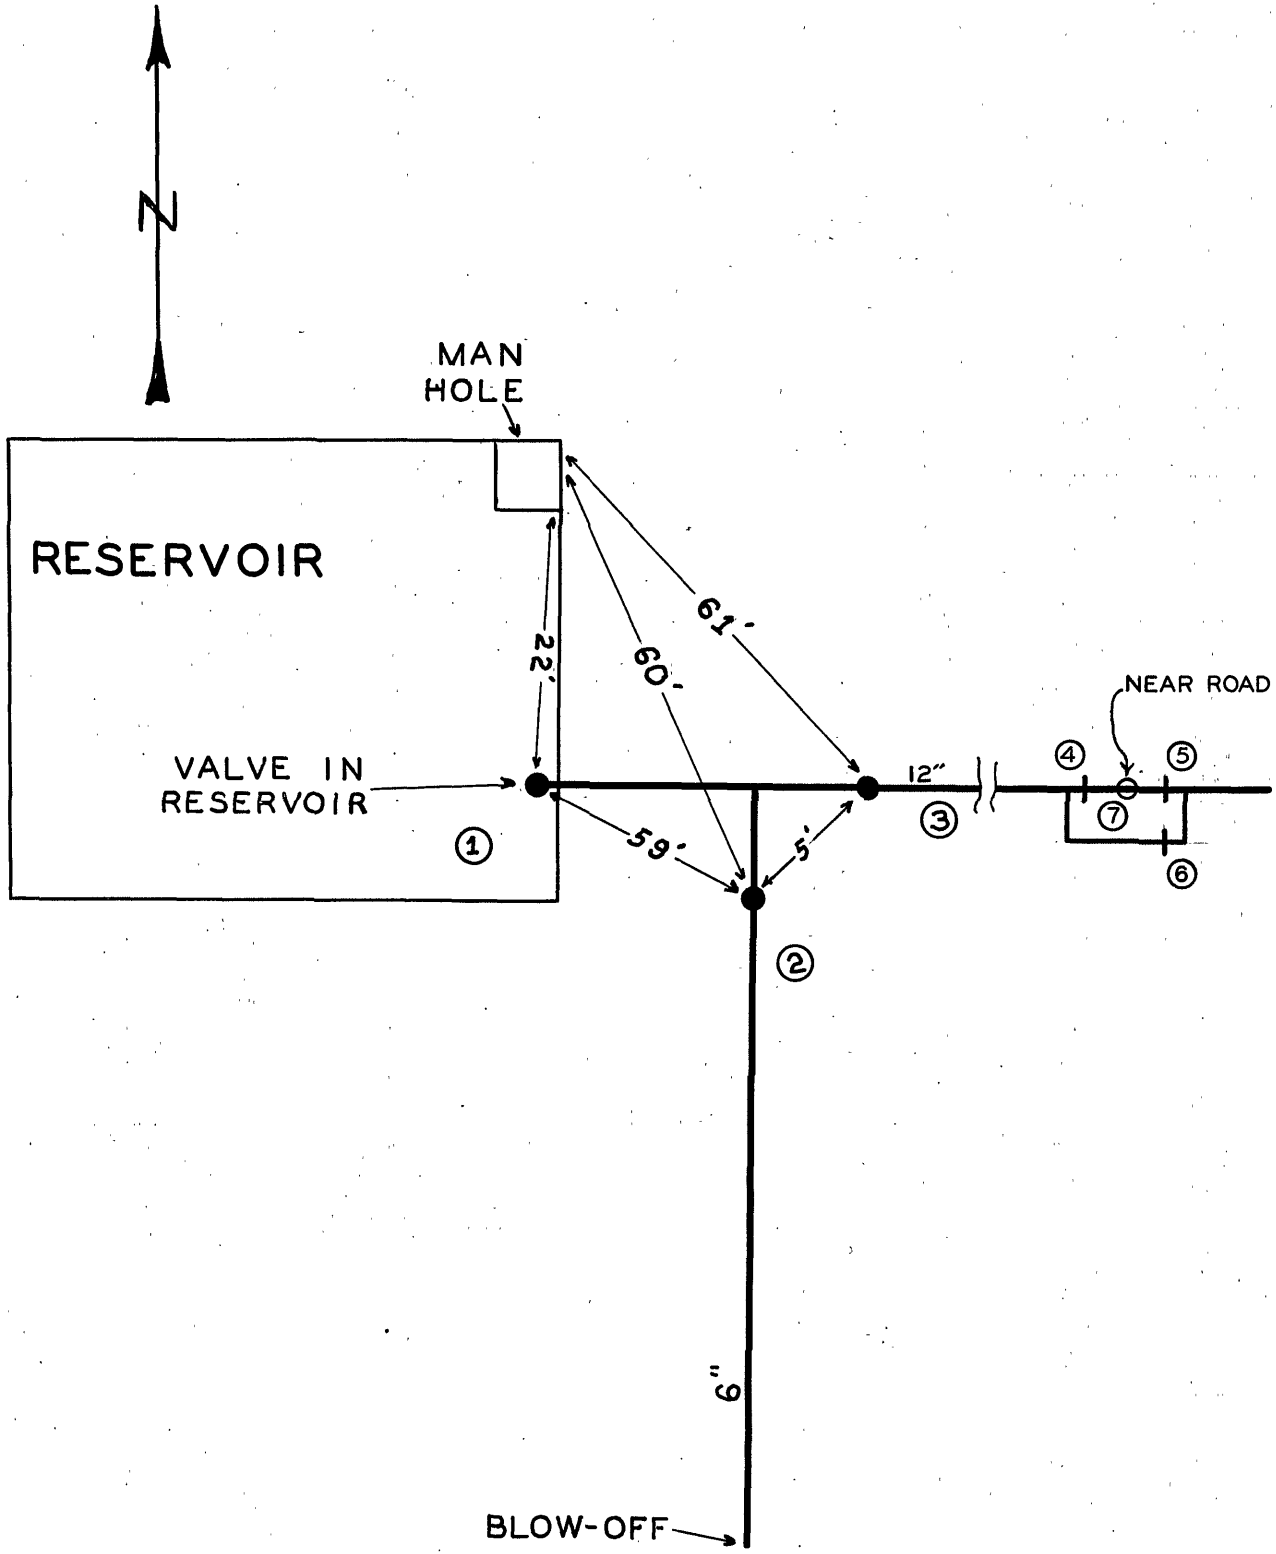

DATE	NO.	SIZE	MAKE	OPEN	TURNS
	1	12"		L	
	2	6"	MUELLER	R	20
	3	12"	MUELLER	R	38
	4	12"		R	
	5	12"		R	
	6	6"		R	
	7	12"	ALTITUDE	VALVE	

CITY OF ROANOKE — WATER DEPT.

VALVE DIAGRAM

GARDEN CITY RESERVOIR

S. E.

Yellow Mountain Rd

SEC. MAP

DATE PAGE NO.

"IMPERIAL" TRACING CLOTH K & E CO., N. Y.