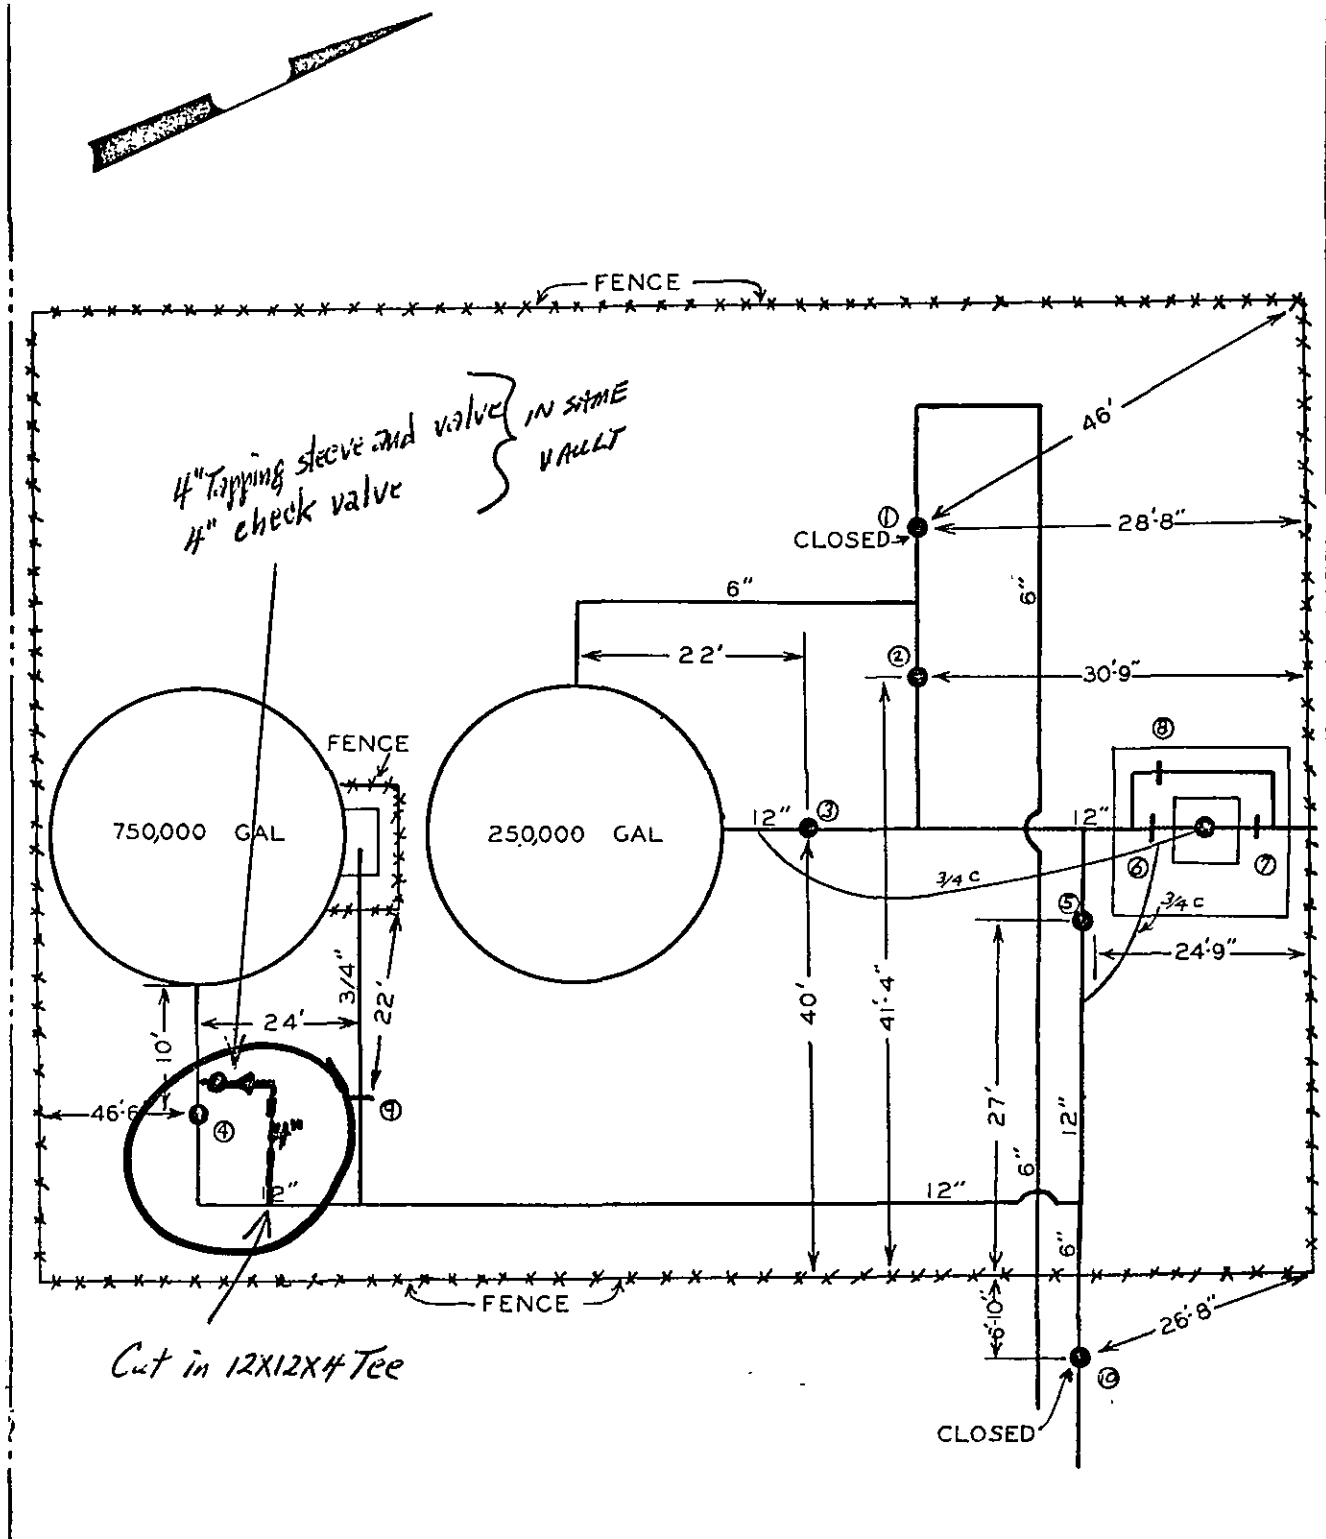

DATE	NO.	SIZE	MAKE	OPEN	TURNS
	1	6"		R	
	2	6"		R	
	3	12"		R	
	4	12"		R	
	5	12"		R	
	6	12"		R	
	7	12"		R	
	8	6"		R	
	9	3/4"	CURBCOCK		
	10	6"		R	

CITY OF ROANOKE – WATER DEPT.

VALVE DIAGRAM

GRANDIN COURT TANKS S.W.

SEC. MAP 157

DATE PAGE NO.